IREDELL COUNTY HEALTH DEPARTMENT

STATESVILLE 704-878-5305 MOORESVILLE 704-664-5281

IMPROVEMENT PERMIT / AUTHORIZATION TO CONSTRUCT / OPERATION PERMIT / EXISTING SYSTEM INSPECTION

PERMIT# Repair PIN# 4626663168 DATE 11/27/02

OWNER OR CONTRACTOR Howard Stewart PHONE: Business _____ Home _____

ADDRESS 263 McKendree Rd Mooresville NC 28117

LOCATION Brawley Sch, TR McKendree on Lt before Lions Club

SUBDIVISION _____ BLOCK / SECTION _____ LOT _____ LOT AREA _____ SITE CLASS. P5 DESIGN FLOW 360 L.T.A.R. _____

Septic Tank: Existing Gallons: STB _____ Date _____

Pump Tank: _____ Gallons; PT _____ Date _____

Pump Make: _____ Model _____ Serial No. _____

Nitrification Field: No Fields 1 Square Feet 900 Linear Feet 12x75' Bed

No Lines _____ Trench Width _____ Max Trench Bottom Depth 36" Gravel Depth 12"

(X) New System ( ) Repair System Type: I II III IV V VI

System Description: _____

Repair System Description: Conventional Bed

Maintenance Agreement Required: ☐ Yes (X) No

(X) House/Mod. Home No. Bedrooms 3

☐ Mobile Home No. Bathrooms 1

☐ Business No. Employees _____

☐ Other _____


☐ Slab (X) Crawl Space ☐ Basement w/plumbing ☐ Basement wo/plumbing

Water Supply: (X) Individual ☐ Public ☐ Community

Comments:/Conditions:

Comments:/Conditions:

INITIAL SITE SKETCH

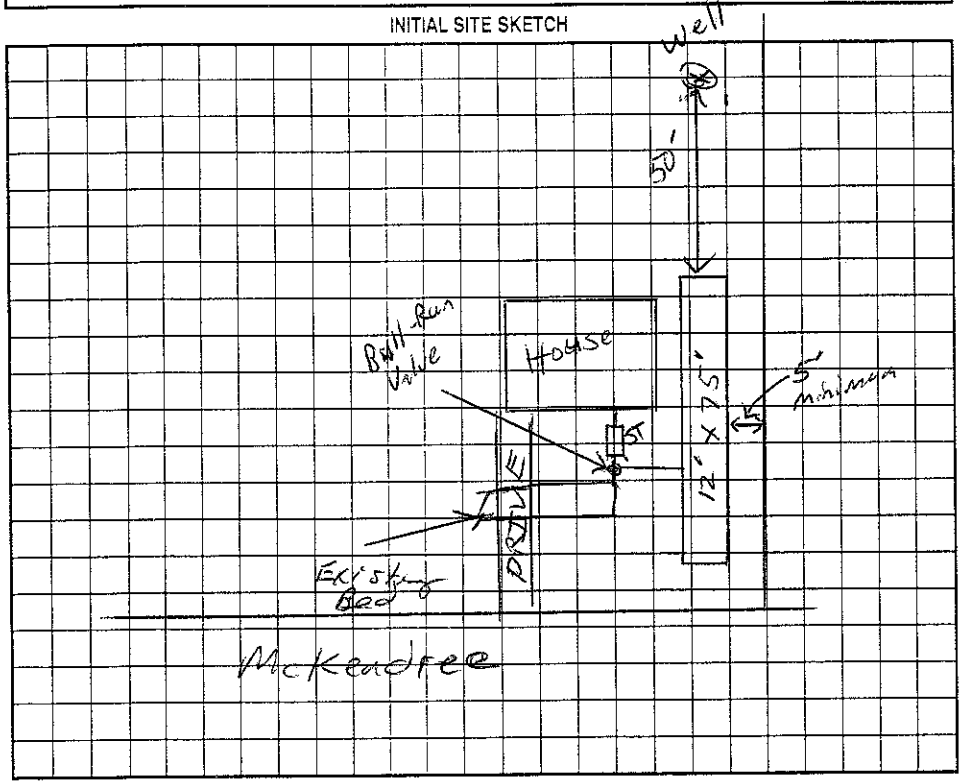

AS BUILT SKETCH

Permit can be suspended or revoked if any false information is supplied toward securing the permit/any unauthorized changes are made to the site/any unauthorized changes are made in the installation of the system. Improvement Permit with plat valid without expiration. Improvement Permit with site plan valid for sixty months. Authorization to Construct is valid for a period equal to that of Improvement Permit – not to exceed sixty months.

Signed: _____ date 11-27-02 Installed by: Abernathy

Improvement Permit by: _____ RS date 11/27/02 Operation Permit by: _____ RS date 12/9/02

Authorization to Construct by: _____ RS date 11/27/02 Existing System Inspection by: _____ date _____

HEALTH DEPT. COPY: WHITE OWNER COPY (FINAL): YELLOW OWNER COPY (INITIAL): PINK