IREDELL COUNTY HEALTH DEPARTMENT

STATESVILLE 704-878-5305 MOORESVILLE 704-664-5281

IMPROVEMENT PERMIT / AUTHORIZATION TO CONSTRUCT / OPERATION PERMIT / EXISTING SYSTEM INSPECTION

PERMIT# 13412S PIN# 4626663747 DATE 3/28/06

OWNER OR APPLICANT Richard Abernathy / Maie Ho Home PHONE: Business Joe 8814573 Home

ADDRESS 1397 Brawley School Rd Mooresville NC 28117

LOCATION BSR, TR McKendree, TR Haggerty, on RT Linton Farms

SUBDIVISION Brookridge Shores BLOCK / SECTION 6 LOT 7 LOT AREA 0.45AC SITE CLASS. PS DESIGN FLOW 360 L.T.A.R. 0.3

Septic Tank: 1000 Gallons; STB 312 Date 8-13-01
Pump Tank: 1000 Gallons; PT 27 Date 4-22-07
Pump Make: Goulds Model PE5IM Serial No.
Nitrification Field: No Fields 1 Square Feet 420 Linear Feet 210
No Lines 3 Trench Width 24" Max Trench Bottom Depth 36" Gravel Depth —

☒ New System ☐ Repair ☐ Expansion System Type: I II III (IV) V VI
System Description: LP Panel Block
Repair System Description: Same
Maintenance Agreement Required: ☒ Yes ☐ No

☒ House/Mod. Home No. Bedrooms 3
☐ Mobile Home No. Persons
☐ Business No. Employees
☐ Other


Water Supply: ☒ Individual ☐ Public ☐ Community

☐ Gravity ☒ Pressure ☐ Slab ☒ Crawl Space ☐ Basement w/plumbing ☐ Basement wo/plumbing

Comments:/Conditions: 48 panels 5/32" hole drilled


1"=40'

INITIAL SITE SKETCH

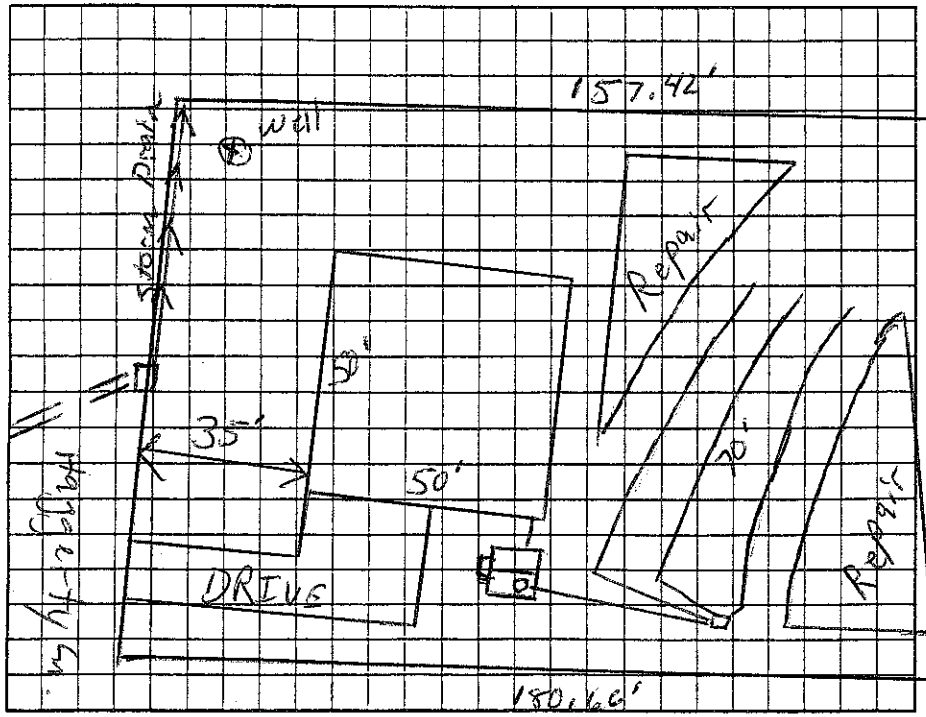

Comments:/Conditions: 9/18/07 Checked tanks & lines
New House Size = 60' wide x 55' deep
Plans approved 2/28/07 JA
3/5/08 2Ft pressure set

AS BUILT SKETCH

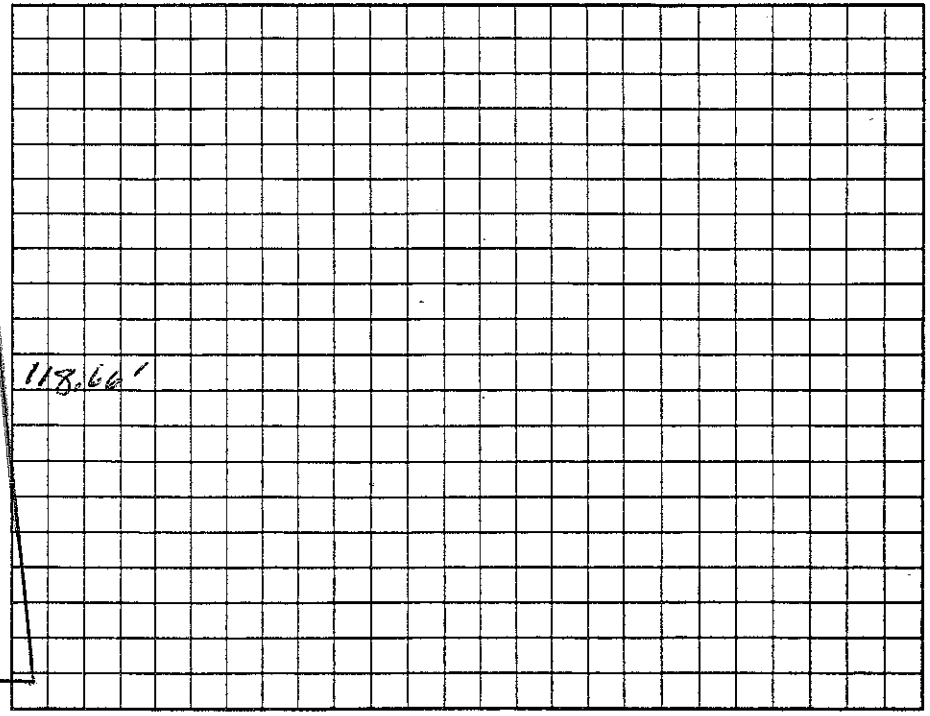

Permit can be suspended or revoked if any false information is supplied toward securing the permit/any unauthorized changes are made to the site/any unauthorized changes are made in the installation of the system. Improvement Permit with plan valid without expiration. ☐ Improvement Permit with site plan valid for sixty months ☒ Authorization to Construct is valid for a period equal to that of Improvement Permit - not to exceed sixty months.

Signed: Robyn B. Abernathy date 04-18-06

Improvement Permit by: RS date 3/28/06

Authorization to Construct by: Jph & Alfd date 2/28/07

Installed by: Richard Abernathy

Operation Permit by: Maie Ho Johnson RS date 3/14/08

Existing System Inspection by: date

HEALTH DEPT. COPY: WHITE OWNER COPY (FINAL): YELLOW OWNER COPY (INITIAL): PINK