# IREDELL COUNTY HEALTH DEPARTMENT

STATESVILLE 704-878-5305 MOORESVILLE 704-664-5281

## IMPROVEMENT PERMIT / AUTHORIZATION TO CONSTRUCT / OPERATION PERMIT / EXISTING SYSTEM INSPECTION

PERMIT# 134127 PIN# 4676.66.4838 DATE 3/28/06

OWNER OR APPLICANT Richard Abernathy/Maiello PHONE: Business Home

ADDRESS 1397 Brawley School Rd Mooresville NC 28117

LOCATION BSR, TR McAndrew, TR Haggerty, at end on Rt Fulton Farms Ln.

SUBDIVISION Brookridge Shores BLOCK / SECTION 6 LOT 6 LOT AREA 0.48 AC SITE CLASS P3 DESIGN FLOW 360 L.T.A.R. 0.3

Septic Tank: 1000 Gallons: STB 794 Date 9-24-07

Pump Tank: 1000 Gallons: PT 27 Date 1-22-08

Pump Make: Gould's Model PE5IM Serial No.

Nitrification Field: No Fields 1 Square Feet 400 Linear Feet 200

No Lines 4 5 Trench Width 24" Max Trench Bottom Depth 36"

☒ New System ☐ Repair ☐ Expansion System Type: I II III (IV) V VI

System Description: LP Panel Block

Repair System Description: Same

Maintenance Agreement Required: ☒ Yes ☐ No

☒ House/Mod. Home ☐ Mobile Home ☐ Business ☐ Other

No. Bedrooms 3 No. Persons No. Employees

Water Supply: ☒ Individual ☐ Public ☐ Community


Gravel Depth ☐ Gravity ☒ Pressure ☐ Slab ☐ Crawl Space ☒ Basement w/plumbing ☐ Basement wo/plumbing

Comments:/Conditions: 4/23/08 Checked tanks for pressure


1"=40'

Comments:/Conditions: 4/23/08 Tanks 9/21/08 Elect & alarm checked

INITIAL SITE SKETCH

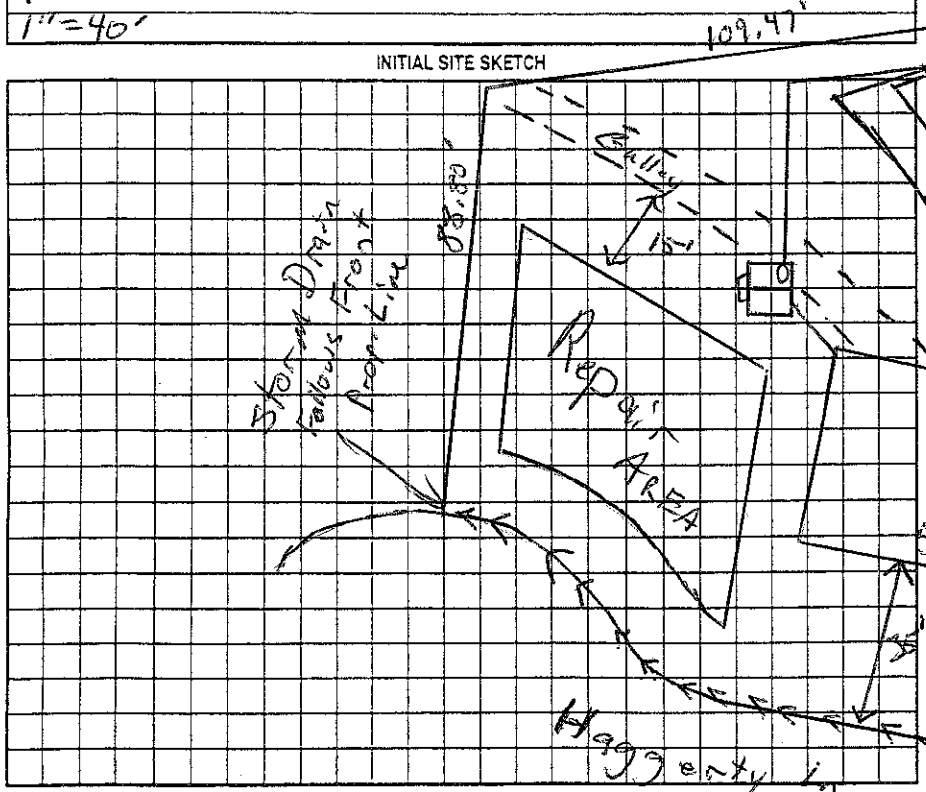


AS BUILT SKETCH

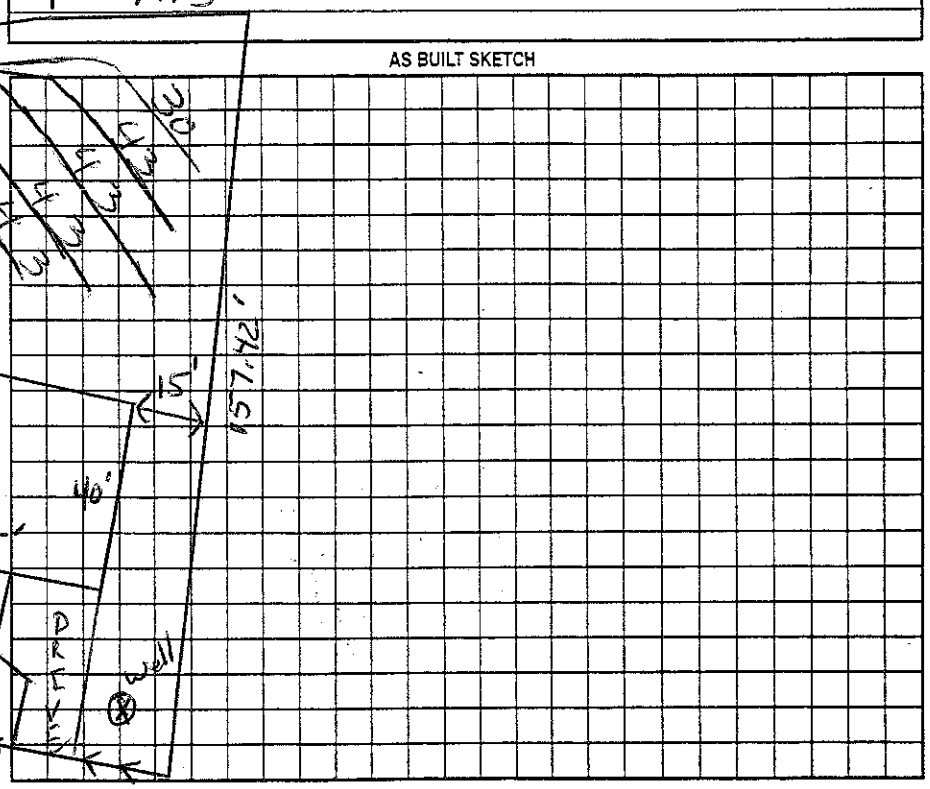


Permit can be suspended or revoked if any false information is supplied toward securing the permit/any unauthorized changes are made to the site/any unauthorized changes are made in the installation of the system. Improvement Permit with plat valid without expiration ☐ Improvement Permit with site plan valid for sixty months ☒ Authorization to Construct is valid for a period equal to that of Improvement Permit – not to exceed sixty months.

Signed: Robyn B. Abernath date 04-18-06

Improvement Permit by: date 3/28/06

Authorization to Construct by: date 3/13/07

Installed by: Richard Abernathy

Operation Permit by: date 9/26/08

Existing System Inspection by: date

HEALTH DEPT. COPY: WHITE OWNER COPY (FINAL): YELLOW OWNER COPY (INITIAL): PINK