2:30

IREDELL COUNTY HEALTH DEPARTMENT

STATESVILLE 704-878-5305 MOORESVILLE 704-664-5281

IMPROVEMENT PERMIT / AUTHORIZATION TO CONSTRUCT / OPERATION PERMIT / EXISTING SYSTEM INSPECTION

PERMIT # N/A PIN # 4626666739 DATE 5-3-2010

OWNER or APPLICANT Bryan Godfelter/Jonathan Beam PHONE Business 704634-2500 Home: 704663-4041

OWNER or APPLICANT ADDRESS 1824 Triplett Rd Mooresville, NC

LOCATION / DIRECTIONS Brawley School Rd TR McKendree TR Brookridge near end on left

SUBDIVISION Brookridge Shores BLOCK / SECTION LOT # 3 LOT AREA DESIGN FLOW 360gpd L.T.A.R.

Septic Tank 1000 Gallons: STB Date 3-11-10
Pump Tank Gallons: PT Date
Pump Make Model Serial #
Nitrification Field No Fields Existing No Lines Linear Feet N240-300
Trench Width Max. Trench Bottom Depth Gravel Depth

☐ New System ☒ Repair ☐ Expansion System Type I II III IV V VI
System Description: Gravity – Mod Conv.
Repair System Description:
Maintenance Agreement Required ☐ YES ☒ NO
☒ GRAVITY ☐ PRESSURE


☒ Residence No. Bedrooms 3
☐ Business No. Persons
☐ Other No. Employees
☐ Slab ☐ Crawl Space
☐ Basement w/plumbing ☐ Basement w/o plumbing

Water Supply ☒ Private ☐ Public ☐ Community

Comments / Conditions: Replace existing ST with new ST Must stay at least 5ft From house (including deck).

Comments / Conditions: Left from deck to ST 8ft from House to ST (Behind AC unit)

INITIAL SITE SKETCH

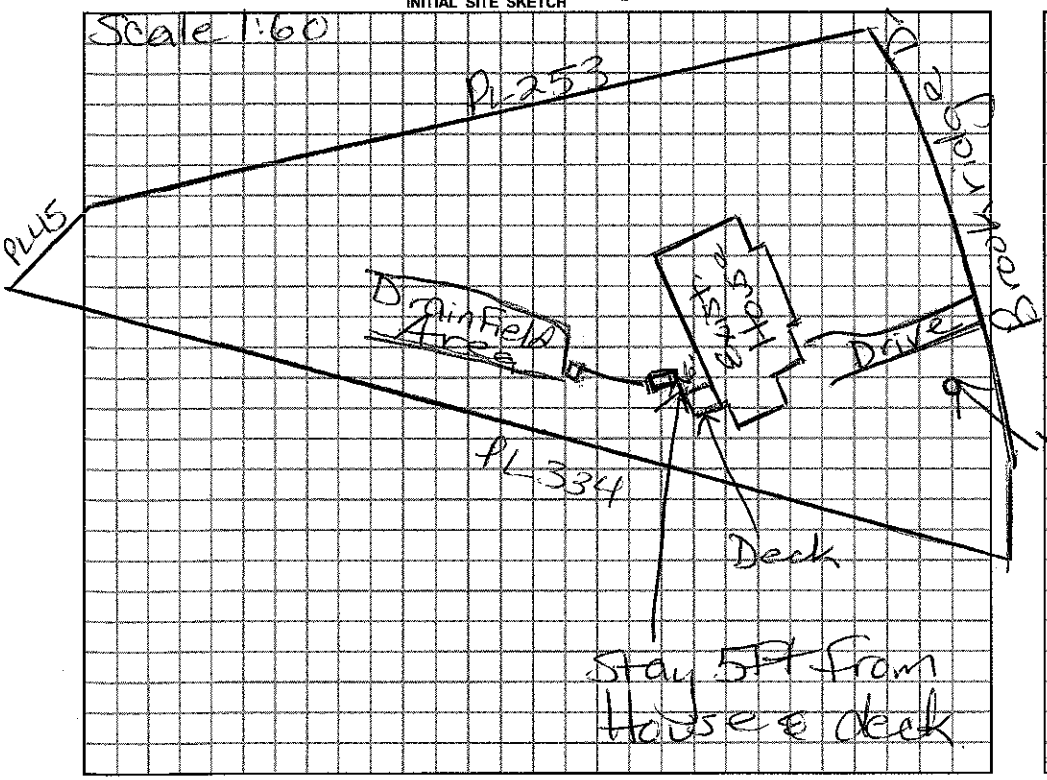

AS BUILT SKETCH

Installed as Shown

Permit can be suspended or revoked if any false information is supplied toward securing the permit / any unauthorized changes are made to the site / any unauthorized changes are made in the installation of the system.

☐ *IMPROVEMENT PERMIT w / plat valid without expiration* ☐ *IMPROVEMENT PERMIT w / site plan valid for 60 mos.* ☐ *AUTHORIZATION TO CONSTRUCT valid for period equal to IMPROVEMENT PERMIT-not to exce*

Owner / Applicant Signature: Bryan Godfelter Date 5/4/2010 Installed by: Wayne Wentz RHS

Improvement Permit by: Marian H. Dotson RS Date 5/3/2010 Operation Permit by: Marian H. Dotson Date: 5/3/2010

Authorization to Construct by: Marian H. Dotson RS Date 5/3/2010 Existing System Inspected by: Date:

YOU SHOULD CONTACT A LOCATOR SERVICE PRIOR TO ANY EXCAVATION.

WHITE COPY Environmental Health YELLOW COPY (Final) Owner / Applicant PINK COPY (Initial) Ow