IREDELL COUNTY HEALTH DEPARTMENT

STATESVILLE 704-873-5305 MOORESVILLE 704-664-5281

IMPROVEMENT PERMIT / AUTHORIZATION TO CONSTRUCT / OPERATION PERMIT / EXISTING SYSTEM INSPECTION

19.00

PERMIT# 117048 PIN# 4626-76-4461 (66-831) DATE 12/31/03

OWNER OR CONTRACTOR Michelle Cook PHONE: Business Home 704 658-0412

ADDRESS 204 Green Bay Rd Mooresville NC 28117

LOCATION B&R, TR McKendree, on RT Before Brook Ridge Dr.

SUBDIVISION Brookridge Shores BLOCK / SECTION LOT 8 LOT AREA .845 AC SITE CLASS PS DESIGN FLOW 360 L.T.A.R. 0.3

Septic Tank: 1500 Gallons; STB 1007 Date 2/27/04

Pump Tank: Gallons; PT Date

Pump Make: Model Serial No.

Nitrification Field: No Fields 1 Square Feet 1200 Linear Feet 400

No Lines 5 Trench Width 36" Max Trench Bottom Depth 36" Gravel Depth 12"

☒ New System ☐ Repair System Type: I, II, III, IV, V, VI

System Description: Gravity Conventional

Repair System Description: LP Panel Block

Maintenance Agreement Required: ☐ Yes ☒ No

☒ House/Mod. Home ☐ Mobile Home ☐ Business ☐ Other

No. Bedrooms 3 No. Bathrooms 2 No. Employees


Water Supply: ☒ Individual ☐ Public ☐ Community

☐ Slab ☒ Crawl Space ☐ Basement w/plumbing ☐ Basement wo/plumbing

Comments:/Conditions:

Comments:/Conditions:

INITIAL SITE SKETCH

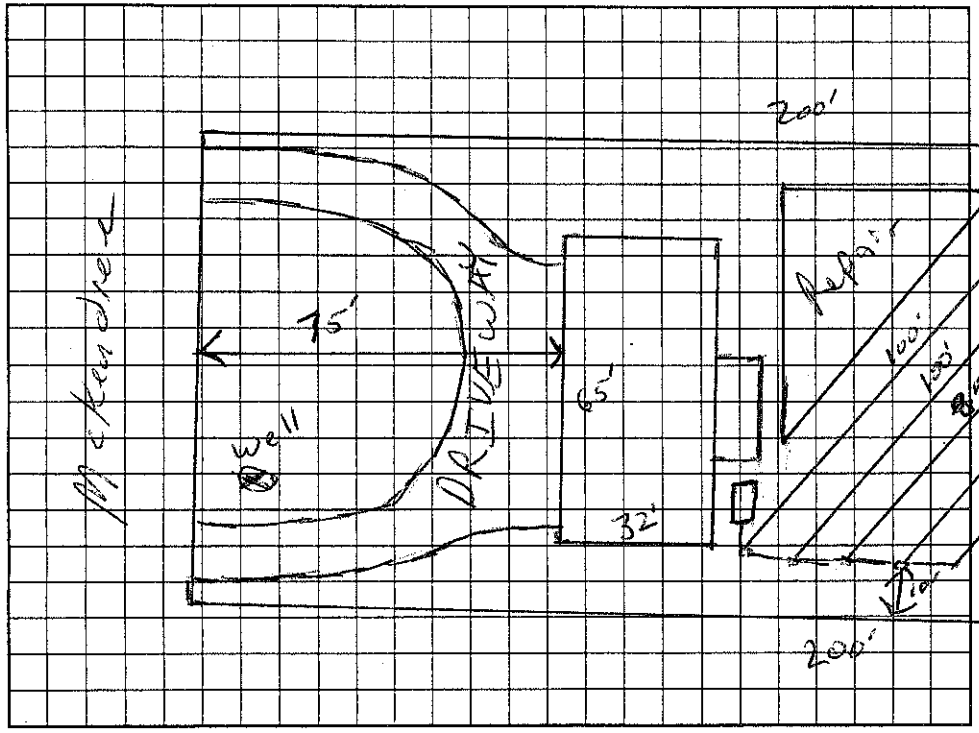

AS BUILT SKETCH

Permit can be suspended or revoked if any false information is supplied toward securing the permit/any unauthorized changes are made to the site/any unauthorized changes are made in the installation of the system. Improvement Permit with plat valid without expiration. Improvement Permit with site plan valid for sixty months. Authorization to Construct is valid for a period equal to that of Improvement Permit – not to exceed sixty months.

Signed: Michelle Cook date 1-5-04 Installed by: K + M Grading

Improvement Permit by: RS date 12/5/03 Operation Permit by: date 4/23/04

Authorization to Construct by: RS date 12/31/03 Existing System Inspection by: date

HEALTH DEPT. COPY: WHITE OWNER COPY (FINAL): YELLOW OWNER COPY (INITIAL): PINK