IREDELL COUNTY HEALTH DEPARTMENT

Statesville Office (704) 878-5305 Mooresville Office (704) 660-3625 PERMIT # 180142

IMPROVEMENT PERMIT / AUTHORIZATION TO CONSTRUCT / OPERATION PERMIT / EXISTING SYSTEM

PIN # 4626-66-8521

APPLICANT: BENJAMIN JOHNSON APPLICANT ADDRESS: 116 BROOKRIDGE LN.

SITE ADDRESS: 116 BROOKE RIDGE LN. PHONE: 704-453-6740 ALT. PHONE:

SITE DIRECTIONS: BSR, TR MCKENDREE, TR BROOK RIDGE, 2ND ON R

SUBDIVISION: BROOK RIDGE SHORES SECTION: 3 LOT # 2 LOT AREA: .77 AC DESIGN FLOW: L.T.A.R.:


Septic Tank	(gal)	STB	Date	☐ New System	☐ Repair	☐ Expansion	System Type: I (II) III IV V VI	☐ Residence	No. Bedrooms
Pump Tank	(gal)	PT	Date	System Description:	GRAVEL			☐ Business	No. Persons
Pump Make		Model EXISTING	Serial #	Repair System Description:				☒ Other	No. Employees
# Nitrification Fields		# Lines	Linear Ft:	Maintenance Agreement Required:		☐ YES	☒ NO	☐ Slab	☒ Crawl Space
Trench Width		Max. Trench Bottom Depth		Gravel Depth		☒ GRAVITY	☐ PRESSURE	☐ Basement w/plumbing	☐ Basement w/o plumbing

Water Supply: ☒ Private ☐ Public ☐ Community


Comments / Conditions:

GARAGE

INITIAL SITE SKETCH

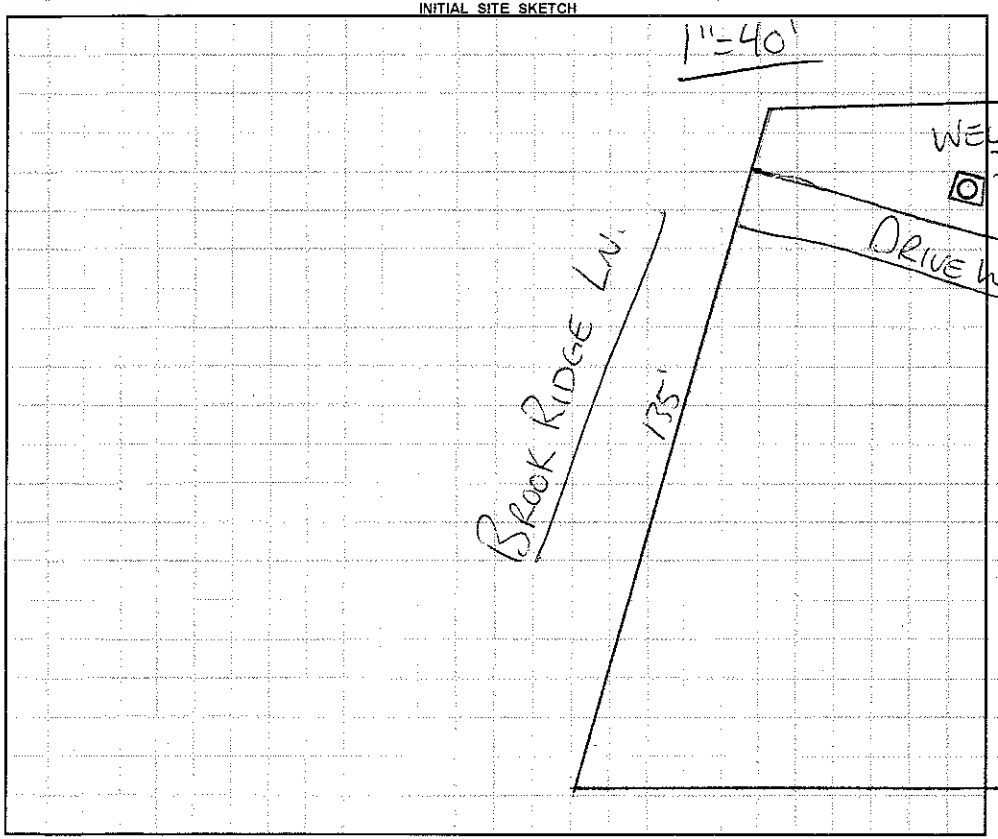

AS BUILT SKETCH

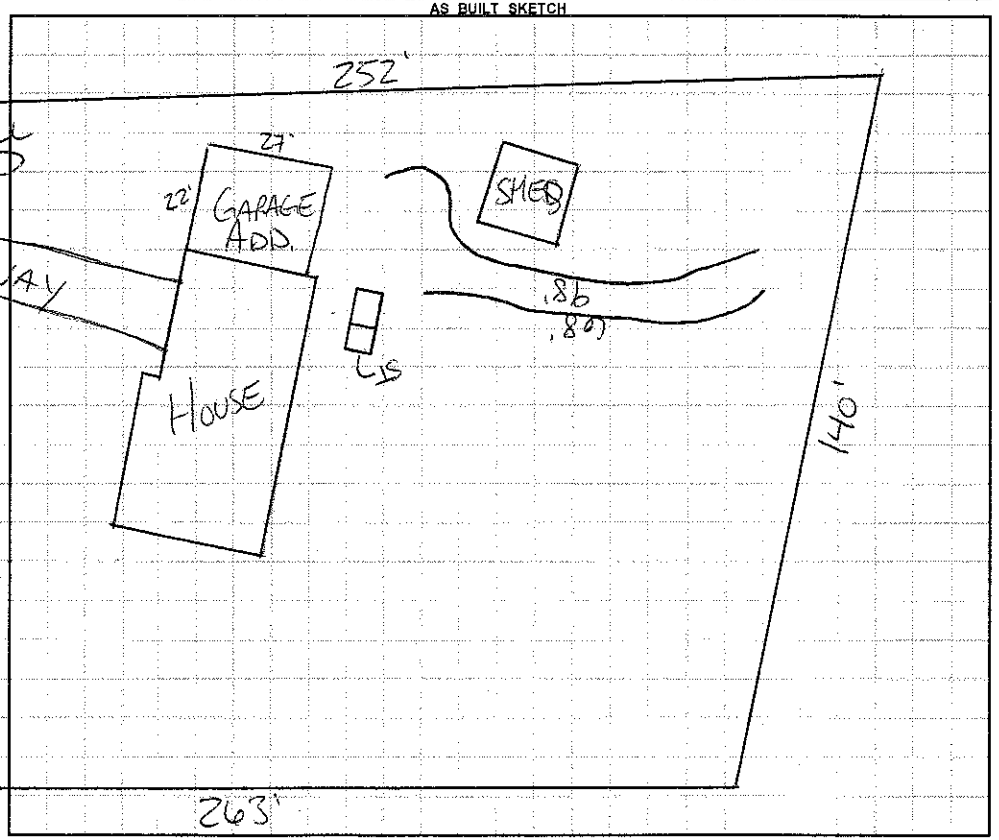

Permit can be suspended or revoked if any false information is supplied toward securing the permit / any unauthorized changes are made to the site / any unauthorized changes are made in the installation of the system. **CONTACT A LOCATOR SERVICE PRIOR TO ANY EXCAVATION**

☐ **IMPROVEMENT PERMIT** ***with plat*** *valid without expiration.* ☐ **IMPROVEMENT PERMIT** ***with site plan*** *valid for 60 mos.* ☐ **AUTHORIZATION TO CONSTRUCT** *valid for period equal to IMPROVEMENT PERMIT--not to exceed 60 mo.*

Owner / Applicant Signature: [signature] Date: 9-20-13 Installed by:

IMPROVEMENT PERMIT by: Date: OPERATION PERMIT by: Date:

AUTHORIZATION TO CONSTRUCT by: Date: Existing System Inspected by: [signature] Date: 9-17-13

Health Dept. Copy - WHITE Applicant (Final Approval) - YELLOW Applicant (Conditional Approval) - PINK