IREDELL COUNTY HEALTH DEPARTMENT

Statesville Office (704) 878-5305 | Mooresville Office (704) 660-3625

PERMIT # 217984

IMPROVEMENT PERMIT / AUTHORIZATION TO CONSTRUCT / OPERATION PERMIT / EXISTING SYSTEM

PIN # 4626-67-0183

APPLICANT: IQ Custom Construction | APPLICANT ADDRESS: 840 Edmiston Rd. Mt. Ulla 28125

SITE ADDRESS: 116 Millhouse Rd. Mooresville, NC 28117 | PHONE: 704-578-4951 | ALT. PHONE:

SITE DIRECTIONS: BSR towards Lake Norman → Right on McKendree Rd → Right on Millhouse Rd → 3rd lot on Right

SUBDIVISION: Meadows Field | SECTION: — | LOT # 3 | LOT AREA: 0.9 acres | DESIGN FLOW: 480 gal/day | L.T.A.R.: 0.30

Septic Tank 1000 (gal)	STB	Date	☒ New System ☐ Repair ☐ Expansion System Type: I II (III) IV V VI	☒ Residence	No. Bedrooms 4	Water Supply
Pump Tank — (gal)	PT —	Date —	System Description: 25% Reduction - Serial Distribution	☐ Business	No. Persons 8	☒ Private
Pump Make —	Model —	Serial # —	Repair System Description: 50% Reduction - LP-PPBPS	☐ Other	No. Employees	☐ Public
# Nitrification Fields 1	# Lines 4	Linear Ft: 400	Maintenance Agreement Required: ☐ YES ☒ NO	☐ Slab	☒ Crawl Space	☐ Community
Trench Width 36"	Max. Trench Bottom Depth 24"	Gravel Depth —	☒ GRAVITY ☐ PRESSURE	☐ Basement w/plumbing	☐ Basement w/o plumbing	

Comments / Conditions: Follow all N.C. septic rules. Proof of lot subdivision must be provided to the health department prior to AC issuance. + lot dimensions must exactly match the dimensions within the corresponding attached documentation. Recommend pumping septic tank every 3-5 years and keeping vegetation (non-grass) cut back 10 feet from sewage system. Existing house on property to be demolished along with any corresponding septic tanks (after being pumped).

INITIAL SITE SKETCH

See attached plans from The Oaks Group Dated 3-22-16 Kathleen Saunders LSS# 1313

AS BUILT SKETCH

INSTALLED AS SHOWN 9-8-16

Permit can be suspended or revoked if any false information is supplied toward securing the permit / any unauthorized changes are made to the site / any unauthorized changes are made in the installation of the system. **CONTACT A LOCATOR SERVICE PRIOR TO ANY EXCAVATION**

☐ **IMPROVEMENT PERMIT** *with plat valid without expiration.* ☒ **IMPROVEMENT PERMIT** *with site plan valid for 60 mos.* ☒ **AUTHORIZATION TO CONSTRUCT** *valid for period equal to IMPROVEMENT PERMIT--not to exceed 60 mo.*

Owner / Applicant Signature: Erma Delt Date: 4/27/16 Installed by: Rowan


IMPROVEMENT PERMIT by: Tom Shuck Date: 4-26-16 OPERATION PERMIT by: Date: 9-8-16

AUTHORIZATION TO CONSTRUCT by: Tom Shuck Date: 5-17-16 Existing System Inspected by: Date:

Health Dept. Copy - WHITE Applicant (Final Approval) - YELLOW Applicant (Conditional Approval) - PINK

MILLHOUS

Scale 1" = 40'

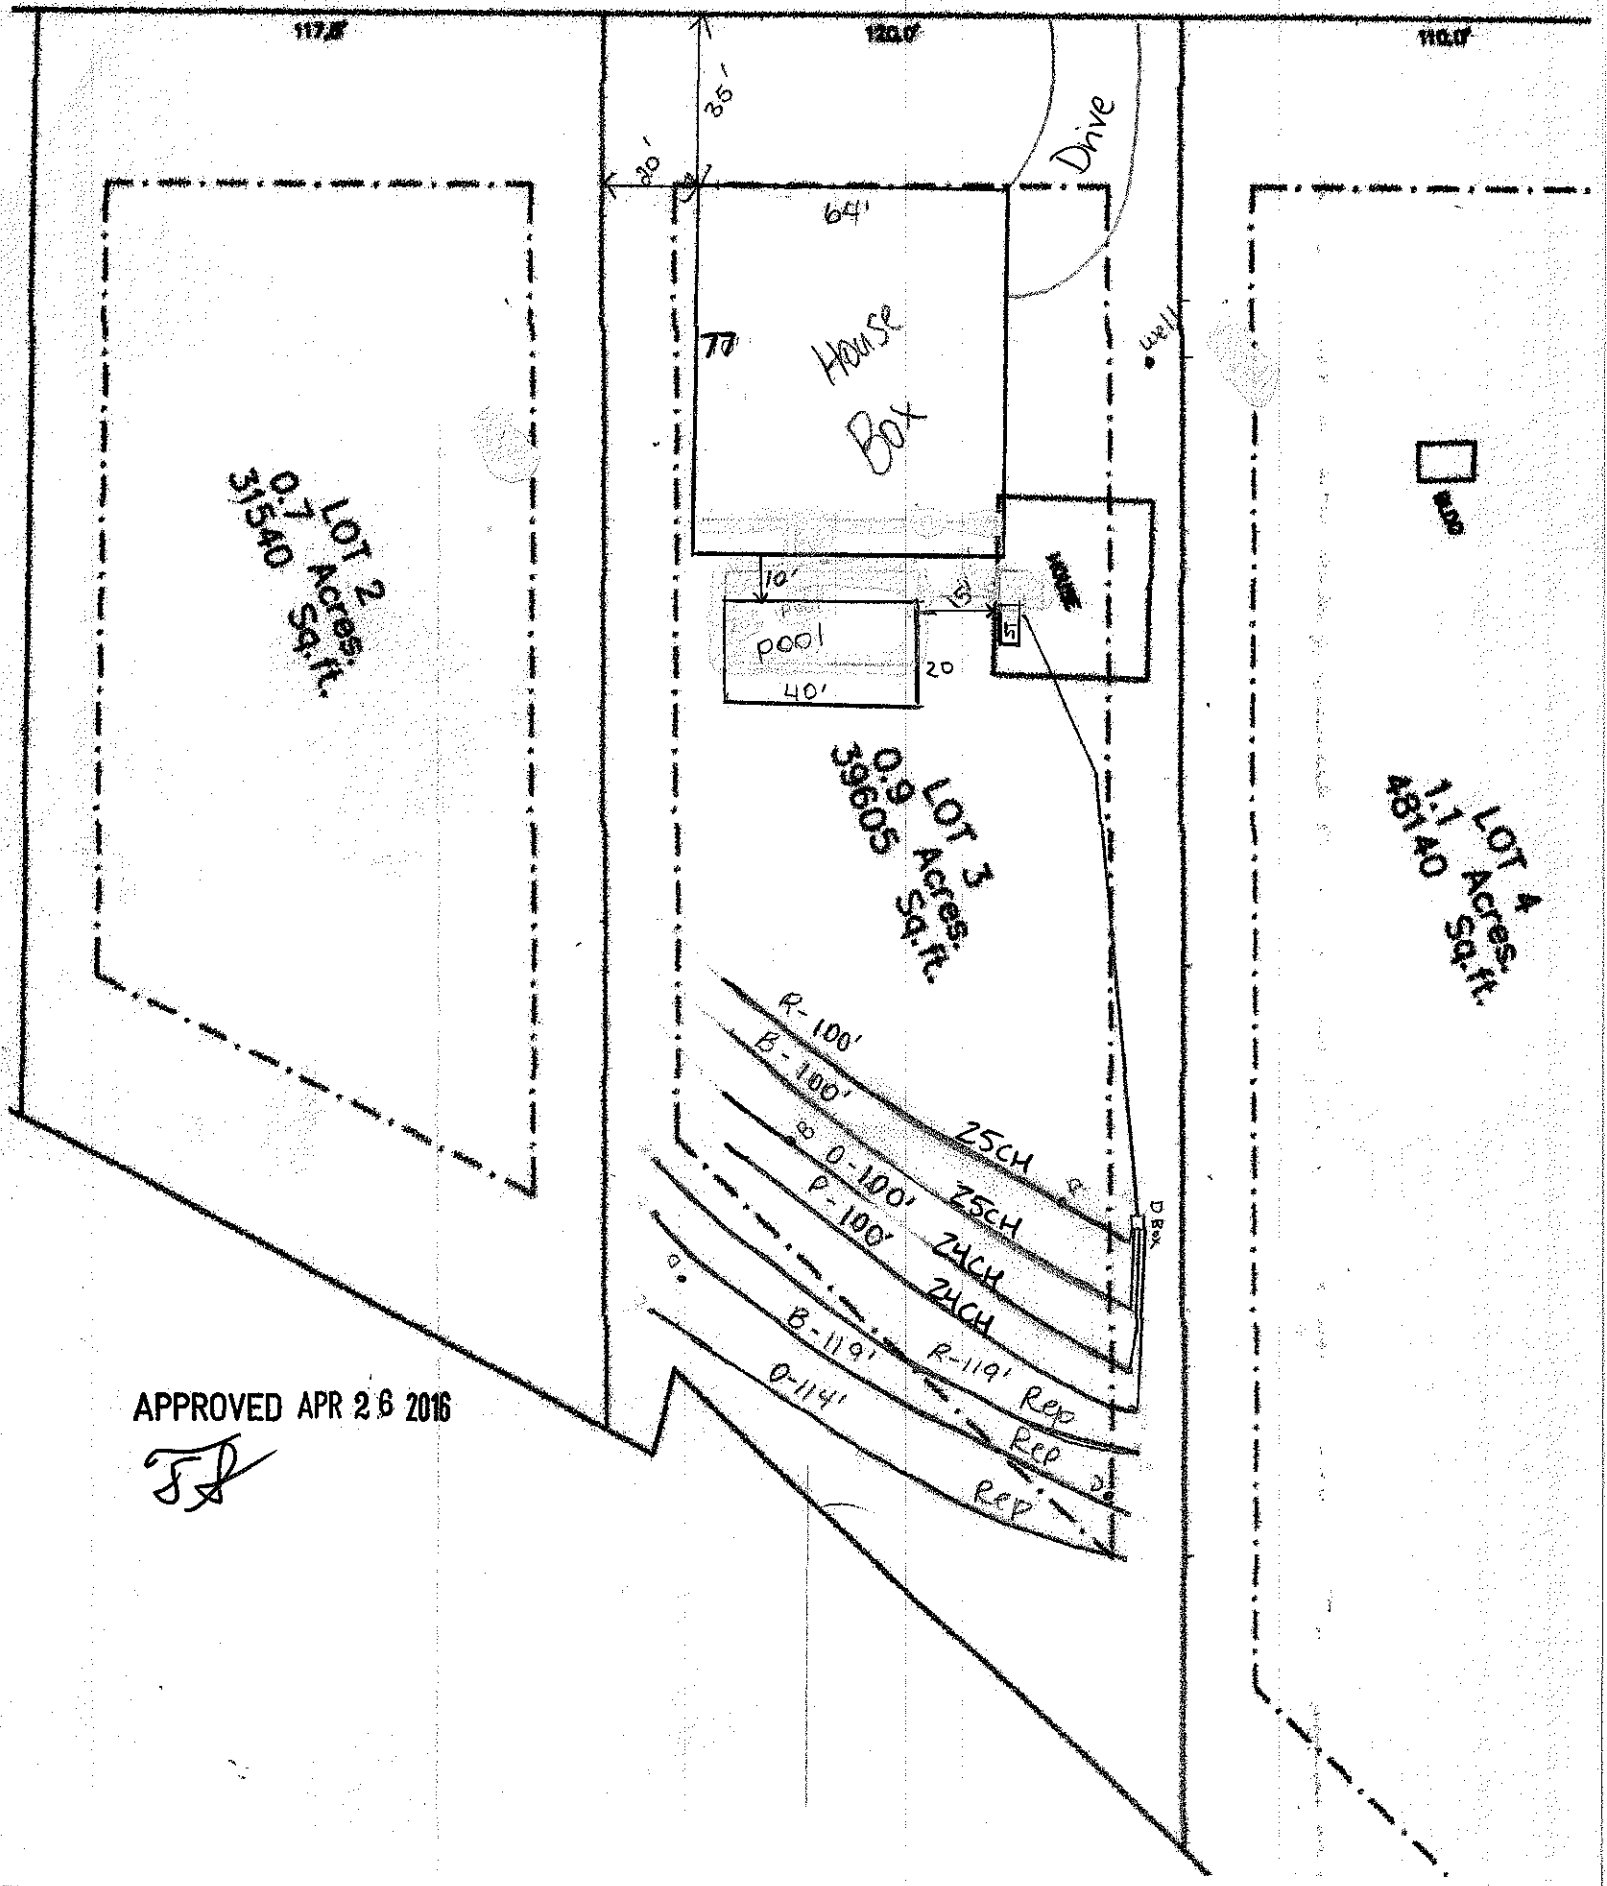

APPROVED APR 26 2016