IREDELL COUNTY HEALTH DEPARTMENT - *ENVIRONMENTAL HEALTH* ☐ STATESVILLE OFFICE 704-878-5305 ☑ MOORESVILLE OFFICE 704-664-5281

IMPROVEMENT PERMIT / AUTHORIZATION TO CONSTRUCT / OPERATION PERMIT / EXISTING SYSTEM INSPECTION

PERMIT # 139334 PIN # 4626-67-0904 DATE 7-9-12

OWNER MJ HOMES APPLICANT: MIKE ATHANAS PHONE: Home/Cell # 704-574-3887 Business #

SITE ADDRESS 116 STAMFORD CT. OWNER / APPLICANT ADDRESS 9335 HARRIS CORNERS

SITE DIRECTIONS MCKENDREE, GRASSHOPPER, CHERRY TREE, STAMFORD

SUBDIVISION THE FARMS BLOCK / SECTION 5 LOT # 577 LOT AREA .9AC DESIGN FLOW 600 L.T.A.R. .3

Septic Tank 1500 Gallons: STB 333 Date 12-19-11

Pump Tank Gallons: PT Date

Pump Make Model Serial #

No. Nitrification Fields: 1 No. Lines 5 Linear Feet 500'

Trench Width 36" Max. Trench Bottom Depth 36" Gravel Depth —

☑ New System ☐ Repair ☐ Expansion System Type I II (III) IV V VI

System Description: G-25% REDUCTION

Repair System Description: LP- PANEL BLOCK

Maintenance Agreement Required ☐ YES ☑ NO

☑ GRAVITY ☐ PRESSURE

☑ Residence No. Bedrooms 5

☐ Business No. Persons

☑ Other No. Employees

☐ Slab ☑ Crawl Space

☐ Basement w/plumbing ☐ Basement w/o plumbing

Water Supply: ☐ Private ☐ Public ☑ Community

Comments / Conditions POOL MUST BE 15' FROM SEPTIC

POOL

ENTERED

INITIAL SITE SKETCH

SEE PLAN BY MIKE ATHANAS APPROVED BY ICHD

BASEMENT AS SHOWN ON SITE PLAN

AS BUILT SKETCH

INSTALLED AS SHOWN ON ATTACHED PLAN

The proposed / existing BASEMENT addition does not appear to impact the existing septic system.

**NOTE:

R.S.

#207391 Date APPROVED DEC 29 2014

ICHD-Environmental Health Division

The proposed / existing Pool addition does not appear to impact the existing septic system.

**NOTE: Shall be min. 15' from septic system

R.S.

#175262 Date: 10-16-12

ICHD-Environmental Health Division

Permit can be suspended or revoked if any false information is supplied toward securing the permit / any unauthorized changes are made to the site / any unauthorized changes are made in the installation of the system.

☐ *IMPROVEMENT PERMIT* with plat valid without expiration. ☐ *IMPROVEMENT PERMIT* with plat valid without expiration. Site plan valid 60 mo. ☑ *AUTHORIZATION TO CONSTRUCT* valid for period equal to IMPROVEMENT PERMIT--not to exceed 60 mo.

Owner / Applicant Signature: Angela Tidwell Date 7-11-12

IMPROVEMENT PERMIT by: REHS Date 7-9-12

AUTHORIZATION TO CONSTRUCT by: REHS Date 7-9-12


YOU SHOULD CONTACT A LOCATOR SERVICE PRIOR TO ANY EXCAVATION

Installed by: RICHARD ABERNATHY

OPERATION PERMIT by: REHS Date 7-19-12

Existing System Inspected by: REHS Date

White Copy – Environmental Health YELLOW COPY (Final) Owner / Applicant PINK COPY (Initial) Owner / Applicant

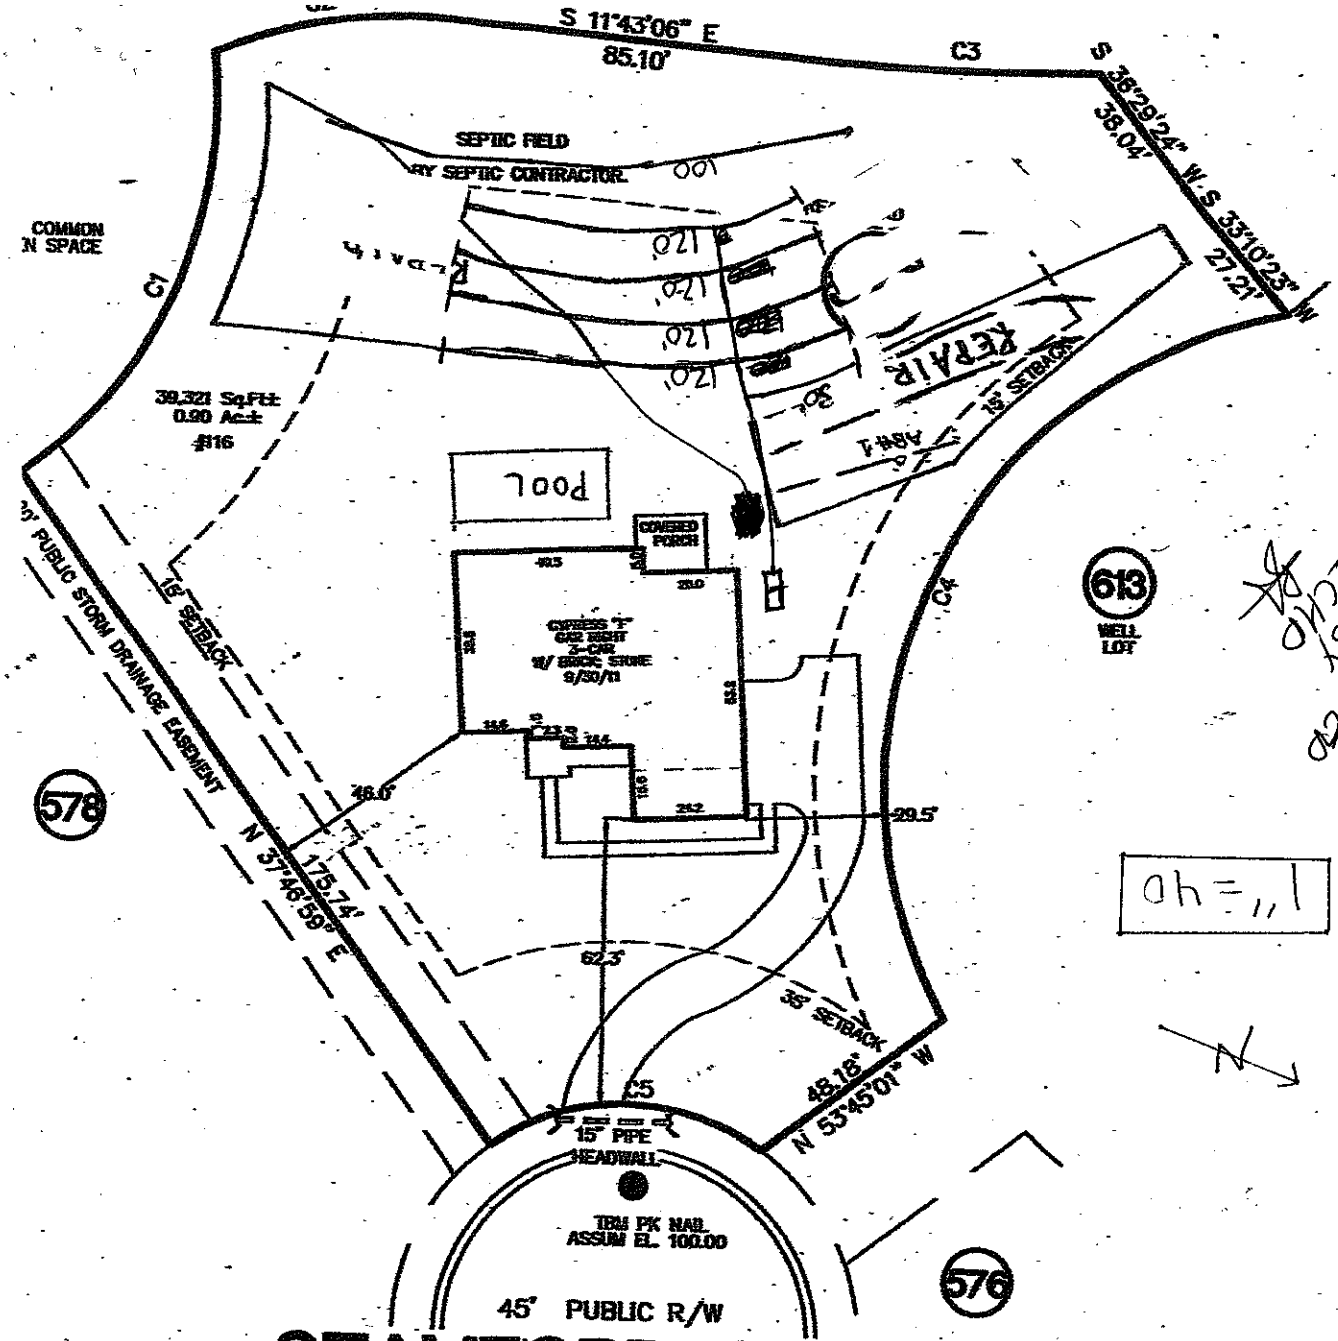

STAMFORD COURT

OPTION B

REVISIONS

REV. #	DATE	COMMENT
REV. 1	11/21/11	REVISE PER SKETCH
REV. 2	12/5/11	REVISE PER SKETCH
REV. 3	12/15/11	CHANGED TO CHANDLER "E"
REV. 4	2/10/12	CHANGED TO CYPRESS "F"
REV. 5	3/7/12	FLIP TO GAR LEFT
REV. 6	3/9/12	FLIP TO GAR RIGHT

	LENGTH	RADIUS
2	104.97	100.00
5	49.60	105.89
9	58.61	577.07
5	198.19	105.00
8	61.97	50.00

AGE &
GAR,

ANY AND ALL APPLICABLE DEED
WAY, UTILITIES AND
E OF RECORD OR IMPLIED

LEGEND– FIELD STAKES
HOUSE CORNER – HC – LIME GREEN
DRIVEWAY – DW – DARK BLUE
SEPTIC / REPAIR AREA – SR – PINK
SETBACKS – SB – PINK;BLACK STRIPE

ENVELOPE
F

THIS DRAWING DOES NOT
REFLECT AS–BUILT INFORMATION

PRELIMINARY PLAT
NOT FOR RECORDATION, CONVEYANCE, OR SALES

40

ER
NV PA

HOUSE LOCATION PLOT PLAN

FOR

LOT 577, THE FARMS PHASE 5, MAP 2
Davidson Township, Iredell County, North Carolina

M/I HOMES