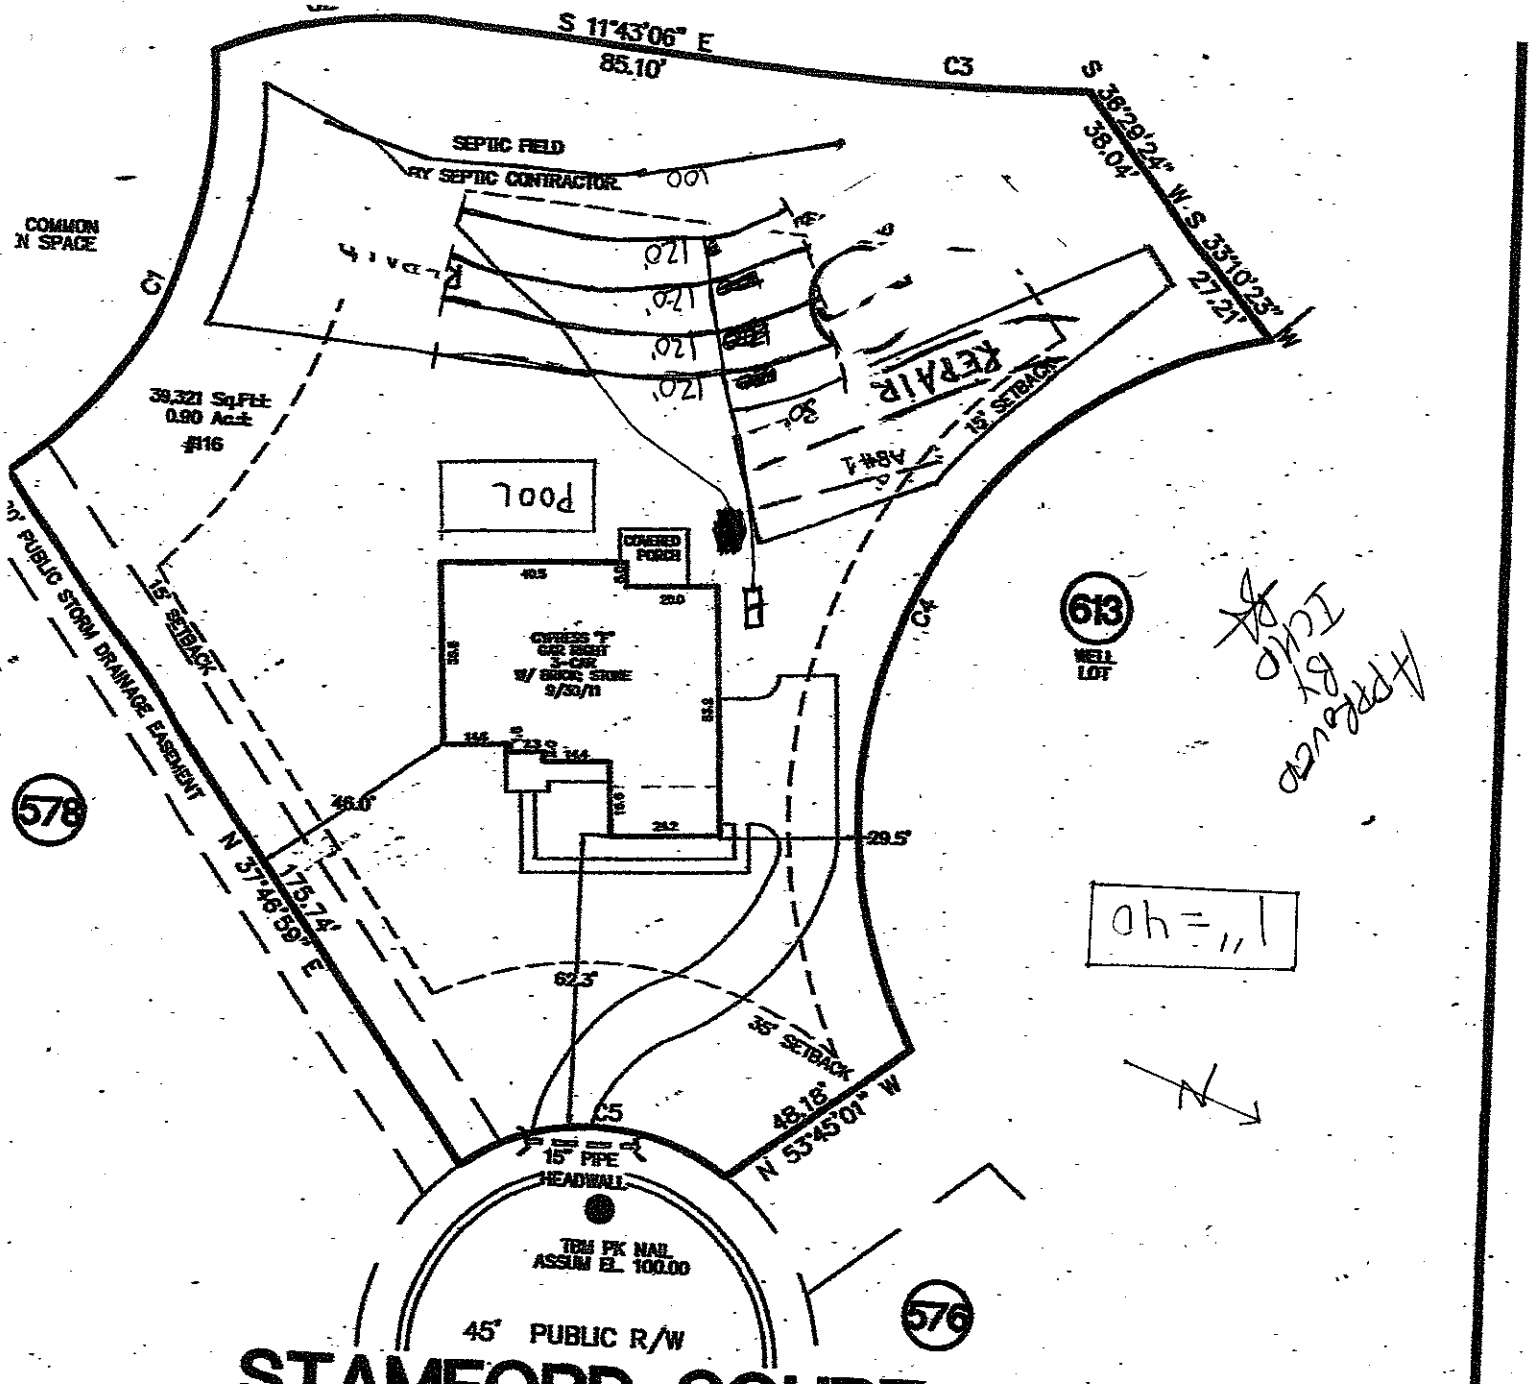


	LENGTH	RADIUS
2	104.97	100.00
5	49.60	105.89
9	56.61	577.07
5	198.19	105.00
8	61.97	50.00

REVISIONS

OPTION B

REV. #	DATE	COMMENT
REV. 1	11/21/11	REVISE PER SKETCH
REV. 2	12/5/11	REVISE PER SKETCH
REV. 3	12/15/11	CHANGED TO CHANDLER "E"
REV. 4	2/10/12	CHANGED TO CYPRESS "F"
REV. 5	3/7/12	FLIP TO GAR LEFT
REV. 6	3/9/12	FLIP TO GAR RIGHT

ENVELOPE

F

THIS DRAWING DOES NOT REFLECT AS-BUILT INFORMATION

PRELIMINARY PLAT

NOT FOR RECORDATION, CONVEYANCES, OR SALES

AGE & EAR,

NY AND ALL APPLICABLE DEED WAY, UTILITIES AND OF RECORD OR IMPLIED

LEGEND– FIELD STAKES

HOUSE CORNER – HC – LIME GREEN
DRIVEWAY – DW – DARK BLUE
SEPTIC / REPAIR AREA – SR – PINK
SETBACKS – SB – PINK;BLACK STRIPE

40

ER

NV PA

HOUSE LOCATION PLOT PLAN

FOR

LOT 577, THE FARMS PHASE 5, MAP 2

Davidson Township, Iredell County, North Carolina

PROPERTY OF

M/I HOMES