IREDELL COUNTY HEALTH DEPARTMENT

Statesville Office (704) 878-5305 Mooresville Office (704) 660-3625 PERMIT # 217987

IMPROVEMENT PERMIT / AUTHORIZATION TO CONSTRUCT / OPERATION PERMIT / EXISTING SYSTEM

PIN # 4626-67-1282

APPLICANT: IQ Custom Construction APPLICANT ADDRESS: 840 Edmiston Rd. Mt. Ulla 28125

SITE ADDRESS: 122 Millhouse Rd. Mooresville, NC PHONE: 704-578-4951 ALT. PHONE:

SITE DIRECTIONS: BSR toward Lake Norman → Right on McKendree Rd → Right on Millhouse → Property on Right

SUBDIVISION: Meadows Field SECTION: — LOT # 4 LOT AREA: 1.1 acres DESIGN FLOW: 480 gal/day L.T.A.R.: 0.30

Septic Tank	1000 (gal)	STB	825	Date	8-05-16
Pump Tank	— (gal)	PT	—	Date	—
Pump Make	—	Model	—	Serial #	—
# Nitrification Fields	1	# Lines	5	Linear Ft:	400
Trench Width	36"	Max. Trench Bottom Depth	24"	Gravel Depth	—

☒ New System ☐ Repair ☐ Expansion System Type: I II (III) IV V VI

System Description: 25% Reduction

Repair System Description: LP-PPBPS (50% Reduction)

Maintenance Agreement Required: ☐ YES ☒ NO

☒ GRAVITY ☐ PRESSURE

☒ Residence ☐ Business ☐ Other ☐ Slab ☐ Basement w/plumbing

No. Bedrooms 4 No. Persons 8 No. Employees — ☒ Crawl Space

☐ Basement w/o plumbing

Water Supply: ☒ Private ☐ Public ☐ Community

Comments / Conditions: Follow all N.C. septic rules. Existing well on property must be abandoned prior to AC issuance. Proof of lot subdivision must be provided to the health department prior to the AC being issued + corresponding lot dimensions must exactly match those in attached plan documentation.

INITIAL SITE SKETCH

See attached plans from

The Oaks Group, PA Kathleen Saunders LSS# 1313

*-2 wells abandoned per N.C. well rules on 6-23-16 -SP

AS BUILT SKETCH

Permit can be suspended or revoked if any false information is supplied toward securing the permit / any unauthorized changes are made to the site / any unauthorized changes are made in the installation of the system. **CONTACT A LOCATOR SERVICE PRIOR TO ANY EXCAVATION**


☐ **IMPROVEMENT PERMIT** *with plat valid without expiration.* ☒ **IMPROVEMENT PERMIT** *with site plan valid for 60 mos.* ☒ **AUTHORIZATION TO CONSTRUCT** *valid for period equal to IMPROVEMENT PERMIT--not to exceed 60 mo.*

Owner / Applicant Signature: Kathleen Saunders Date: 5-2-16 Installed by: Reagan Jeffcoat Tank

IMPROVEMENT PERMIT by: Tom Shuck Date: 4-27-2016 OPERATION PERMIT by: W Sparks Date: 9/14/16

AUTHORIZATION TO CONSTRUCT by: Tom Shuck Date: 6-24-2016 Existing System Inspected by: Date:

Health Dept. Copy - WHITE Applicant (Final Approval) - YELLOW Applicant (Conditional Approval) - PINK

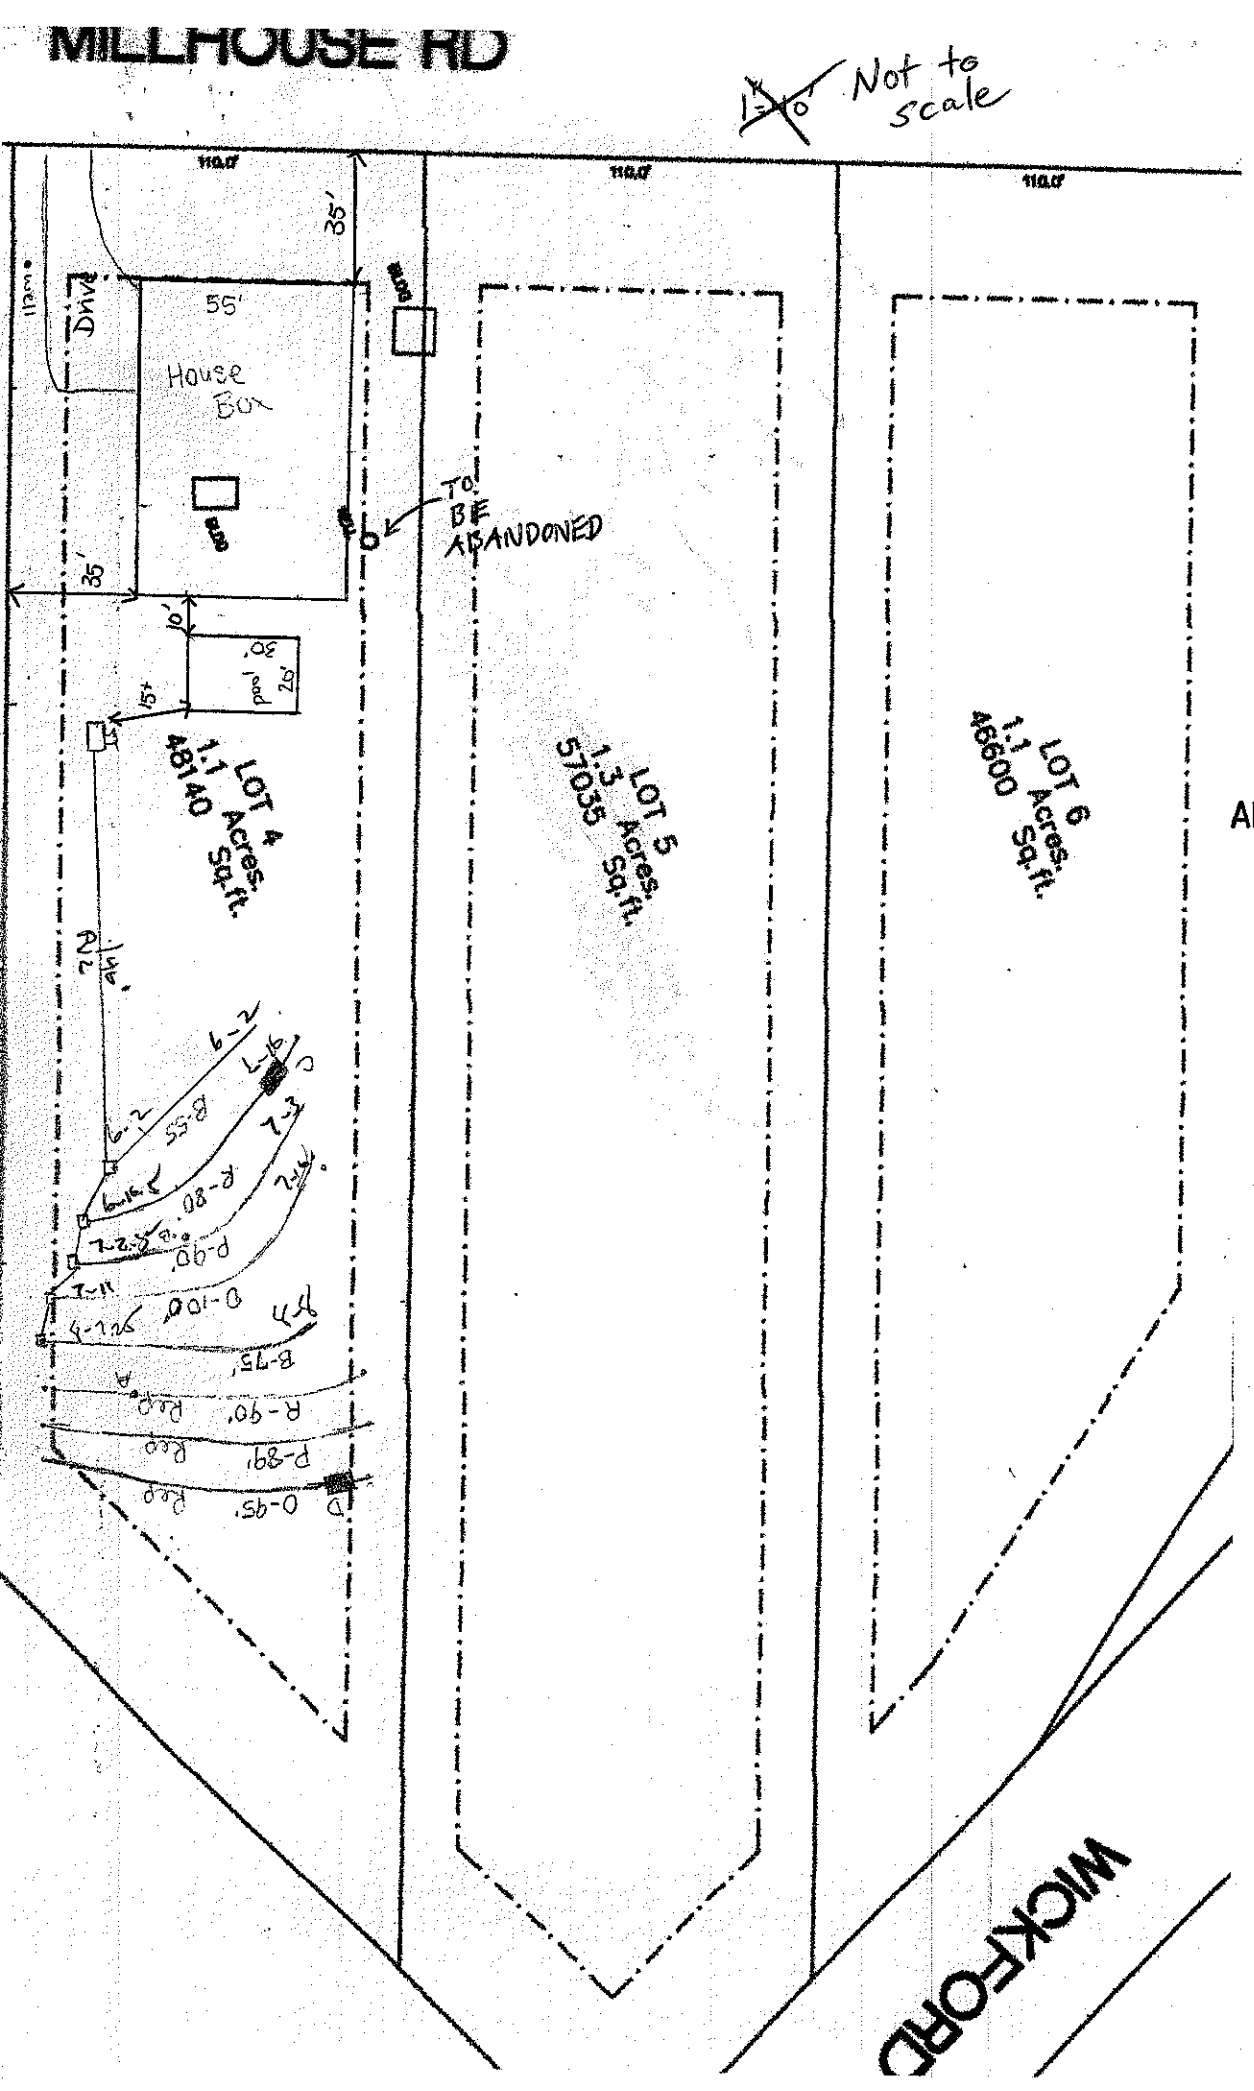

APPROVED APR 29 2016