550. Paid [redacted] 3:30

IREDELL COUNTY HEALTH DEPARTMENT

STATESVILLE 704-878-5305 MOORESVILLE 704-664-5281

IMPROVEMENT PERMIT / AUTHORIZATION TO CONSTRUCT / OPERATION PERMIT / EXISTING SYSTEM INSPECTION

PERMIT# 133566 PIN# 4626673077 DATE 3-8-06

OWNER OR APPLICANT Richard Abernathy/Jim Mellman PHONE: Business 704-309-8625 Home 704-664-6506

ADDRESS 1397 Brawley School Rd/ mooresville 28117

LOCATION Brawley School Rd TR McKendree TR Hagerty Ln on left

SUBDIVISION Brookridge Shores BLOCK / SECTION 6 LOT 3 LOT AREA .48 Ac SITE CLASS. PS DESIGN FLOW 360gpd L.T.A.R. .3 gpd/ft²

Septic Tank: 1000 Gallons; STB 794 Date 8-24-07

Pump Tank: 1000 Gallons; PT 27 Date 5-20-08

Pump Make: Goulds Model PES1M Serial No.

Nitrification Field: No Fields 1 Square Feet 1200 Linear Feet 200

No Lines 3 Trench Width 24" Max Trench Bottom Depth 36"

☒ New System ☐ Repair ☐ Expansion System Type: I II III IV V VI

System Description: LP Panel

Repair System Description: LP Panel

Maintenance Agreement Required: ☒ Yes ☐ No

☒ House/Mod. Home ☐ Mobile Home ☐ Business ☐ Other

No. Bedrooms 3 No. Persons ___ No. Employees ___

Water Supply: ☒ Individual ☐ Public ☐ Community


Gravel Depth N/A ☐ Gravity ☒ Pressure ☐ Slab ☒ Crawl Space ☐ Basement w/plumbing ☐ Basement wo/plumbing

Comments:/Conditions: * Tanks may be set behind house if meet rules. Supply line sleeved under driveway. No vertical 46 panels cut 2' or greater w/in 15' of tanks or system

Comments:/Conditions: Installed 3 lines @ 67 Ft ea 15 panels each line 5/32" hole 7/11/08 Checked tanks & lines

1" = 50'

INITIAL SITE SKETCH

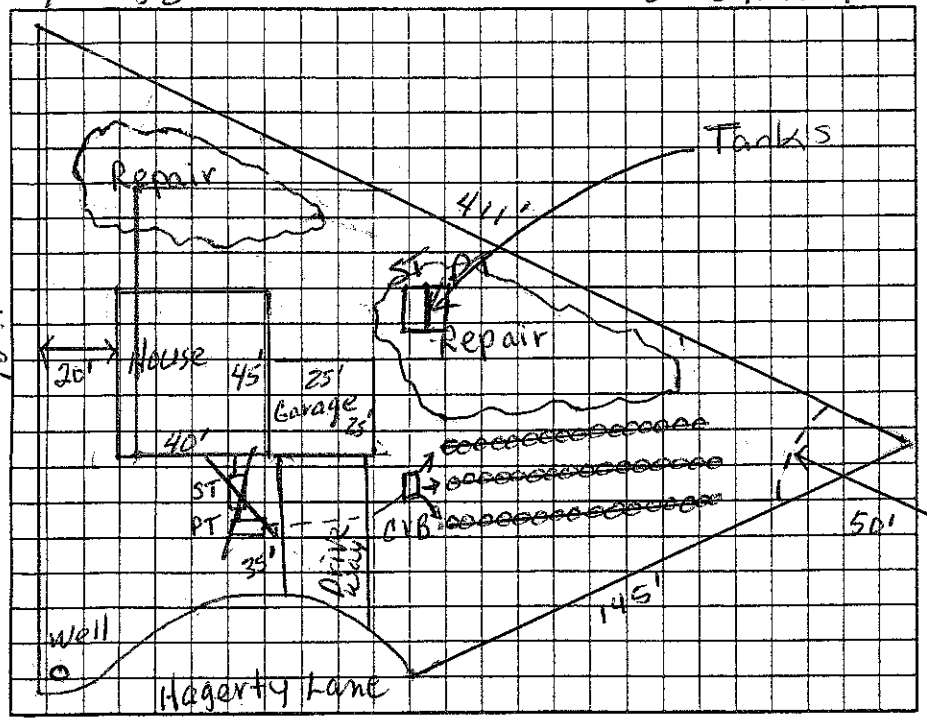

AS BUILT SKETCH

Permit can be suspended or revoked if any false information is supplied toward securing the permit/any unauthorized changes are made to the site/any unauthorized changes are made in the installation of the system. Improvement Permit with plat valid without expiration ☐ Improvement Permit with site plan valid for sixty months ☒ Authorization to Construct is valid for a period equal to that of Improvement Permit – not to exceed sixty months.

Signed: Robyn B. Abernathy date 3-17-06 Installed by: Richard Abernathy

Improvement Permit by: Jimmy Mellman date 3-8-06 Operation Permit by: [illegible] date 4-8-08

Authorization to Construct by: [signature] date 1-30-08 Existing System Inspection by: ___ date ___

HEALTH DEPT. COPY: WHITE OWNER COPY (FINAL): YELLOW OWNER COPY (INITIAL): PINK