IREDELL COUNTY HEALTH DEPARTMENT

STATESVILLE 704-878-5305 ☒MOORESVILLE 704-664-5281

IMPROVEMENT PERMIT / AUTHORIZATION TO CONSTRUCT / OPERATION PERMIT / EXISTING SYSTEM INSPECTION

PERMIT # 133566 PIN # 4626-67-3077 DATE 12-12-12

OWNER or APPLICANT Jim Moellman PHONE: Business 704-~~8~~576-3887 ~~Home:~~ MIKE ATHANAS

OWNER or APPLICANT ADDRESS 412 Lakeview Shores Lp.

LOCATION / DIRECTIONS BSR, TR McKendree, TR Fulton Farms, on L

SUBDIVISION Brookridge Shores BLOCK / SECTION 6 LOT # 3 LOT AREA 1.84c DESIGN FLOW 480 L.T.A.R. .3

Septic Tank Ex. 1000 Gallons: STB _____ Date _____

Pump Tank _____ Gallons: P T _____ Date _____

Pump Make _____ Model _____ Serial # _____

Nitrification Field No Fields 1 No Lines 2 Linear Feet 67'

Trench Width 24" Max. Trench Bottom Depth 36" Gravel Depth —

☐ New System ☐ Repair ☒ Expansion System Type I II III (IV) V VI

System Description: LP- Panel Block

Repair System Description: Same

Maintenance Agreement Required ☐ YES ☐ NO

☐ GRAVITY ☐ PRESSURE

☒ Residence No. Bedrooms 4

☐ Business No. Persons _____

☐ Other No. Employees _____

☐ Slab ☒ Crawl Space

☐ Basement w/plumbing ☐ Basement w/o plumbing

Water Supply: ☒ Private ☐ Public ☐ Community

Comments / Conditions

Comments / Conditions

INITIAL SITE SKETCH

See Plan From Michael Athanas Approved By ICHD BA

AS BUILT SKETCH

Checked Lines 2-7-13 BA

Pressure set 3/25/13 MD

Permit can be suspended or revoked if any false information is supplied toward securing the permit / any unauthorized changes are made to the site / any unauthorized changes are made in the installation of the system.

☐ *IMPROVEMENT PERMIT w / plat valid without expiration.* ☒ *IMPROVEMENT PERMIT w / site plan valid for 60 mos.* ☒ *AUTHORIZATION TO CONSTRUCT valid for period equal to IMPROVEMENT PERMIT-not to exceed 60 mo.*

Owner / Applicant Signature: BA Date 12/14/12

Improvement Permit by: BA Date 12-12-12

Authorzation to Construct by: BA Date 12-17-12


Installed by: Richard Abernathy

Operation Permit by: RS Date: 3/25/13

Existing System Inspected by: _____ Date: _____

YOU SHOULD CONTACT A LOCATOR SERVICE PRIOR TO ANY EXCAVATION.

WHITE COPY Environmental Health YELLOW COPY (Final) Owner / Applicant PINK COPY (Initial) Owner / Applicant

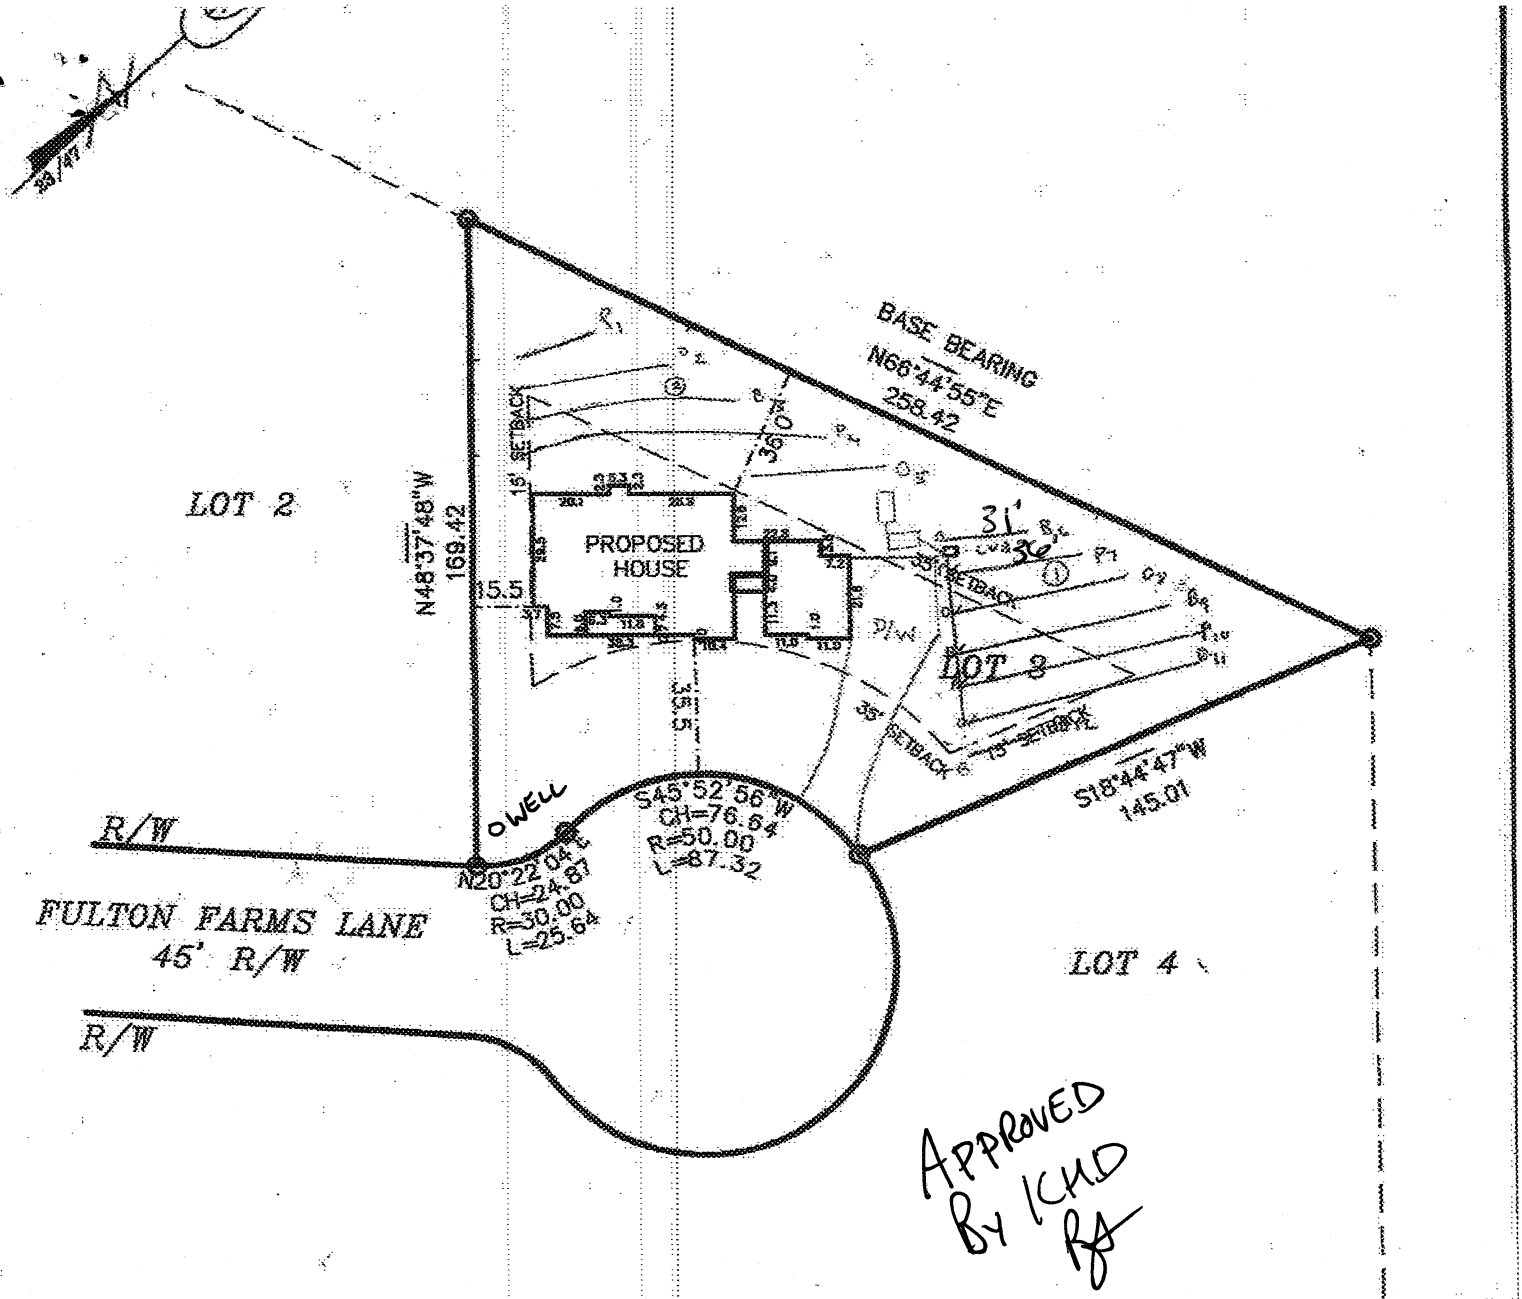

0' 25' 50' 100'

SCALE IN FEET

LEGEND

- P.P. = POWER POLE
- = DUKE POWER TRANS.
- E.I.P. = EXISTING IRON FOUND
- I.P.S. = #4 REBAR SET
- R/W = RIGHT-OF-WAY
- W = WELL

NOTES

1) THIS PROPERTY MAY BE SUBJECT TO ANY EASEMENTS AND/OR RIGHTS OF WAY OF RECORD.
2) ACREAGE COMPUTED BY THE COORDINATE METHOD.
3) UNDERGROUND POWER
4) NO GRID MONUMENT FOUND WITHIN 2000 FEET.

PLOT PLAN SURVEY

OF

#133 FULTON FARMS LANE

LOT 3, BROOKRIDGE SHORES PHASE 4

SCALE 1" = 50'

DAVIDSON TWSP., IREDELL CO., NC

ACQUIRED BY: THE MOELLMAN GROUP

FIELD BOOK:
FILE: BROOKRIDGE SHORES PHASE 4
DC FILE:
TAX MAP NO: 4626-67-3077