IREDELL COUNTY HEALTH DEPARTMENT

Statesville Phone TR 3-7271 Mooresville Phone NO 3-1271

PERMIT TO INSTALL SEPTIC TANK

Permit No. 119 Permit Date 6-29-1972

Owner Charles C. Scawell Address Charlotte

Installed By E. J. Ervin Address Mooresville


Location of Property Sec 8 Lot 481 / right across from private Rd go to first right then first Trailor on left

Tank		Capacity		Length of Lines		Fixtures	
Block	( )	1000	(✓)	225'	(✓)	No. of Baths	(2)
Precast	(✓)	1250	( )	250'	( )	Dishwasher	(no)
		1500	( )	Other		Garbage Grdr.	(no)
		Other				Other	

NOTIFY HEALTH DEPARTMENT AT LEAST EIGHT HOURS BEFORE TANK IS TO BE INSPECTED.

Final Inspection 6-29-1972 Approved (X) Disapproved ( )

Remarks well not located yet

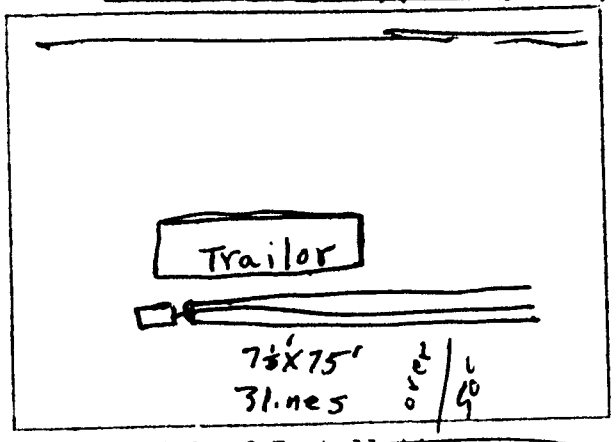

Sketch of Installation

Lake

J. C. Moore

Sanitarian