MARK – SU-4795

IREDELL COUNTY HEALTH DEPARTMENT

...ESVILLE 704-878-5305 Paid 325.00 6016 MOORESVILLE 704-664-... 3-3570

IMPROVEMENT PERMIT / AUTHORIZATION TO CONSTRUCT / OPERATION PERMIT / EXISTING SYSTEM INSPECTION

PERMIT# 088934 PIN# 4626 67 5446 DATE 6/15/00

OWNER OR CONTRACTOR Bridgewater Co. PHONE: Business 663-6905 Home

ADDRESS PO Box 1498 Huntersville, NC. 28078

LOCATION 1100, RM2 Kendrew Rd., R McElhaney R Wickford Lane on (L) extend.

SUBDIVISION C L + T BLOCK / SECTION 8 48H LOT AREA .69 SITE CLASS. PS DESIGN FLOW 360 L.T.A.R. .3

Septic Tank: 1000 Gallons; STB 312 Date 7/14/00
Pump Tank: 1000 Gallons; PT 37 Date 11/3/99
Pump Make: SHEF50 A1 Model HYDROMATIC Serial No. 8/8/2000
Nitrification Field: No. Fields 1 Square Feet 400 Linear Feet 200
No Lines ~~4~~ Trench Width 36" Max Trench Bottom Depth 36" ~~Gravel Depth~~ SAND.

[X] New System [ ] Repair System Type: I, II, III, IV, V, VI
System Description: LPDIST – 16" PPBS
Repair System Description: SAME
Maintenance Agreement Required: [X] Yes [ ] No
[ ] Slab [ ] Crawl Space [X] Basement w/plumbing [ ] Basement wo/plumbing


[X] House/Mod. Home No. Bedrooms 3
[ ] Mobile Home No. Bathrooms 3
[ ] Business No. Employees
[ ] Other

Water Supply: [X] Individual [ ] Public [ ] Community

Comments:/Conditions: Pat Vannoy handling – Low Pressure Pipe Pattern installed from T. Jacobs (1"=40')

Comments:/Conditions: 205' 16" PPBS – LPP Distribution

INITIAL SITE SKETCH

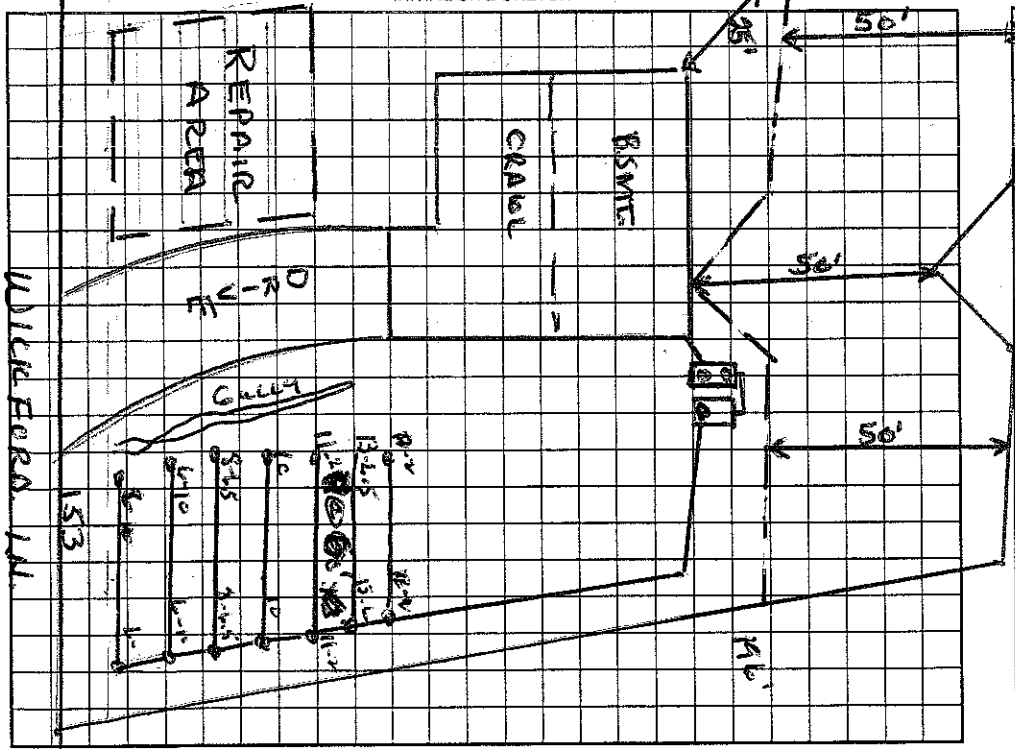

AS BUILT SKETCH

Permit can be suspended or revoked if any false information is supplied toward securing the permit/any unauthorized changes are made to the site/any unauthorized changes are made in the installation of the system. Improvement Permit with plat valid without expiration. Improvement Permit with site plan valid for sixty months. Authorization to Construct is valid for a period equal to that of Improvement Permit – not to exceed sixty months.

Signed: Tammy Taylor, CHES Agent date 6/16/00 Installed by: Macleod Const

Improvement Permit by: Wesley Sparks R.S. date 6/15/00 Operation Permit by: Wesley Sparks R.S. date 2/23/01

Authorization to Construct by: Wesley Sparks R.S. date 6/15/00 Existing System Inspection by: date

HEALTH DEPT. COPY: WHITE OWNER COPY (FINAL): YELLOW OWNER COPY (INITIAL): PINK