IREDELL COUNTY HEALTH DEPARTMENT

STATESVILLE 704-878-5305
MOORESVILLE 704-664-5281

IMPROVEMENT PERMIT / ~~CERTIFICATE OF COMPLETION~~ / OPERATION PERMIT / EXISTING SYSTEM INSPECTION

Authorization to Construct

PIN# 4626-67-8010

PROPERTY DESCRIPTION NO. 23680 DATE 5/29/96 TAX MAP NO. 2F-10-B-6

OWNER OR CONTRACTOR RSMB Enterprises PHONE: Business _____ Home 663-5592

ADDRESS PO Box 1738 Mooresville NC 28115 Watershed: ~~Yes~~ No

LOCATION Beside #146 Ridge Brook Dr. - Brawley school - TR McKendree - TR BrookRidge - TR RidgeBrook lot at end of

SUBDIVISION BrookRidge Stones BLOCK / SECTION — LOT 6 LOT AREA .75 ac SITE CLASS. 25 DESIGN FLOW 360gpd L.T.A.R. .3 gpd/sf

Septic Tank: 1000 Gallons; STB 794 Date 8/15/96

Pump Tank: _____ Gallons; PT _____ Date _____

Pump Make: _____ Model _____ Serial No. _____

Nitrification Field: No Fields 1 Square Feet 1200 Linear Feet 400

No Lines 5 Trench Width 36" Max Trench Bottom Depth ~~*~~ 24" Gravel Depth 12"

☑ New System ☐ Repair System Type: I, II, III, IV, V, VI

System Description: Gravity Conventional

Repair System Description: Same

Maintenance Agreement Required: ☐ Yes ☑ No

☑ House/Mod. Home No. Bedrooms 3
☐ Mobile Home No. Bathrooms 2
☐ Business No. Employees ____
☐ Other _____


☐ Slab ☑ Crawl Space ☐ Basement w/plumbing ☐ Basement wo/plumbing

Water Supply: ☑ Individual ☐ Community ☐ Public


Comments: ~~*~~Stay 50' from neighbor's well~~*~~ (24" trench bottom)

Comments: Repair loaded at .25 gpd/ft — EZ LAY INSTALLED 25% REDUCTION

INITIAL SITE SKETCH 1"=60'

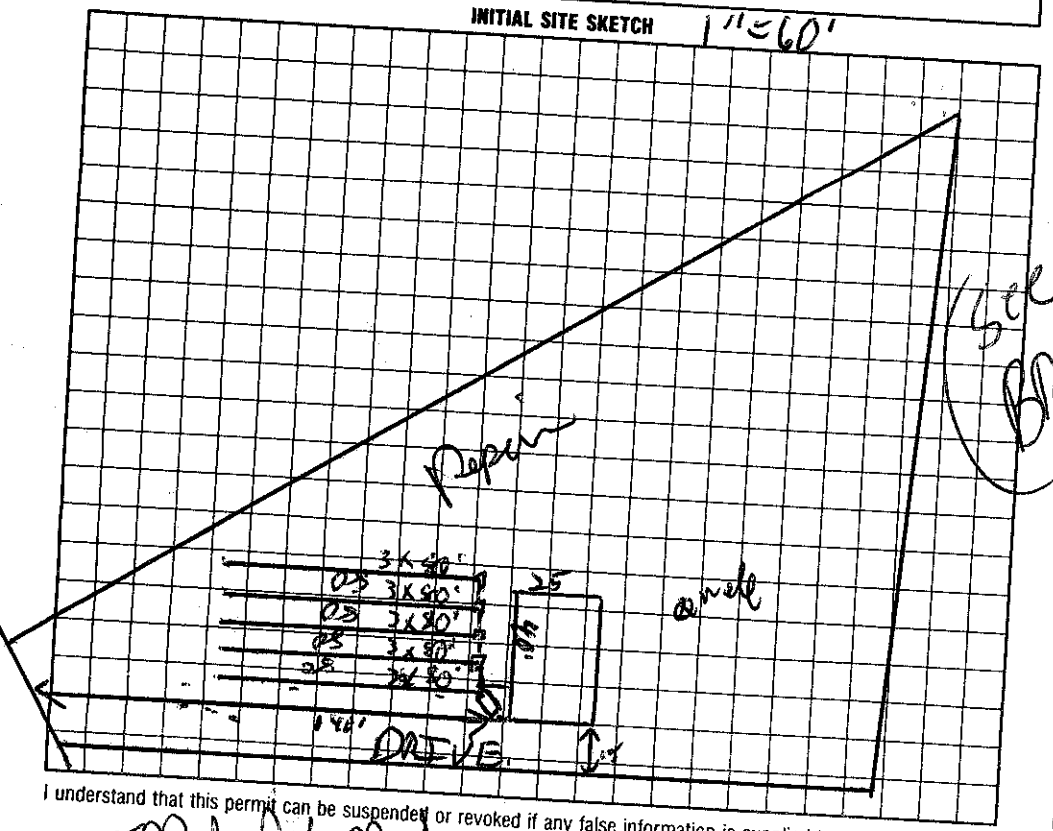

AS BUILT SKETCH

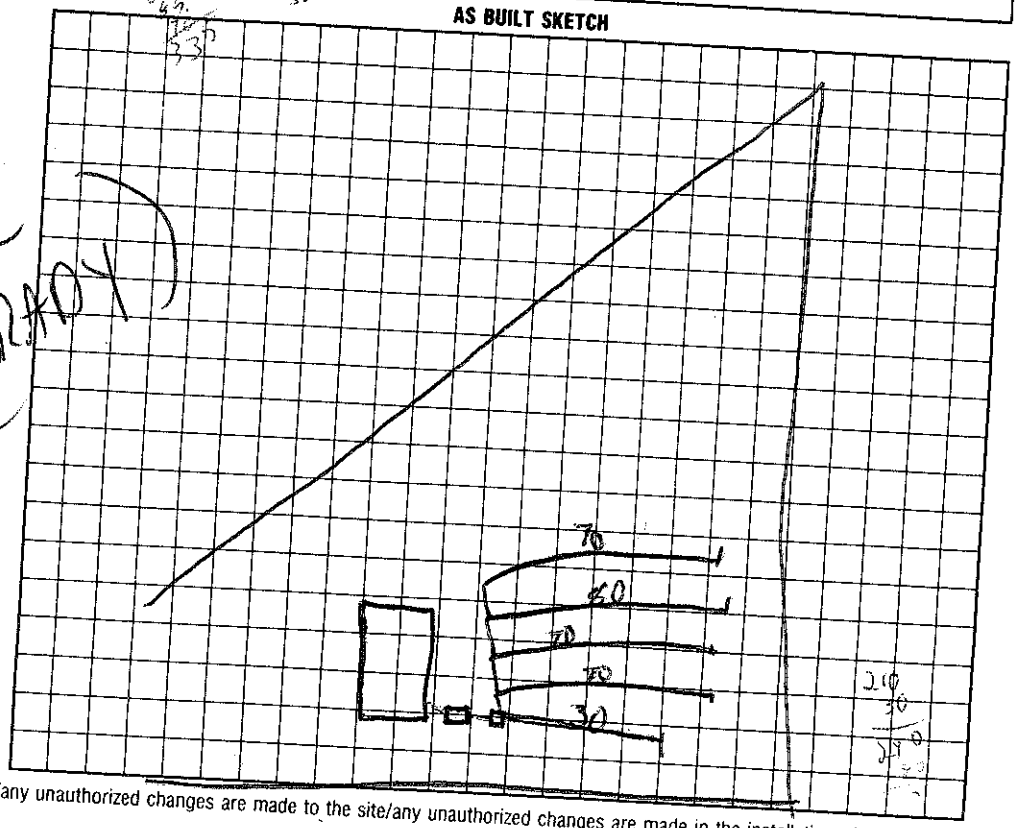

I understand that this permit can be suspended or revoked if any false information is supplied toward securing the permit/any unauthorized changes are made to the site/any unauthorized changes are made in the installation of the system.

Signed: Michael J Mabry RSMB

Improvement Permit by: C. Bailey Freeman EHSS date 5/29/96

~~Authorization to Construct~~ Existing System Inspection by: C. Bailey Freeman EHSS date 5/29/96

Installed by: LeVon Benton

Certificate of Completion by: _____ date _____

Operation Permit by: C. Bailey Freeman date 12/3/96

HEALTH DEPT. COPY: WHITE INSPECTION COPY (FINAL): GREEN OWNER COPY (FINAL): YELLOW INSPECTION COPY (INITIAL): PINK OWNER COPY (INITIAL): GOLD

Authorization to Construct is valid for 60 months from issue date