IREDELL COUNTY HEALTH DEPARTMENT

STATESVILLE 704-878-5305 375.00 Paid MOORESVILLE 704-664-5281

IMPROVEMENT PERMIT / AUTHORIZATION TO CONSTRUCT / OPERATION PERMIT / EXISTING SYSTEM INSPECTION

PERMIT# 113098 PIN# 4626 68 1661 REALTY WORLD DATE 6/17/03

OWNER OR CONTRACTOR SEAN NORTHMORE PHONE: Business 704-664-7447 Home

ADDRESS 106 DUE EAST RD. MOORESVILLE, NC. 28115

LOCATION 1100 TR McKENDREE RD. TR GRASSHOPPER CIR., STRAIGHT TR DUE EAST, 2ND LOT ON (R)

SUBDIVISION CL+T BLOCK / SECTION 8 LOT 473 LOT AREA .7 AC SITE CLASS. PS DESIGN FLOW 480 L.T.A.R. .3

Septic Tank: 1000 Gallons; STB 1007 Date 8/14/02

Pump Tank: 1000 Gallons; PT 274 Date 7/20/04

Pump Make: ZOELLER Model N-98 Serial No. 1163835 Aug

Nitrification Field: No Fields 1 Square Feet 536 Linear Feet 268

No Lines 5@67' Trench Width 2-3' Max Trench Bottom Depth 3' Gravel Depth NO

[X] New System [ ] Repair System Type: I, II, III, (IV), V, VI

System Description: LP - 16" PPBPS

Repair System Description: SAME

Maintenance Agreement Required: [X] Yes [ ] No

[X] House/Mod. Home [ ] Mobile Home [ ] Business [ ] Other

No. Bedrooms 5 4 No. Bathrooms 4 No. Employees 480.

[ ] Slab [ ] Crawl Space [X] Basement w/plumbing [ ] Basement wo/plumbing


Water Supply: [X] Individual [ ] Public [ ] Community EXISTING

Comments:/Conditions: 1" = 50'

Comments:/Conditions: Steve Pelchat - 363-4846 / SEP

System installed as 4 Bedroom

INITIAL SITE SKETCH

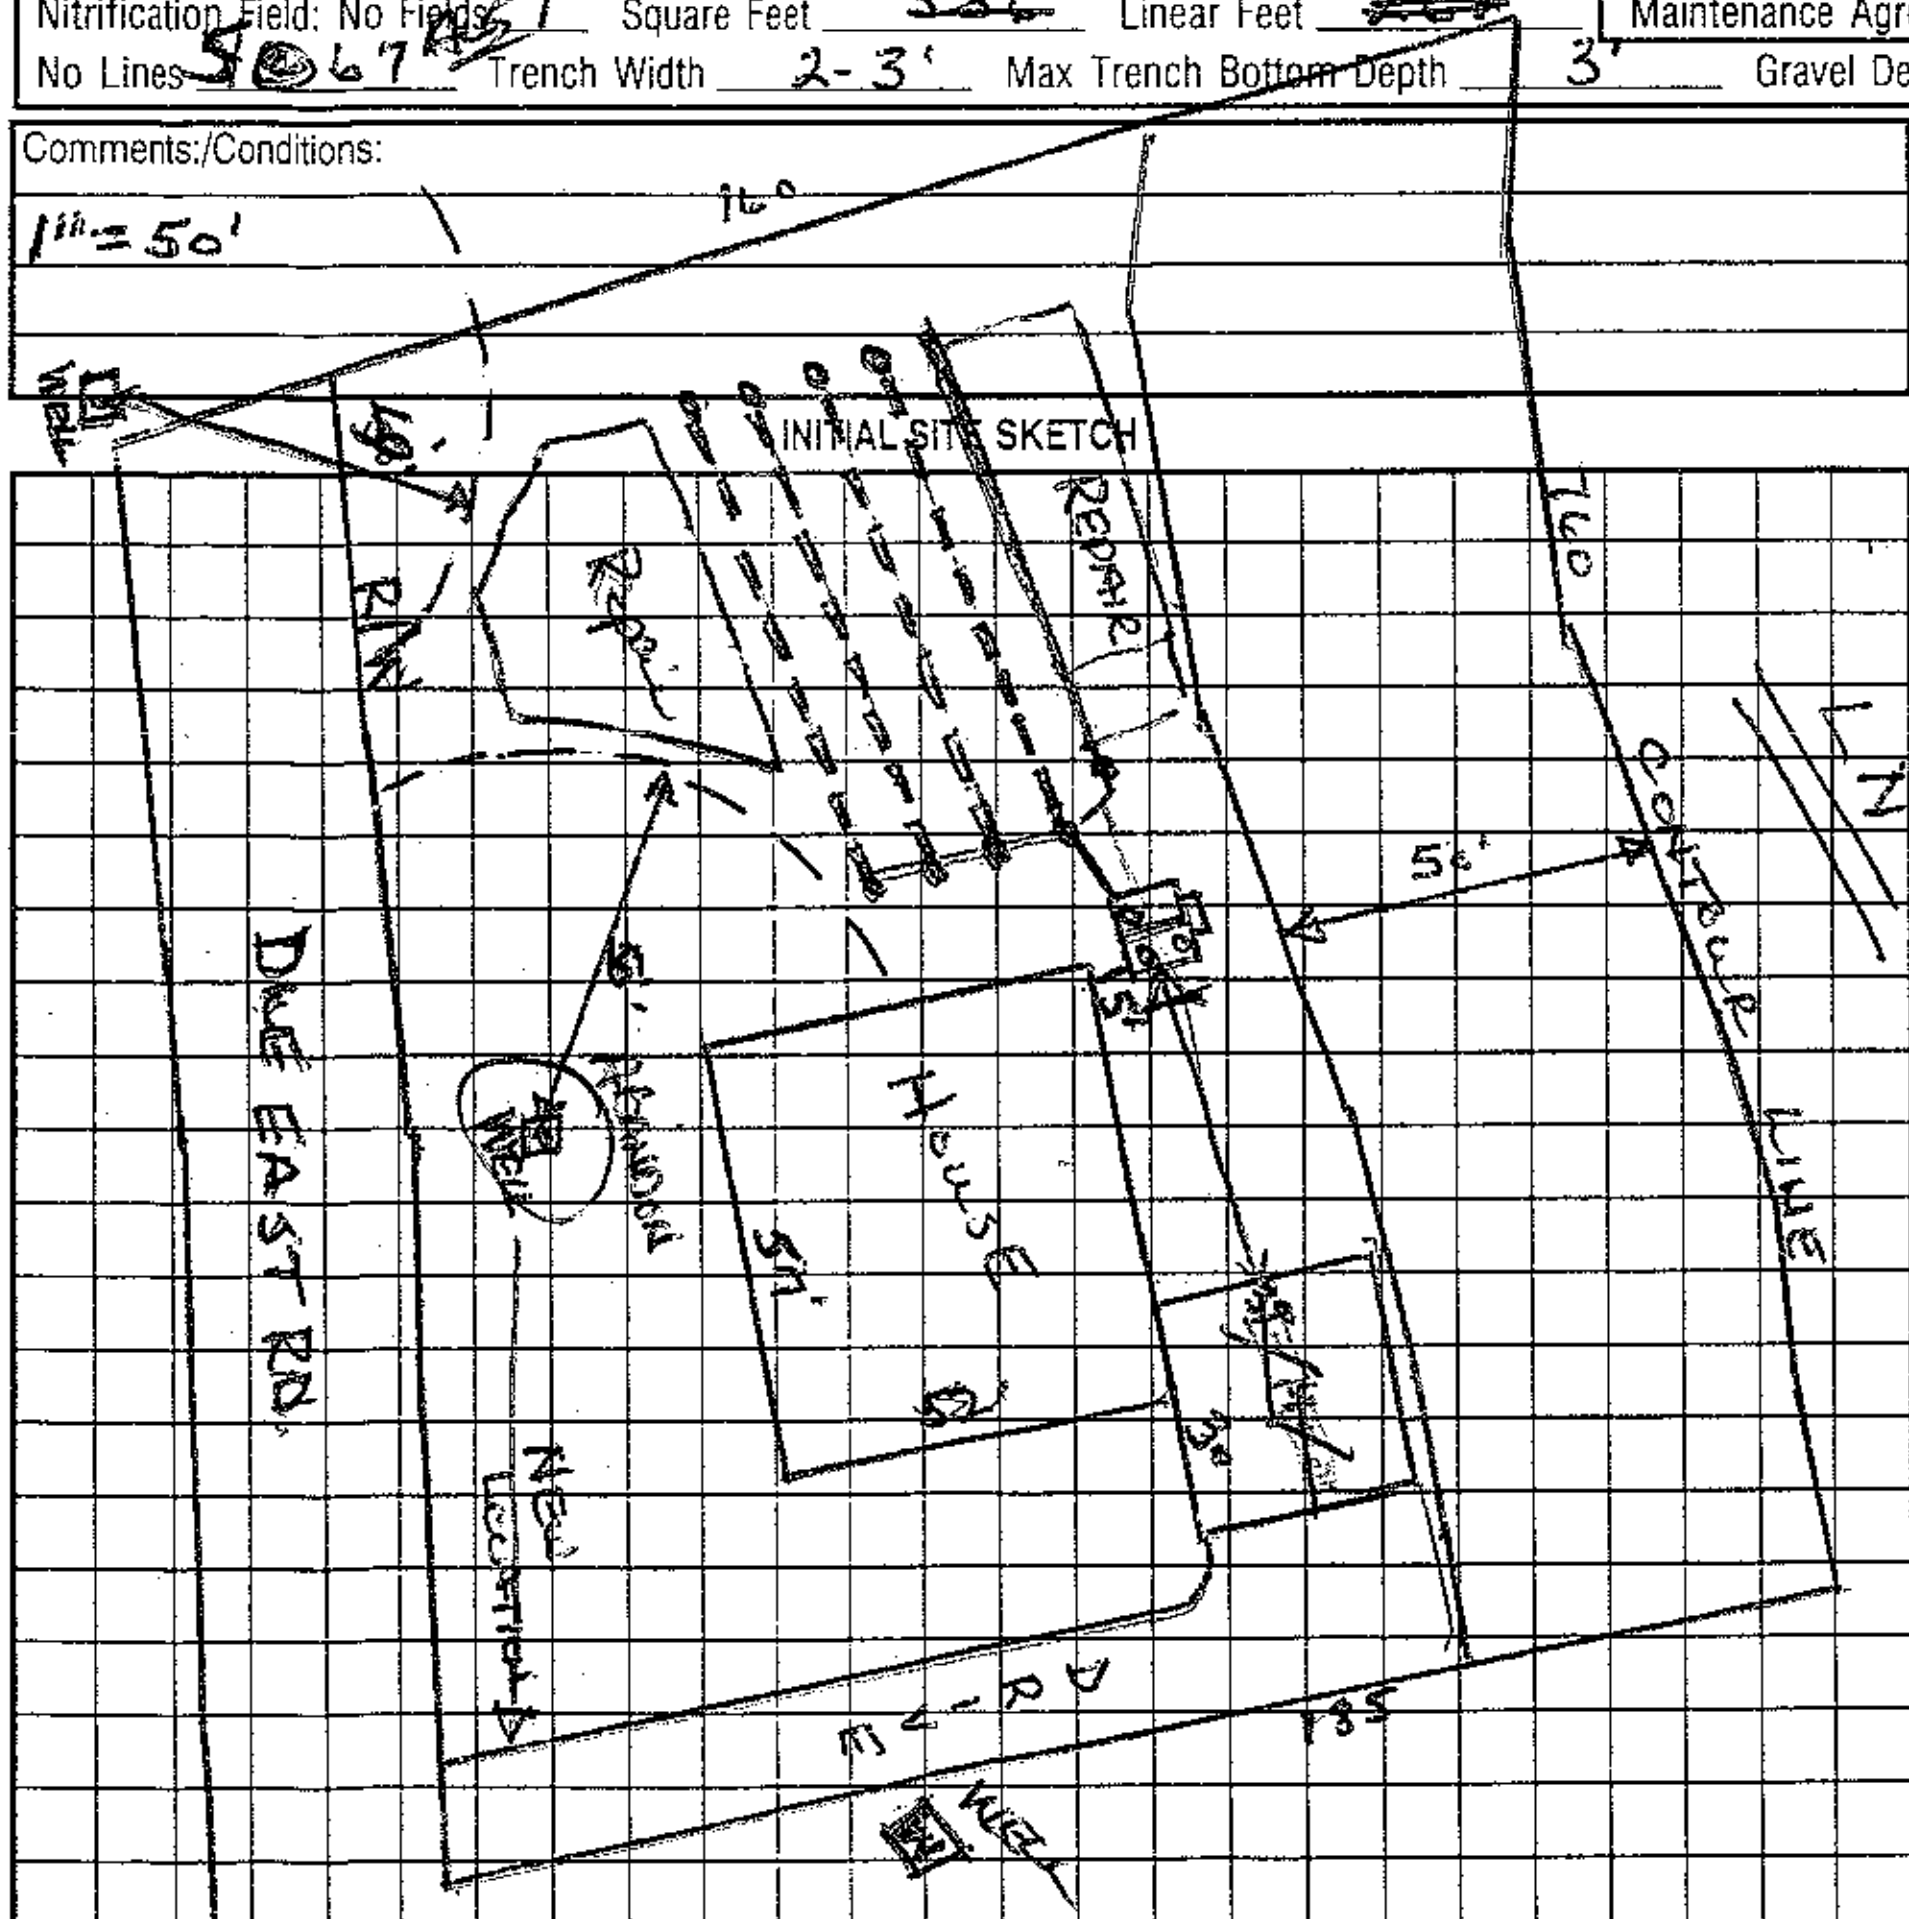

AS BUILT SKETCH

Permit can be suspended or revoked if any false information is supplied toward securing the permit/any unauthorized changes are made to the site/any unauthorized changes are made in the installation of the system. Improvement Permit with plat valid without expiration. Improvement Permit with site plan valid for sixty months. Authorization to Construct is valid for a period equal to that of Improvement Permit – not to exceed sixty months.

Signed: *Denise P Chapman (Realtor) date 6-20-03

Improvement Permit by: Wesley Sparks RS. date 6/17/03

Authorization to Construct by: Wesley Sparks RS. date 6/1/04

Installed by: Sammy Reavis

Operation Permit by: Wesley Sparks RS date 11/12/04

Existing System Inspection by: date

HEALTH DEPT. COPY: WHITE OWNER COPY (FINAL): YELLOW OWNER COPY (INITIAL): PINK