IREDELL COUNTY HEALTH DEPARTMENT

STATESVILLE 704-878-5305 MOORESVILLE 704-664-5281

IMPROVEMENT PERMIT / AUTHORIZATION TO CONSTRUCT / OPERATION PERMIT / EXISTING SYSTEM INSPECTION

PERMIT# 1424 20 20 PIN# 4627668216 7.000 DATE Jan-31-08

OWNER OR APPLICANT Brian & Kesha Cranthum PHONE: Business 704-502-4106 Home 704-660-9803

ADDRESS 142 Wickford Ln Mooresville NC 28117

LOCATION Brawley / TR McKendree / TR Millhouse / TL Wickford / 1st house on Right

SUBDIVISION ~~CAB~~ C L&T BLOCK / SECTION ~~D~~ 8 LOT ~~24~~ 47 LOT AREA — SITE CLASS. — DESIGN FLOW 2 L.T.A.R. —

Septic Tank: Existing Gallons: STB — Date —

Pump Tank: — Gallons: PT — Date —

Pump Make: — Model — Serial No. —

Nitrification Field: No Fields — Square Feet — Linear Feet —

No Lines Existing Trench Width — Max Trench Bottom Depth — Gravel Depth —

☐ New System ☐ Repair ☐ Expansion System Type: I II III IV V VI

System Description: Gravity Conventional

Repair System Description: PPBPS

Maintenance Agreement Required: ☐ Yes ☒ No

☒ Gravity ☐ Pressure

☒ House/Mod. Home No. Bedrooms 3

☐ Mobile Home No. Persons —

☐ Business No. Employees —

☐ Other —


Water Supply: ☒ Individual ☐ Public ☐ Community

☐ Slab ☐ Crawl Space ☐ Basement w/plumbing ☐ Basement wo/plumbing


Comments:/Conditions: If Drainage ditch is moved, do not allow runoff water to flow over the drain field

Comments:/Conditions: System in good shape / Keep house 10' from Tank if on a crawl space or 35' if on basement

INITIAL SITE SKETCH * Not to Scale

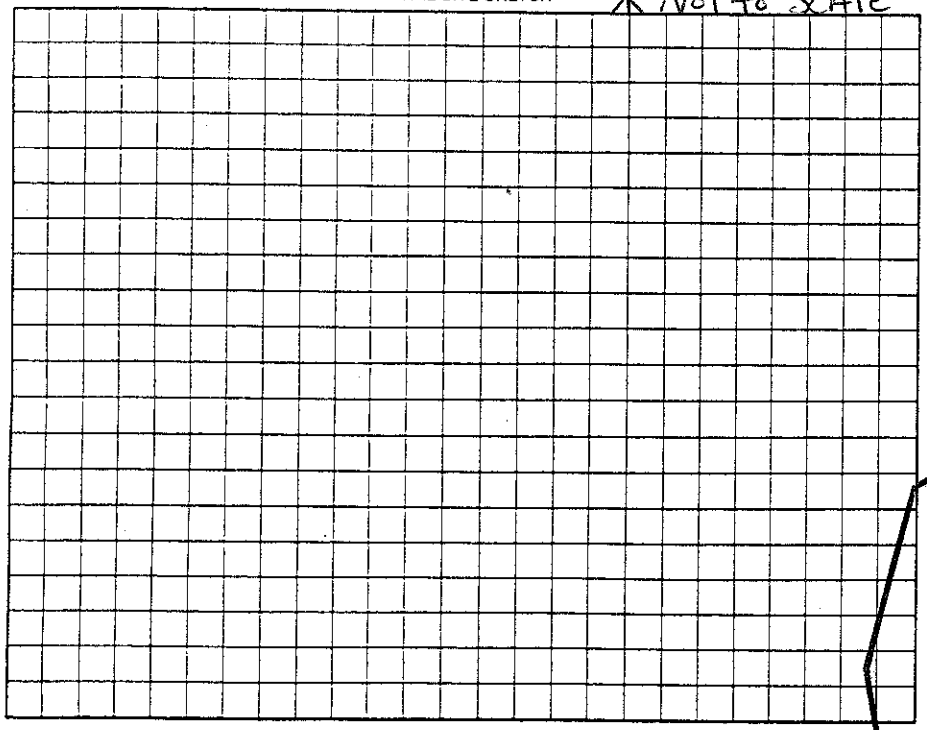

AS BUILT SKETCH

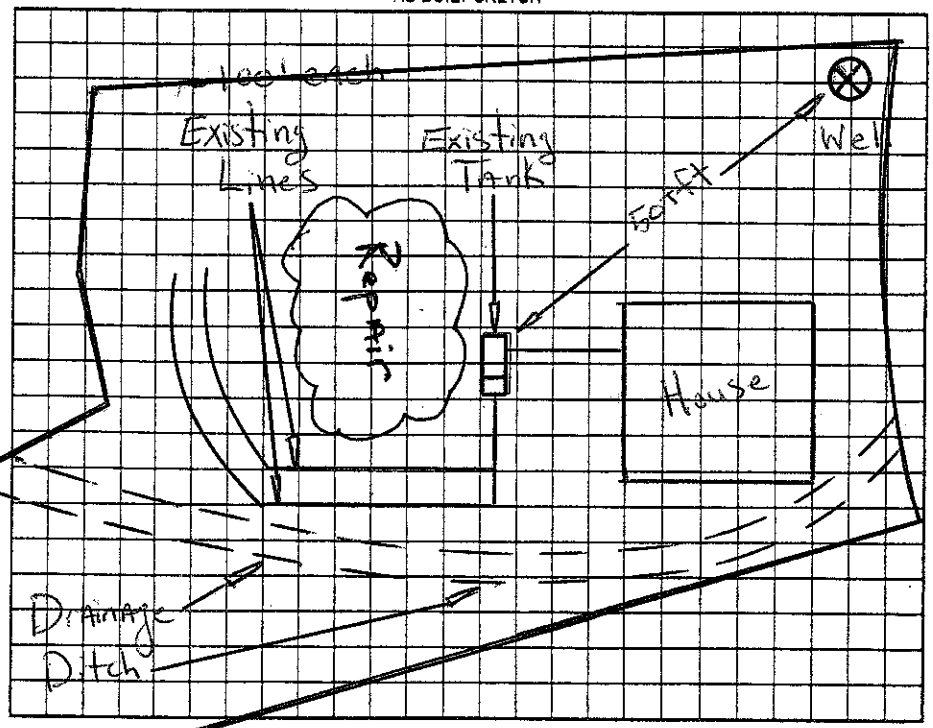

Permit can be suspended or revoked if any false information is supplied toward securing the permit/any unauthorized changes are made to the site/any unauthorized changes are made in the installation of the system. Improvement Permit with plat valid without expiration ☐ Improvement Permit with site plan valid for sixty months ☒ Authorization to Construct is valid for a period equal to that of Improvement Permit – not to exceed sixty months.

Signed: Kesha Cranthum date 2/11/08 Installed by: —

Improvement Permit by: BJ-A BSI date Jan-31-08 Operation Permit by: — date —

Authorization to Construct by: BJ-A BSI date Jan-31-08 Existing System Inspection by: BJ-A date 1-31-08

HEALTH DEPT. COPY: WHITE OWNER COPY (FINAL): YELLOW OWNER COPY (INITIAL): PINK

IREDELL COUNTY HEALTH DEPARTMENT

STATESVILLE 704-878-5305 MOORESVILLE 704-664-5281

IMPROVEMENT PERMIT / CERTIFICATE OF COMPLETION / OPERATION PERMIT / EXISTING SYSTEM INSPECTION

PROPERTY DESCRIPTION NO. 22633 DATE 4/11/96 TAX MAP NO. 2L 2 H 479 Watershed: ☒ Yes ☐ No

OWNER OR CONTRACTOR Ronald Hayward PHONE: Business 875-6308 Home

ADDRESS 11763 Trails End Ln. Huntersville, NC. 28078

LOCATION Mt Kenton Rd. TR Millhouse Ln. on (R) 2ND lot past Wickford Ln.

SUBDIVISION CL+T BLOCK / SECTION 8 LOT 479 LOT AREA .96 Ac SITE CLASS. PS DESIGN FLOW 360 L.T.A.R. —

Septic Tank: Existing Gallons; STB Date

Pump Tank: Gallons; PT Date

Pump Make: Model Serial No.

Nitrification Field: No Fields Square Feet 600 Bed Linear Feet

No Lines Trench Width Existing System Max Trench Bottom Depth Gravel Depth

☐ New System ☐ Repair System Type: I (II) III. IV. V. VI

System Description: Existing System

Repair System Description:

Maintenance Agreement Required: ☐ Yes ☒ No

☐ House/Mod. Home ☒ Mobile Home ☐ Business ☐ Other

No. Bedrooms 3 No. Bathrooms 2 No. Employees

☐ Slab ☐ Crawl Space ☐ Basement w/plumbing ☐ Basement wo/plumbing

Water Supply: ☒ Individual ☐ Community ☐ Public BROTHERS


Comments:

Comments: LN

5'

INITIAL SITE SKETCH

AS BUILT SKETCH

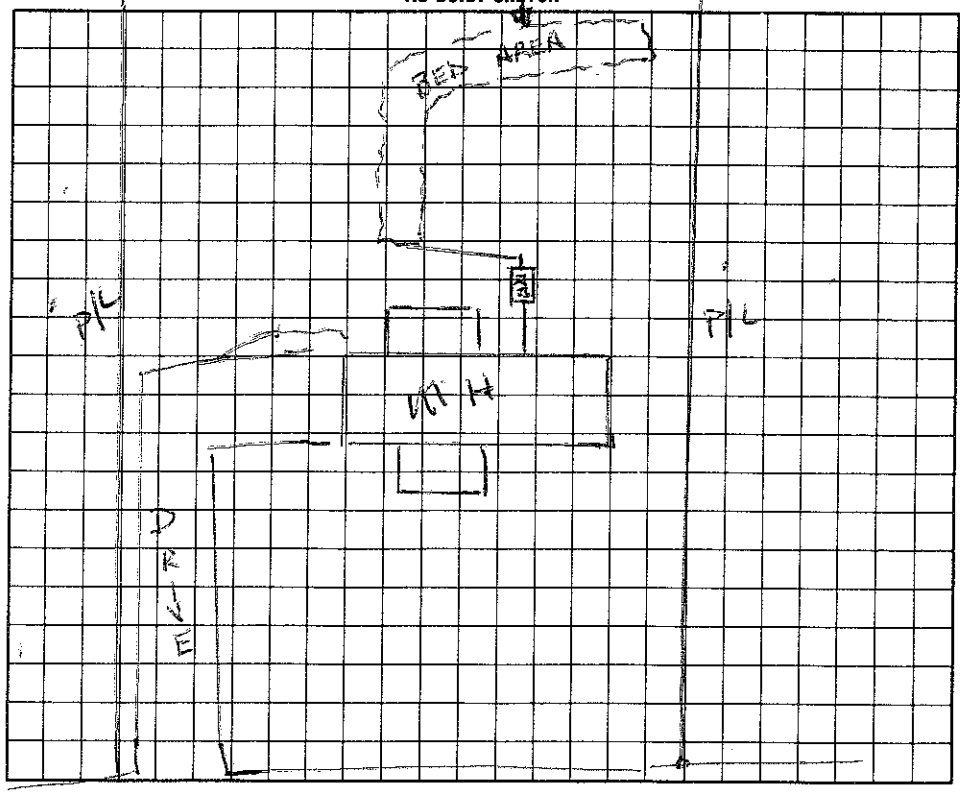

I understand that this permit can be suspended or revoked if any false information is supplied toward securing the permit/any unauthorized changes are made to the site/any unauthorized changes are made in the installation of the system.

Signed:

Improvement Permit by: date

Existing System Inspection by: date

Installed by: MILLHOUSE LN.

Certificate of Completion by: Existing System: Wesley Sparks RS. date

Operation Permit by: date

HEALTH DEPT. COPY: WHITE INSPECTION COPY (FINAL): GREEN OWNER COPY (FINAL): YELLOW INSPECTION COPY (INITIAL): PINK OWNER COPY (INITIAL): GOLD