IREDELL COUNTY HEALTH DEPARTMENT

Paid 250.00

STATESVILLE 704-878-5305 MOORESVILLE 704-664-5281

IMPROVEMENT PERMIT / AUTHORIZATION TO CONSTRUCT / OPERATION PERMIT / EXISTING SYSTEM INSPECTION

PERMIT# D91151 PIN# 4626688389 DATE 9/5/2000

OWNER OR CONTRACTOR Mark Sobiech PHONE: Business (828) 345-5200 Home 660-1308

ADDRESS 193 Fernbrook Dr Mooresville, NC 28117 402 Beechtree Rd.

LOCATION Brawley School Rd TR Beechtree, near end on right

SUBDIVISION CL & TJ BLOCK / SECTION 8 LOT 493 LOT AREA .91 Acre SITE CLASS PS DESIGN FLOW 480 gpd L.T.A.R. .3

Septic Tank: 1000 Gallons; STB ____ Date ____

Pump Tank: EXISTING Gallons; PT ____ Date ____

Pump Make: ____ Model ____ Serial No. ____

Nitrification Field: No Fields 1 Square Feet 1320' Linear Feet 440'

No Lines 4 at 10' Trench Width 36" Max Trench Bottom Depth 36" Gravel Depth N/A

[X] New System [ ] Repair System Type: I, II, III, IV, V, VI

System Description Gravity - 25% Reduction

Repair System Description: Pump - Innovative

Maintenance Agreement Required: [ ] Yes [X] No

[X] House/Mod. Home No. Bedrooms 4

[ ] Mobile Home No. Bathrooms 3

[ ] Business No. Employees ____

[ ] Other ____


[ ] Slab [X] Crawl Space [ ] Basement w/plumbing [ ] Basement wo/plumbing

Water Supply: [X] Individual [ ] Public [ ] Community

Comments:/Conditions: Keep Septic System at least 10' from PL, 50' from any Well & 50' from lake & Neighbor's Well


Scale 1:40

INITIAL SITE SKETCH

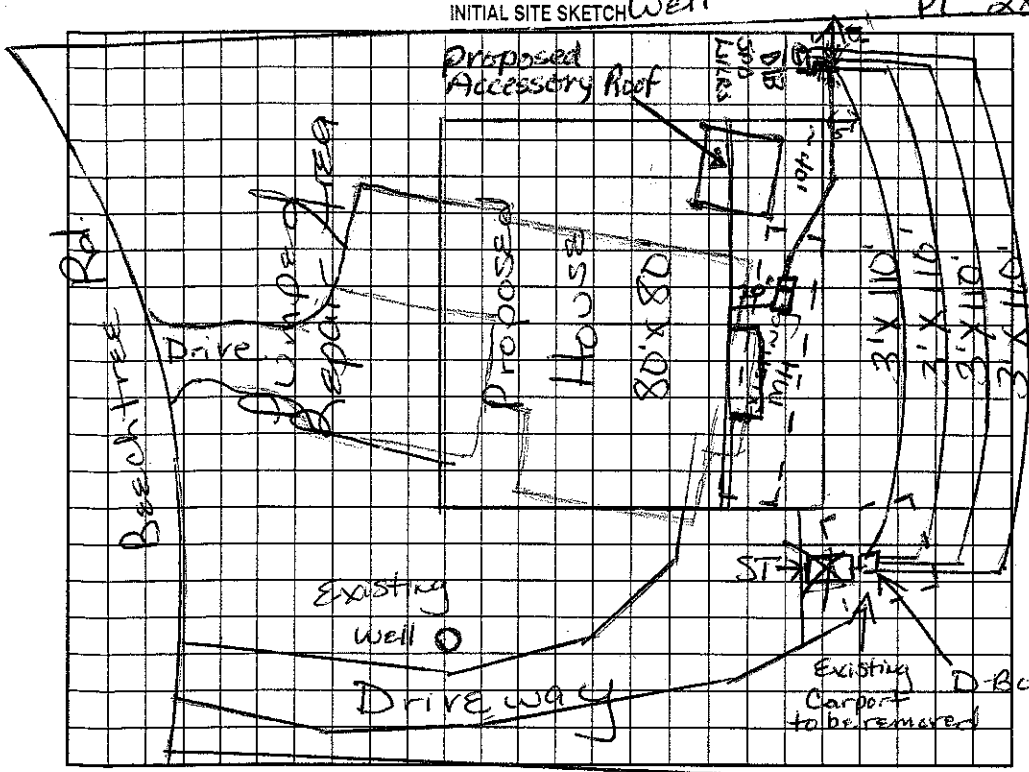

Comments:/Conditions: 7/11/2002 MD Reviewed Building plans & site plan they are in compliance with Septic permit.

AS BUILT SKETCH

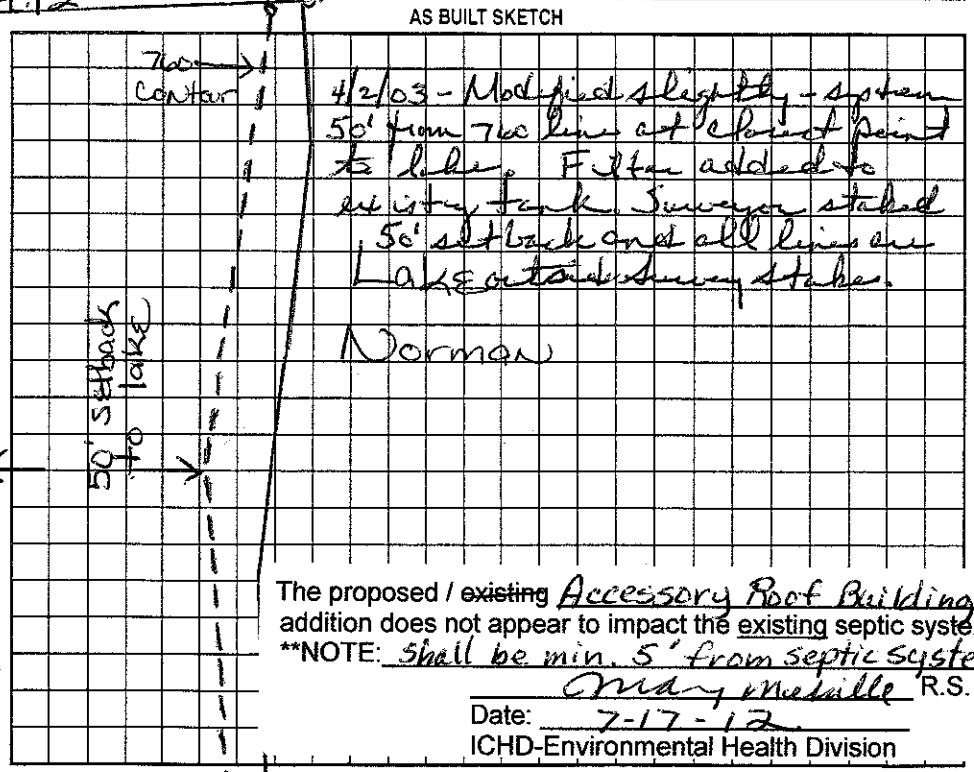

4/2/03 - Modified slightly - system 50' from 700 line at closest point to lake. Filter added to existing tank. Surveyor staked 50' setback and all lines are Lake contour Survey staked.

Norman

The proposed / ~~existing~~ Accessory Roof Building addition does not appear to impact the existing septic system.

**NOTE: Shall be min. 5' from septic system

Mary Meadville R.S.

Date: 7-17-12.

ICHD-Environmental Health Division

Permit can be suspended or revoked if any false information is supplied toward securing the permit/any unauthorized changes are made to the site/any unauthorized changes are made in the installation of the system. Improvement Permit with plat valid without expiration. Improvement Permit with site plan valid for sixty months. Authorization to Construct is valid for a period equal to that of Improvement Permit – not to exceed sixty months.

Signed: ____ date 9-7-00 Installed by: McLeod Const. Co

Improvement Permit by: Maria H. Dotson RS date 9/5/00 Operation Permit by: Wesley Sparks RS. date 4/2/03

Authorization to Construct by: Maria H. Dotson RS date 7/11/2002 Existing System Inspection by: ____ date ____

HEALTH DEPT. COPY: WHITE OWNER COPY (FINAL): YELLOW OWNER COPY (INITIAL): PINK