IREDELL COUNTY HEALTH DEPARTMENT

STATESVILLE 704-878-5305 MOORESVILLE 704-664-5281

IMPROVEMENT PERMIT / AUTHORIZATION TO CONSTRUCT / OPERATION PERMIT / EXISTING SYSTEM INSPECTION

PERMIT # 163209 PIN # 4626-68-9899 DATE 10-18-10

OWNER or APPLICANT JEFF CALHOUN PHONE: Business 704-668-1765 Home:

OWNER or APPLICANT ADDRESS 13751 OLD CAMDEN RD MIDLAND NC 28107

LOCATION / DIRECTIONS BSR, BLUME, BEECHTREE, KINGS CROSS, HILEATH, C END

SUBDIVISION CLET BLOCK / SECTION 8 LOT # 501 LOT AREA .58 AC DESIGN FLOW 240 GPD L.T.A.R. .375

Septic Tank 1000 Gallons: STB Date

Pump Tank Gallons: P T Date

Pump Make Model Serial #

Nitrification Field No Fields 1 No Lines 4 Linear Feet 160'

Trench Width 36" Max. Trench Bottom Depth 36" Gravel Depth —

☒ New System ☐ Repair ☐ Expansion System Type I II III IV V VI

System Description: GRAVITY 25% REDUCTION

Repair System Description: TS II PRETREAT

Maintenance Agreement Required ☐ YES ☒ NO

☒ GRAVITY ☐ PRESSURE

☒ Residence No. Bedrooms 2 ☐ Business No. Persons ☐ Other No. Employees


☐ Slab ☐ Crawl Space ☐ Basement w/plumbing ☒ Basement w/o plumbing

Water Supply: ☒ Private ☐ Public ☐ Community


Comments / Conditions

Comments / Conditions

INITIAL SITE SKETCH

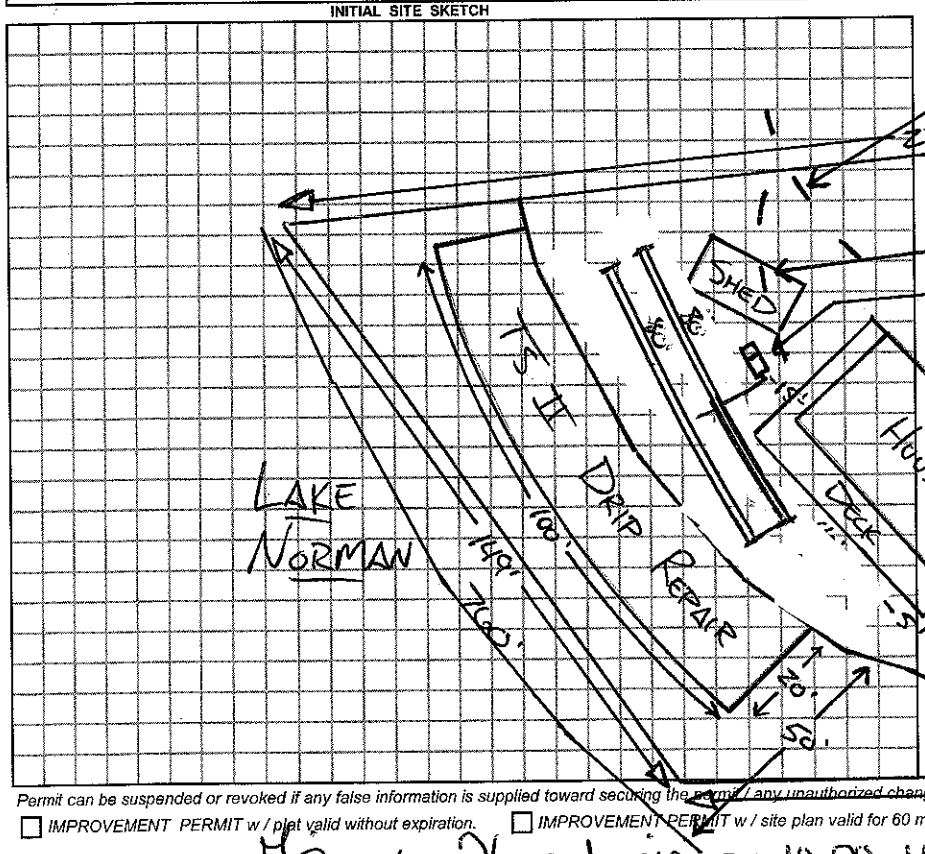

AS BUILT SKETCH

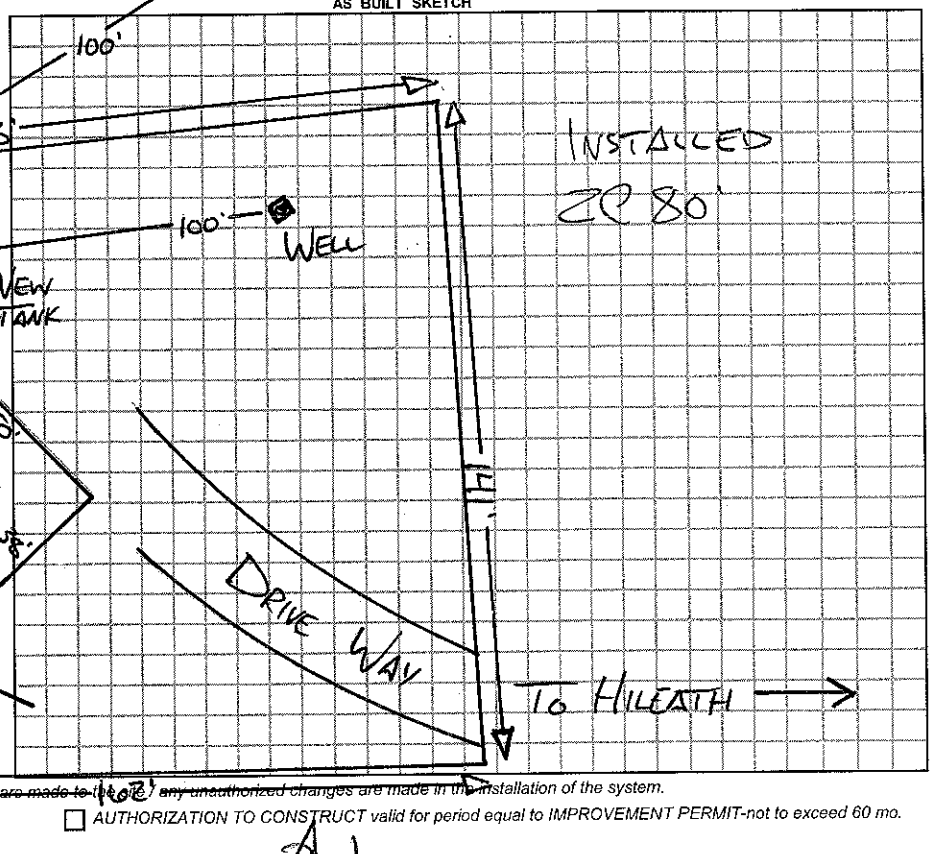

Permit can be suspended or revoked if any false information is supplied toward securing the permit / any unauthorized changes are made to the / any unauthorized changes are made in the installation of the system.

☐ *IMPROVEMENT PERMIT w / plat valid without expiration.* ☐ *IMPROVEMENT PERMIT w / site plan valid for 60 mos.* ☐ *AUTHORIZATION TO CONSTRUCT valid for period equal to IMPROVEMENT PERMIT-not to exceed 60 mo.*

Owner / Applicant Signature: Jeffrey Calhoun Date 10-20-10 Installed by:

Improvement Permit by: REHS Date 10-19-10 Operation Permit by: REHS Date:

Authorzation to Construct by: REHS Date 10-19-10 Existing System Inspected by: Date:

YOU SHOULD CONTACT A LOCATOR SERVICE PRIOR TO ANY EXCAVATION.

WHITE COPY Environmental Health YELLOW COPY (Final) Owner / Applicant PINK COPY (Initial) Owner / Applicant