IREDELL COUNTY HEALTH DEPARTMENT - *ENVIRONMENTAL HEALTH* ☐ STATESVILLE OFFICE 704-878-5305 ☒ MOORESVILLE OFFICE 704-664-5281

IMPROVEMENT PERMIT / AUTHORIZATION TO CONSTRUCT / OPERATION PERMIT / EXISTING SYSTEM INSPECTION

PERMIT # 139359 PIN # 4626-69-0751 DATE 9-14-11

OWNER CRAIG CARTER BUILDERS APPLICANT: SAME PHONE: Home/Cell # 336-940-2341 Business #

SITE ADDRESS 708 GRASSHOPPER CR OWNER / APPLICANT ADDRESS 157 YADKIN VALLEY RD ADVANCE, NC 27006

SITE DIRECTIONS BSR, MCKENDREE, GRASSHOPPER, TAKE LEFT, ON R

SUBDIVISION THE FARMS BLOCK / SECTION 5 LOT # 596 LOT AREA .84AC DESIGN FLOW 480 L.T.A.R. .3

Septic Tank 1500 Gallons: STB 444 Date 1-21-12 ☒ New System ☐ Repair ☐ Expansion System Type I II (III) IV V VI

Pump Tank Gallons: P T Date System Description: 25% RED.

Pump Make Model Serial # Repair System Description: 25% RED

No. Nitrification Fields: 1 No. Lines 5 Linear Feet 400' Maintenance Agreement Required ☐ YES ☒ NO


Trench Width 36" Max. Trench Bottom Depth 36" Gravel Depth — ☒ GRAVITY ☐ PRESSURE

☒ Residence No. Bedrooms 4 ☐ Business No. Persons ☐ Other No. Employees ☐ Slab ☒ Crawl Space ☐ Basement w/plumbing ☐ Basement w/o plumbing


Water Supply: ☐ Private ☐ Public ☒ Community

Comments / Conditions ① FOLLOW STATE RULES

INITIAL SITE SKETCH

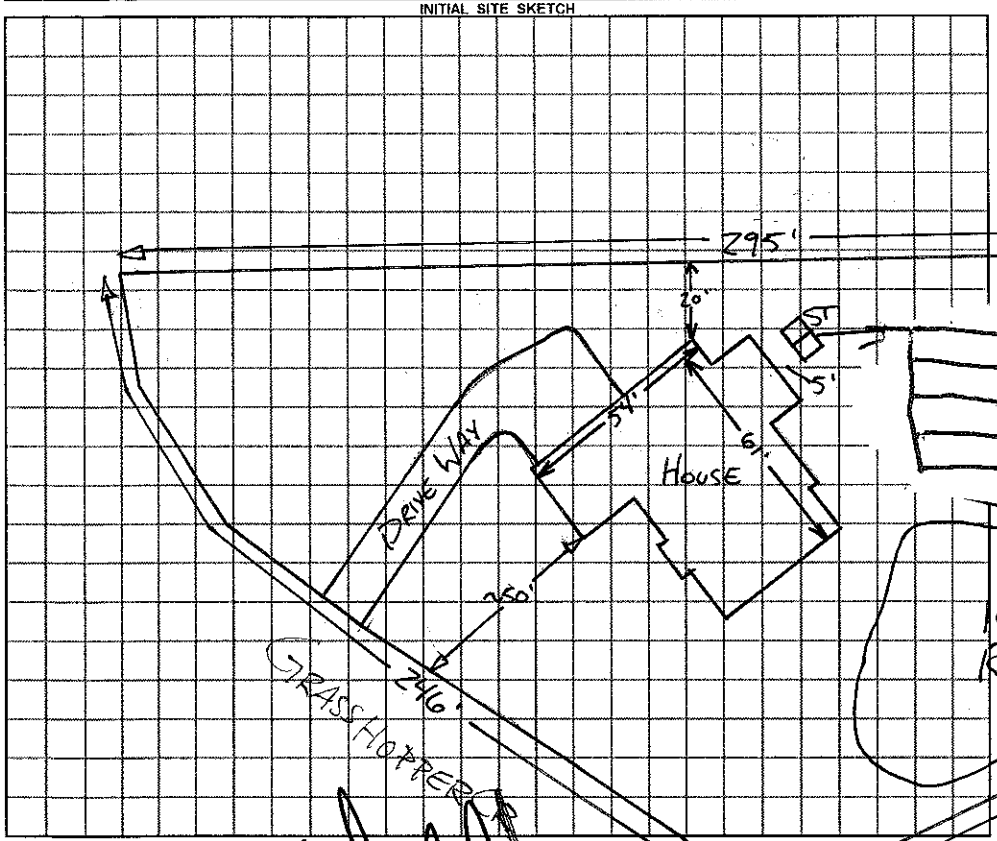

AS BUILT SKETCH

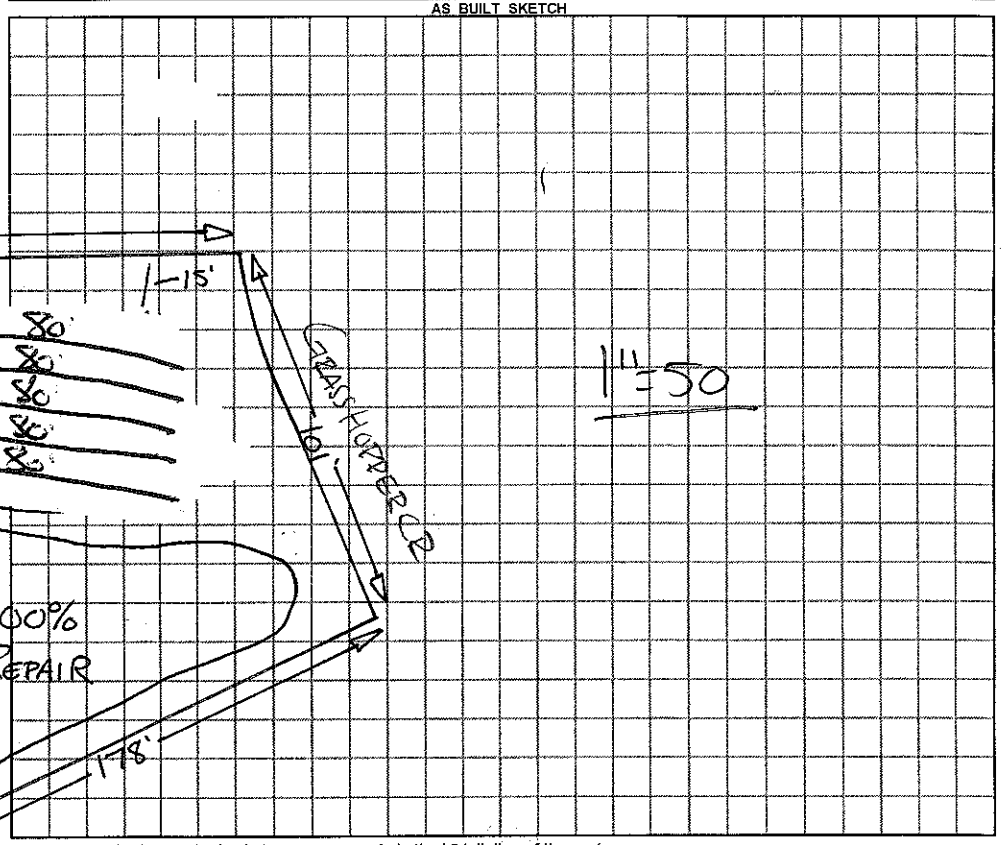

Permit can be suspended or revoked if any false information is supplied toward securing the permit / any unauthorized changes are made to the site / any unauthorized changes are made in the installation of the system.

☐ ***IMPROVEMENT PERMIT*** with plat valid without expiration. ☐ ***IMPROVEMENT PERMIT*** with plat valid without expiration. Site plan valid 60 mo. ☒ ***AUTHORIZATION TO CONSTRUCT*** valid for period equal to IMPROVEMENT PERMIT–not to exceed 60 mo.

Owner / Applicant Signature: Date 9-19-11 Installed by: ARSENATTY

IMPROVEMENT PERMIT by: REHS Date 9-14-11 OPERATION PERMIT by: REHS Date 3-6-12

AUTHORIZATION TO CONSTRUCT by: REHS Date 9-14-11 Existing System Inspected by: REHS Date

YOU SHOULD CONTACT A LOCATOR SERVICE PRIOR TO ANY EXCAVATION

White Copy – Environmental Health YELLOW COPY (Final) Owner / Applicant PINK COPY (Initial) Owner / Applicant