IREDELL COUNTY HEALTH DEPARTMENT

Statesville Phone TR 3-7271 Mooresville Phone NO 3-1271

PERMIT TO INSTALL SEPTIC TANK

Permit NO. _____ Permit Date 28 Sept 1970

Owner K. H. Deese Address Charlotte

Installed By " " Address " "


Location of Property Sect 8 467

Tank		Capacity		Length of Lines		Fixtures	
Block	(X)	1000	( )	225'	( )	No. of Baths	( )
Precast	( )	1250	( )	250'	(X)	Dishwasher	( )
		1500	( )	Other _____		Garbage Grdr.	( )
		Other 1800				Other _____	

NOTIFY HEALTH DEPARTMENT AT LEAST EIGHT HOURS BEFORE TANK IS TO BE INSPECTED.

Final Inspection 28 Sept 1970 Approved (X) Disapproved ( )

Remarks _____

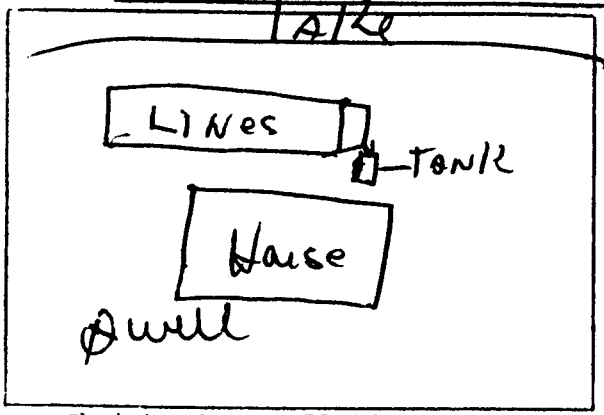

Sketch of Installation

Ivy Sergent

Sanitarian