AUTHORIZATION TO CONSTRUCT 4626694024

IREDELL COUNTY HEALTH DEPARTMENT

STATESVILLE 704-878-5305 MOORESVILLE 704-664-5281

IMPROVEMENT PERMIT / ~~CERTIFICATE OF COMPLETION~~ / OPERATION PERMIT / EXISTING SYSTEM INSPECTION

PROPERTY DESCRIPTION NO. 25048 DATE 4/22/97 TAX MAP NO. 2L-2-A-468 Watershed: ☑ Yes ☐ No

OWNER OR CONTRACTOR JOHN SAUNDERS PHONE: Business _____ Home 664-6338

ADDRESS 119 SHADOW LN MOORESVILLE NC 28115

LOCATION BRAWLEY SCHOOL RD - TR McKENDREE - TR GRASSHOPPER - TR SHADOW LN - AT END

SUBDIVISION CLT BLOCK / SECTION 3 LOT 465 LOT AREA _____ SITE CLASS. PS DESIGN FLOW 450 GPD L.T.A.R. 600 ft²

Septic Tank: EXISTING Gallons; STB _____ Date _____

Pump Tank: _____ Gallons; PT _____ Date _____

Pump Make: _____ Model _____ Serial No. _____

Nitrification Field: No Fields 1 Square Feet 240 Linear Feet 120

No Lines 2@60' Trench Width 24" Max Trench Bottom Depth 36" Gravel Depth N/A

☑ New System ☐ Repair System Type: I, II, (III) IV, V, VI

System Description: GRAVITY PANEL

Repair System Description: SAME

Maintenance Agreement Required: ☐ Yes ☑ No

☐ House/Mod. Home ☑ Mobile Home ☐ Business ☐ Other

No. Bedrooms 4 No. Bathrooms 2 No. Employees ____


☐ Slab ☑ Crawl Space ☐ Basement w/plumbing ☐ Basement wo/plumbing

Water Supply: ☑ Individual ☐ Community ☐ Public


Comments:

Comments:

INITIAL SITE SKETCH

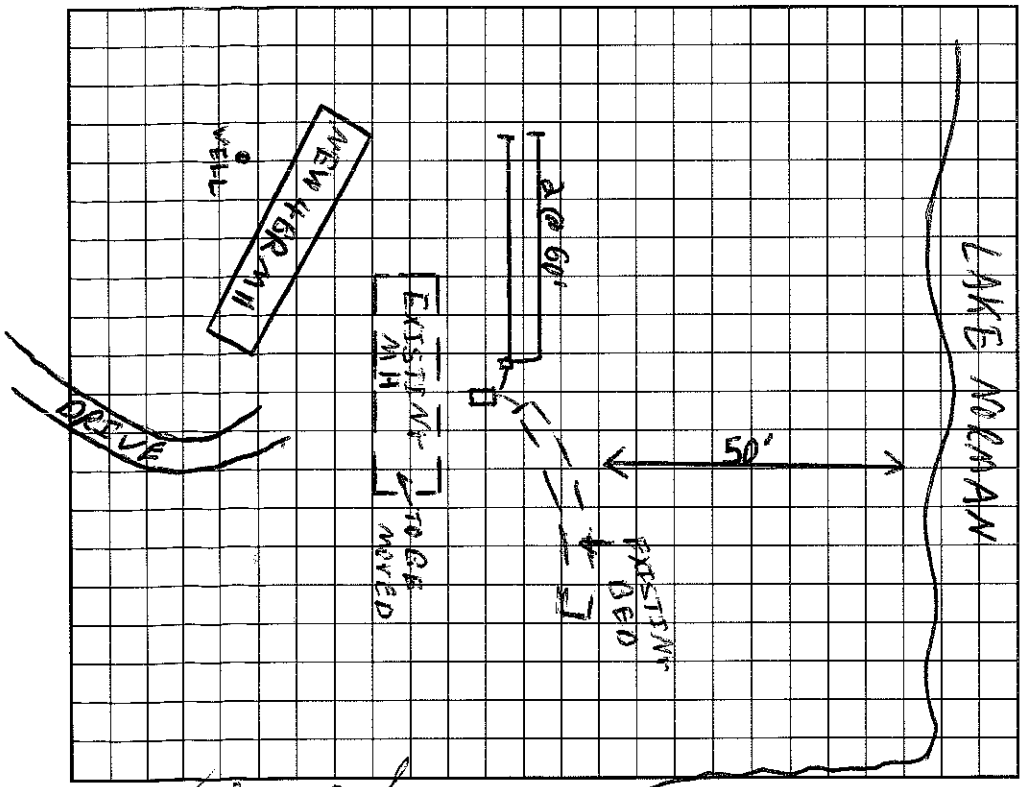

AS BUILT SKETCH

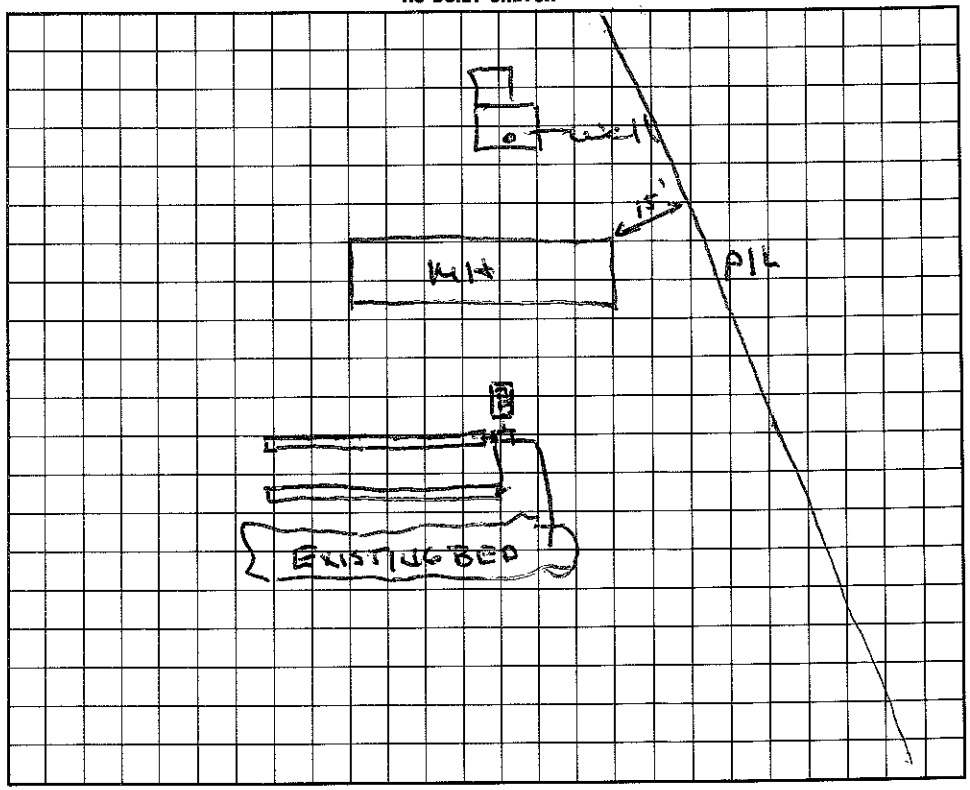

I understand that this permit can be suspended or revoked if any false information is supplied toward securing the permit/any unauthorized changes are made to the site/any unauthorized changes are made in the installation of the system. Improvement Permit is valid for 60 months from date of issuance.

Signed: John C. Saunders

Improvement Permit by: C. Ray Tran date 4/22/97

Existing System Inspection by: AUTHORIZATION TO CONSTRUCT C. Ray Tran date 4/22/97

Installed by: Julian Bowles

Certificate of Completion by: Wesley Sparks R.S. date 9/23/97

Operation Permit by: Wesley Sparks R.S. date 9/23/97

HEALTH DEPT. COPY: WHITE INSPECTION COPY (FINAL): GREEN OWNER COPY (FINAL): YELLOW INSPECTION COPY (INITIAL): PINK OWNER COPY (INITIAL): GOLD