IREDELL COUNTY HEALTH DEPARTMENT

STATESVILLE 704-878-5305 MOORESVILLE 704-664-5281

IMPROVEMENT PERMIT / AUTHORIZATION TO CONSTRUCT / OPERATION PERMIT / EXISTING SYSTEM INSPECTION

100.00 Paid

PERMIT# 133876 PIN# 4626701167 Toney DATE 3/2/06

OWNER OR APPLICANT Augusta Homes / Same PHONE: Business 892-7795 Home 704 582-19219

ADDRESS 10602 Bailey Rd - B Cornelius NC

LOCATION Brawley School Rd TR Marston Mill Rd TR Tuckercuck Dr. TR Well Fleet attend

SUBDIVISION The Point BLOCK / SECTION ph4 LOT 397 LOT AREA 1.09 Acre SITE CLASS. RS DESIGN FLOW 480gpd L.T.A.R. .3

Septic Tank: 1000+ Gallons; STB 444 Date 6-11-06
Pump Tank: 1000 Gallons; PT 27 Date 6-17-06
Pump Make: Myers Model P Serial No.
Nitrification Field: No Fields 1 Square Feet Linear Feet 400
No Lines 4@100 Trench Width 36" Max Trench Bottom Depth 36"

☒ New System ☐ Repair ☐ Expansion System Type: I II (III) IV V VI ☒ Offsite
System Description: Pump-PM-25% Reduction
Repair System Description: Same
Maintenance Agreement Required: ☐ Yes ☒ No
Gravel Depth ☐ Gravity ☒ Pressure


☒ House/Mod. Home ☐ Mobile Home ☐ Business ☐ Other
No. Bedrooms 4 No. Persons 4 No. Employees

Water Supply: ☐ Individual ☐ Public ☒ Community

☐ Slab ☐ Crawl Space ☐ Basement w/plumbing ☐ Basement wo/plumbing


Comments:/Conditions: Remove all terraces & berms
*Keep any future pool at least 15' from tanks & 10ft from Supply line.
Note: PM was marked 398.0 time of inspection

INITIAL SITE SKETCH

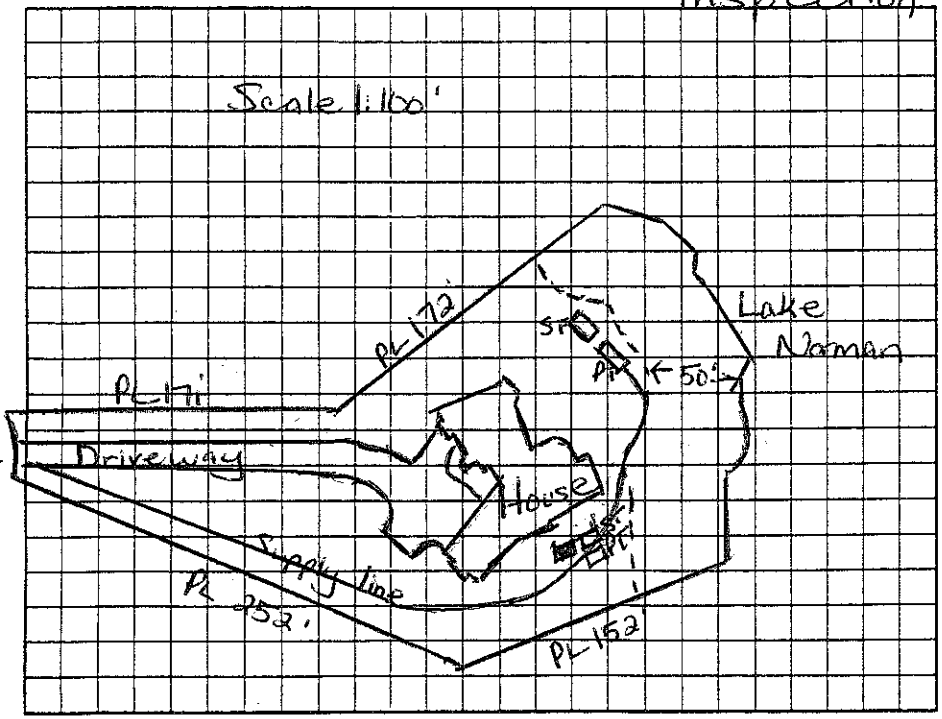

Comments:/Conditions: Note: Offsite Easement located Off Bay Harbor Rd (See attachments)
Tanks Checked 9/19/06
EZ Flow installed 4/15/07

AS BUILT SKETCH

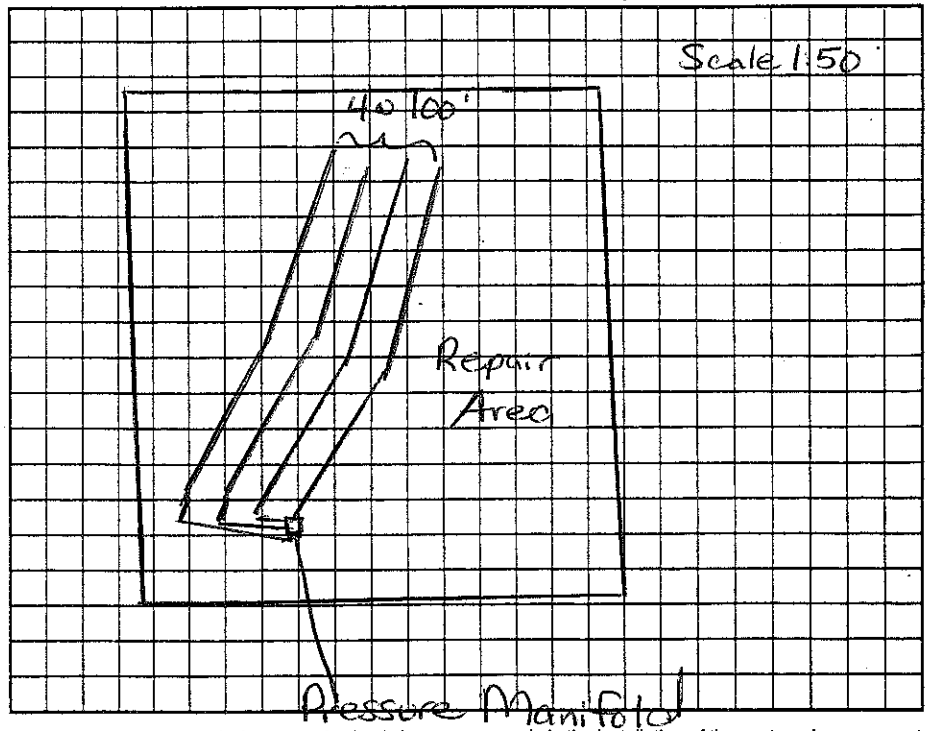

Permit can be suspended or revoked if any false information is supplied toward securing the permit/any unauthorized changes are made to the site/any unauthorized changes are made in the installation of the system. Improvement Permit with plat valid without expiration ☐ Improvement Permit with site plan valid for sixty months ☐ Authorization to Construct is valid for a period equal to that of Improvement Permit – not to exceed sixty months.

Signed: [signature] date 3-3-06
Improvement Permit by: Maria H. Dotson RS date 3/2/06
Authorization to Construct by: Maria H. Dotson RS date 3/2/06

Installed by: R & H
Operation Permit by: Maria H. Dotson RS date 8/30/07
Existing System Inspection by: date

HEALTH DEPT. COPY: WHITE OWNER COPY (FINAL): YELLOW OWNER COPY (INITIAL): PINK