IREDELL COUNTY HEALTH DEPARTMENT

STATESVILLE 704-878-5305 MOORESVILLE 704-664-5281

IMPROVEMENT PERMIT / AUTHORIZATION TO CONSTRUCT / OPERATION PERMIT / EXISTING SYSTEM INSPECTION

13837 3180

PERMIT# ~~9[illegible]~~ PIN# 4625941684 PT 4626-70-5220 DATE 12/29/99

OWNER OR CONTRACTOR CRESCENT RESOURCES/BEALER HOMES PHONE: Business 663-6905 Home

ADDRESS PO BOX 1003 CHARLOTTE NC 28202

LOCATION BRAWLEY SCHOOL RD-TR MARSTONS MILL-TR WHITE HORSE-TR TUCKERAUCK-TR WELLFLEET-EN

SUBDIVISION POINTE BLOCK / SECTION 4 LOT 395 LOT AREA .4845 SITE CLASS. PS DESIGN FLOW 480 L.T.A.R. .3901/ha

Septic Tank: 1000+ Gallons; STB 3387 Date 4-9-06

Pump Tank: 1000+ Gallons; PT 2883 Date 5-23-06

Pump Make: Myers Model ME 50 Serial No.

Nitrification Field: No Fields 1 Square Feet 480 Linear Feet 300

No Lines 4 @ 75' Trench Width 36" Max Trench Bottom Depth 36" Gravel Depth N/A

☑ New System ☐ Repair System Type: I, II, III, IV, V, VI

System Description: PUMP PANEL

Repair System Description: SAME

Maintenance Agreement Required: ☑ Yes ☐ No

☑ House/Mod. Home No. Bedrooms 4

☐ Mobile Home No. Bathrooms 4

☐ Business No. Employees

☐ Other

☐ Slab ☑ Crawl Space ☐ Basement w/plumbing ☐ Basement wo/plumbing

Water Supply: ☐ Individual ☐ Public ☑ Community


Comments:/Conditions:

GRADE OUT OLD TERRACES AND BERMS


Comments:/Conditions: Checked tanks & lines 7/19/06

Pres, elect & alarm 8/2/06

1"=50' INITIAL SITE SKETCH

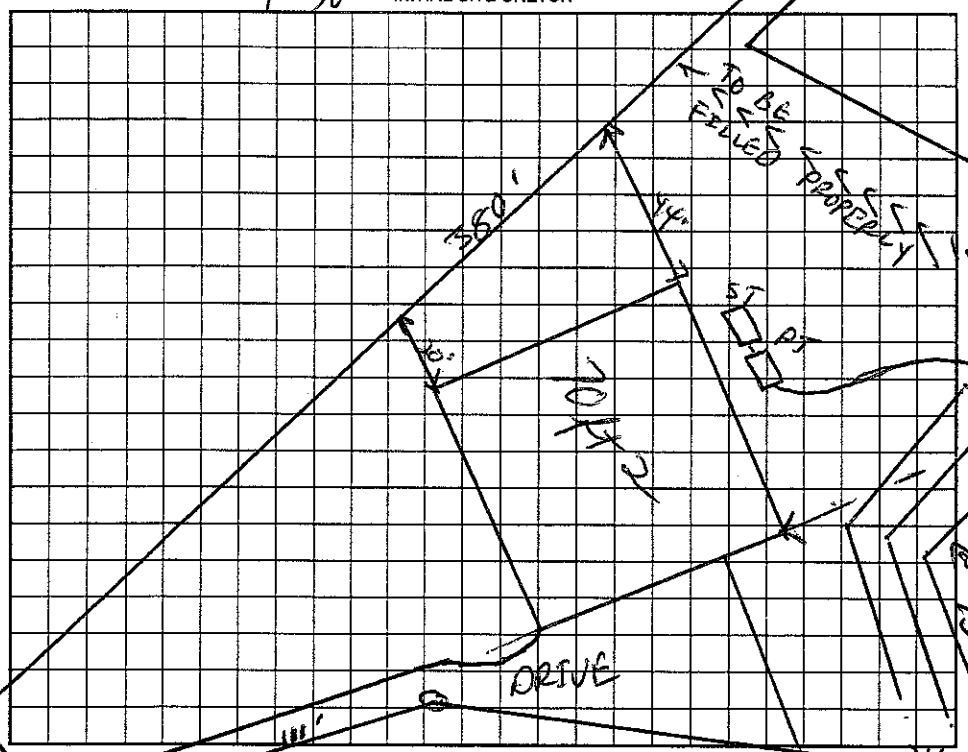

AS BUILT SKETCH

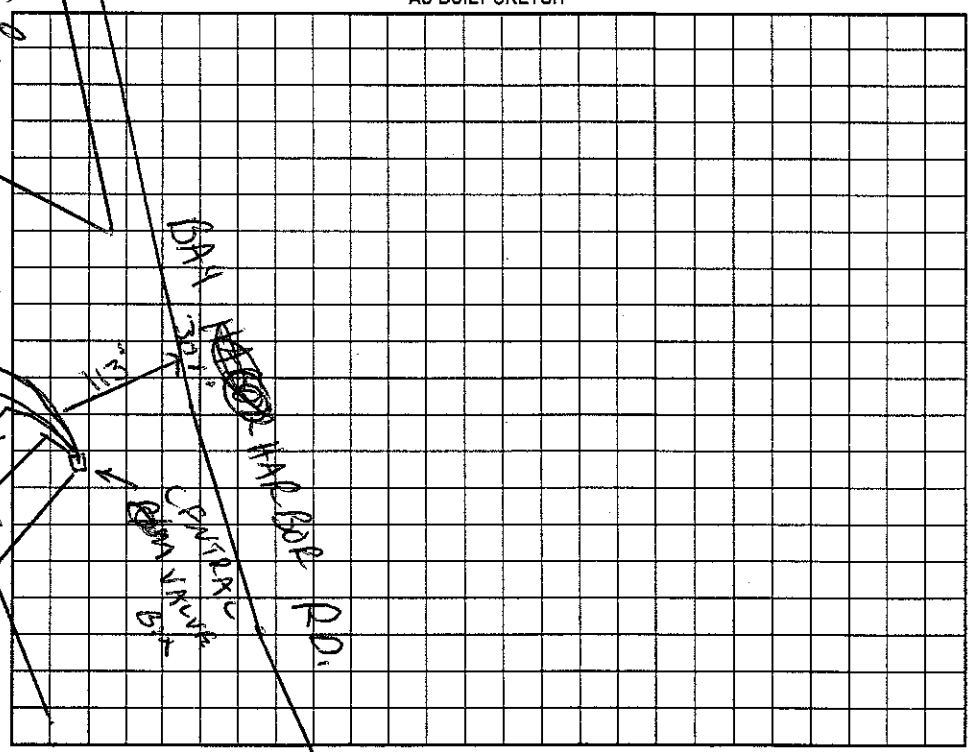

Permit can be suspended or revoked if any false information is supplied toward securing the permit/any unauthorized changes are made to the site/any unauthorized changes are made in the installation of the system. Improvement Permit with plat valid without expiration. Improvement Permit with site plan valid for sixty months. Authorization to Construct is valid for a period equal to that of Improvement Permit – not to exceed sixty months.

Signed: Paul C. Pinyan date 1-27-00 Installed by: R&H

Improvement Permit by: C. Bobby Pinyan RS date 12/29/99 Operation Permit by: Marvin Hall Dolan RS date 8/2/06

Authorization to Construct by: Wesley Sparks RS date 10/7/05 Existing System Inspection by: date

HEALTH DEPT. COPY: WHITE OWNER COPY (FINAL): YELLOW OWNER COPY (INITIAL): PINK