IREDELL COUNTY HEALTH DEPARTMENT

STATESVILLE 704-878-5305 MOORESVILLE 704-664-5281

IMPROVEMENT PERMIT / AUTHORIZATION TO CONSTRUCT / OPERATION PERMIT / EXISTING SYSTEM INSPECTION

PERMIT# 8192 PIN# 4625 94 1684 PT DATE 12/29/99

OWNER OR CONTRACTOR CRESCENT RESOURCES PHONE: Business 663-6905 Home

ADDRESS PO Box 1003 CHARLOTTE NC 28202

LOCATION BRAWLEY SCHOOL - TR MARSTONS MILLS - TR WHITE HORSE - TR TUCKERMUCK - TR WELLFLEET AT END

SUBDIVISION POINTE BLOCK / SECTION 4 LOT 394 LOT AREA .74 125 SITE CLASS. PS DESIGN FLOW 480 L.T.A.R. ~.39 lpm

Septic Tank: 1000 T Gallons; STB Date

Pump Tank: 1000 T Gallons; PT Date

Pump Make: Model Serial No.

Nitrification Field: No Fields 1 Square Feet ~1600 Linear Feet 535

No Lines 5 @ 107' Trench Width 36" Max Trench Bottom Depth 36" Gravel Depth 12"

☑ New System ☐ Repair System Type: I, II, III, IV, V, VI

System Description: GRAVITY CONVENTIONAL

Repair System Description: GRAVITY / PUMP 25%

Maintenance Agreement Required: ☐ Yes ☑ No REDUCTION

☑ House/Mod. Home No. Bedrooms 4

☐ Mobile Home No. Bathrooms 4

☐ Business No. Employees

☐ Other


☐ Slab ☑ Crawl Space ☐ Basement w/plumbing ☐ Basement wo/plumbing

Water Supply: ☐ Individual ☐ Public ☑ Community


Comments:/Conditions: REMOVE OLD TERRACES AND BERMS

Comments:/Conditions:

INITIAL SITE SKETCH

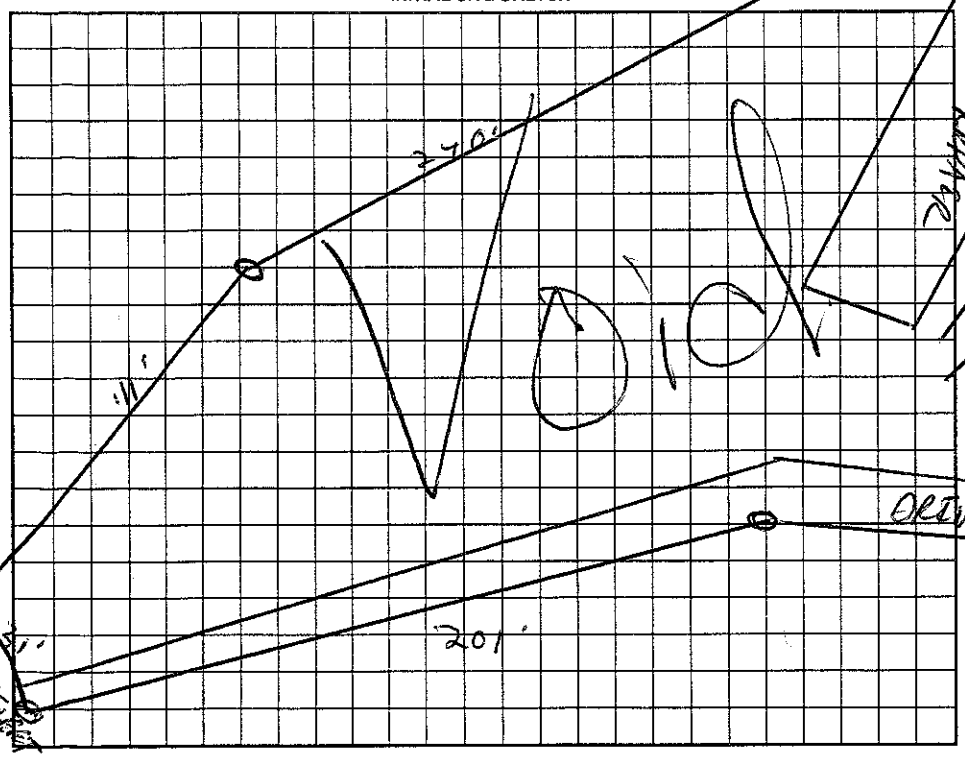

AS BUILT SKETCH

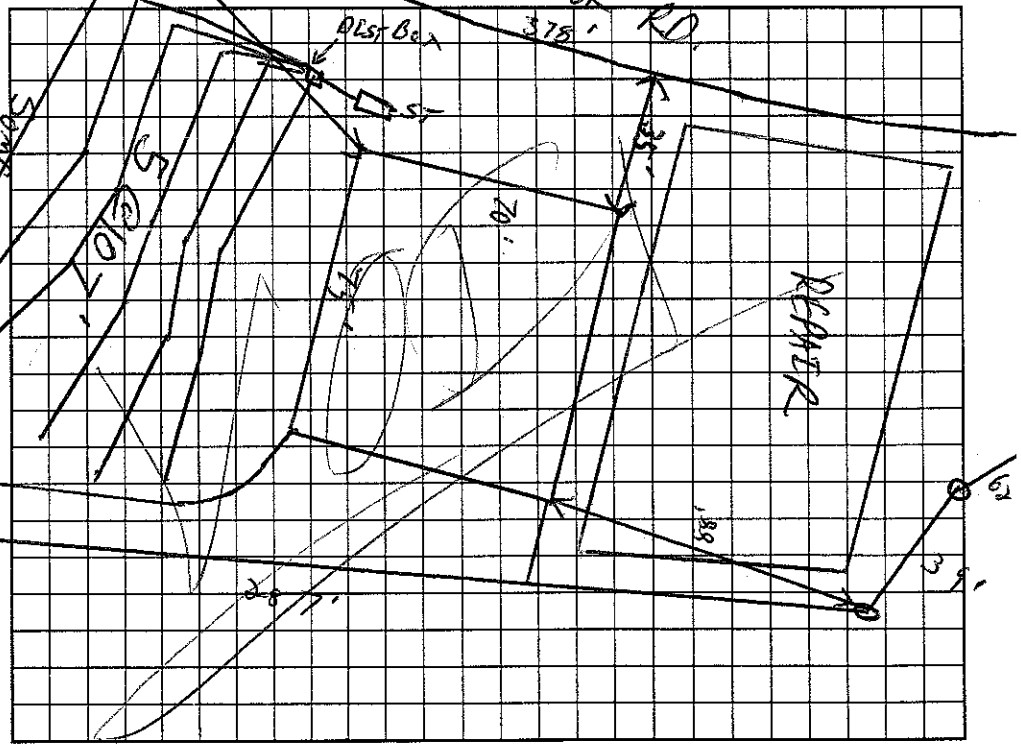

Permit can be suspended or revoked if any false information is supplied toward securing the permit/any unauthorized changes are made to the site/any unauthorized changes are made in the installation of the system. Improvement Permit with plat valid without expiration. Improvement Permit with site plan valid for sixty months. Authorization to Construct is valid for a period equal to that of Improvement Permit – not to exceed sixty months.

Signed: _____ date 1-21-00 Installed by: _____

Improvement Permit by: _____ RS date 12/29/99 Operation Permit by: _____ date _____

Authorization to Construct by: _____ RS date 6/24/04 Existing System Inspection by: _____ date _____

HEALTH DEPT. COPY: WHITE OWNER COPY (FINAL): YELLOW OWNER COPY (INITIAL): PINK