IREDELL COUNTY HEALTH DEPARTMENT

TATESVILLE 704-878 130.00 Pd 9 MOORESVILLE 704-664-5281 3.00

IMPROVEMENT PERMIT / AUTHORIZATION TO CONSTRUCT / OPERATE PERMIT / EXISTING SYSTEM INSPECTION

PERMIT# 081912 PIN# 4625-94-1684 AT 4626-70-6170 DATE 4/13/05

OWNER OR CONTRACTOR Simonini Bldrs PHONE: Business 704 358-9940 Home

ADDRESS 817 E. Morehead St. Charlotte NC

LOCATION BSR, TR Marstons M-11, TR White House, TR Tuckernuck, TR Wellfleet At End

SUBDIVISION Point BLOCK / SECTION 4 LOT 394 LOT AREA 7425 ft² SITE CLASS. PS DESIGN FLOW 480 L.T.A.R. 0.3

Septic Tank: 1000 Gallons; STB 338 Date 4-5-05

Pump Tank: ~~1000~~ Gallons; PT Date

Pump Make: Model Serial No.

Nitrification Field: No Fields 1 Square Feet 1700 Linear Feet 400

No Lines 4@100' Trench Width 36" Max Trench Bottom Depth 36" Gravel Depth —

☒ New System ☐ Repair System Type: I, II, III, IV, V, VI

System Description: Gravity 25% Reduct.

Repair System Description: Pump 25% Reduct.

Maintenance Agreement Required: ☐ Yes ☒ No

☒ House/Mod. Home No. Bedrooms 4

☐ Mobile Home No. Bathrooms

☐ Business No. Employees

☐ Other

☐ Slab ☒ Crawl Space ☐ Basement w/plumbing ☐ Basement wo/plumbing


Water Supply: ☐ Individual ☐ Public ☒ Community

Comments/Conditions:


1"=50'

Comments/Conditions: Installed 5 lines EZ Flow

INITIAL SITE SKETCH

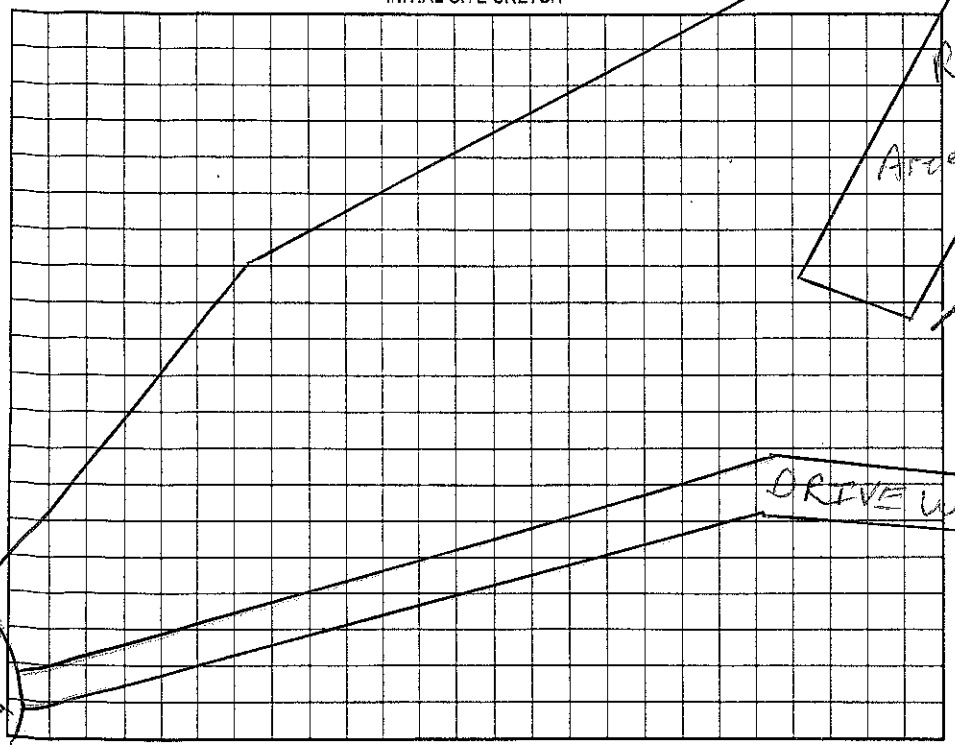

AS BUILT SKETCH

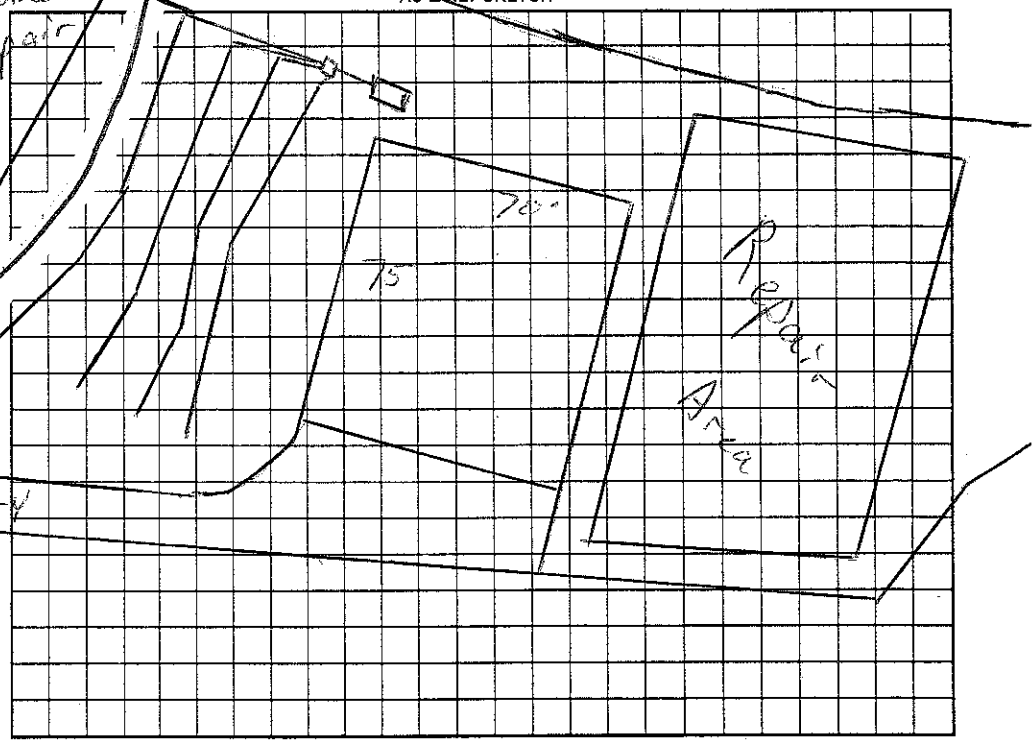

Permit can be suspended or revoked if any false information is supplied toward securing the permit/any unauthorized changes are made to the site/any unauthorized changes are made in the installation of the system. Improvement Permit with plat valid without expiration. Improvement Permit with site plan valid for sixty months. Authorization to Construct is valid for a period equal to that of Improvement Permit – not to exceed sixty months.

Signed: date 4.19.05 Installed by: R&H RS.

Improvement Permit by: RS date 4/13/05 Operation Permit by: Maria H Dotson date 5/13/05

Authorization to Construct by: RS date 4/13/05 Existing System Inspection by: date

HEALTH DEPT. COPY: WHITE OWNER COPY (FINAL): YELLOW OWNER COPY (INITIAL): PINK