IREDELL COUNTY HEALTH DEPARTMENT

STATESVILLE 704-878-5305 MOORESVILLE 704-664-5281

IMPROVEMENT PERMIT / AUTHORIZATION TO CONSTRUCT / OPERATION PERMIT / EXISTING SYSTEM INSPECTION

PERMIT# 078666 PIN# 4625941684 (pt.) 4626 71 8649 DATE June 10, '99

OWNER OR CONTRACTOR Crescent Resources Inc. If The Point or Nelson / Hughes Hamlick / Tanner PHONE: Business 660-1185 Home

ADDRESS 2214 Brawley School Rd. Mooresville, NC

LOCATION Brawley School Rd To Great Point Drive To Wild Harbor Rd. on left

SUBDIVISION The Point BLOCK / SECTION III LOT 358 LOT AREA 55,304 sq ft SITE CLASS PS DESIGN FLOW 480 gpd L.T.A.R. .3

Septic Tank: 1000 f Gallons; STB 338 Date 5-11-02

Pump Tank: 1000 Gallons; PT 283 Date 4-30-02

Pump Make Meyers Model ME 5059 Serial No. 11101

Nitrification Field: No fields 1 Square Feet 1200 Linear Feet 400

No Lines 4@100' Trench Width 36" Max Trench Bottom Depth 36"

☑ New System ☐ Repair System Type: I, II, III, IV, V, VI

System Description: 4M-Innovative-25% Red.

Repair System Description: LP Panel Block

Maintenance Agreement Required: ☐ Yes ☑ No

Gravel Depth N/A

☑ House/Mod. Home ☐ Mobile Home ☐ Business ☐ Other

No. Bedrooms 4 No. Bathrooms 4 No. Employees

Water Supply: ☐ Individual ~~☐ Public~~ ☐ Community

☐ Slab ☑ Crawl Space ☐ Basement w/plumbing ☐ Basement wo/plumbing

Comments:/Conditions:


~~X~~ ONE INSPECTION PORT PER LATERAL

(TOOK OUT SHOWER AND MADE CLOSET BESIDE EXERCISE ROOM) 2/1/02 CBF

Sch 80 pvc

1"=50'


INITIAL SITE SKETCH

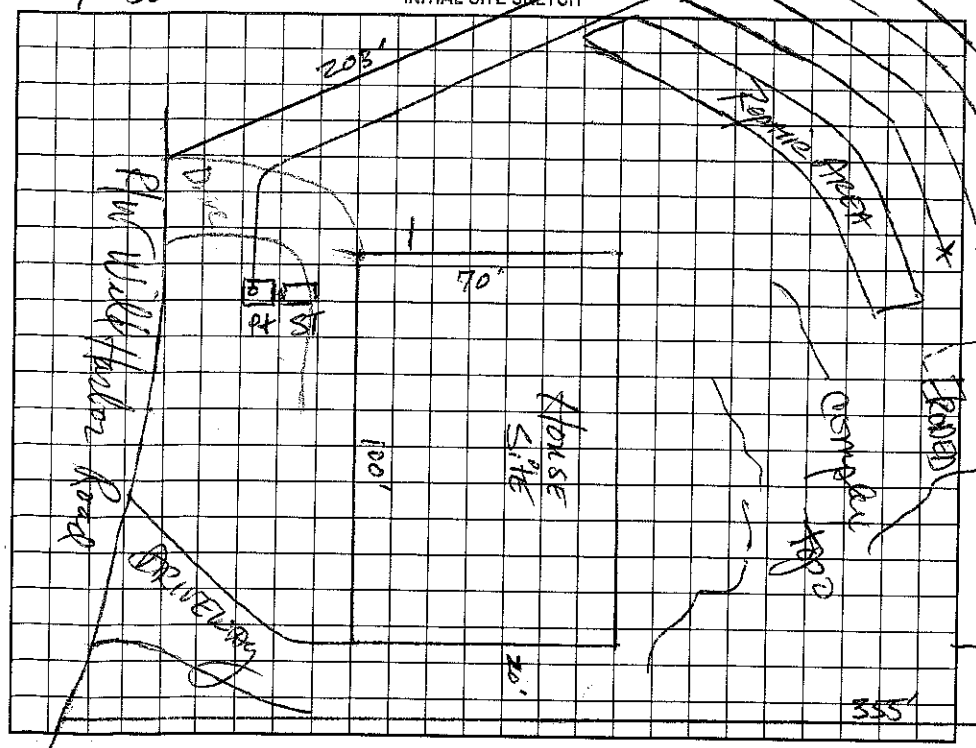

Comments:/Conditions: Tanks & lines checked 6/13/02. mg

Elect., pressure & alarm checked 8/7/02

AS BUILT SKETCH

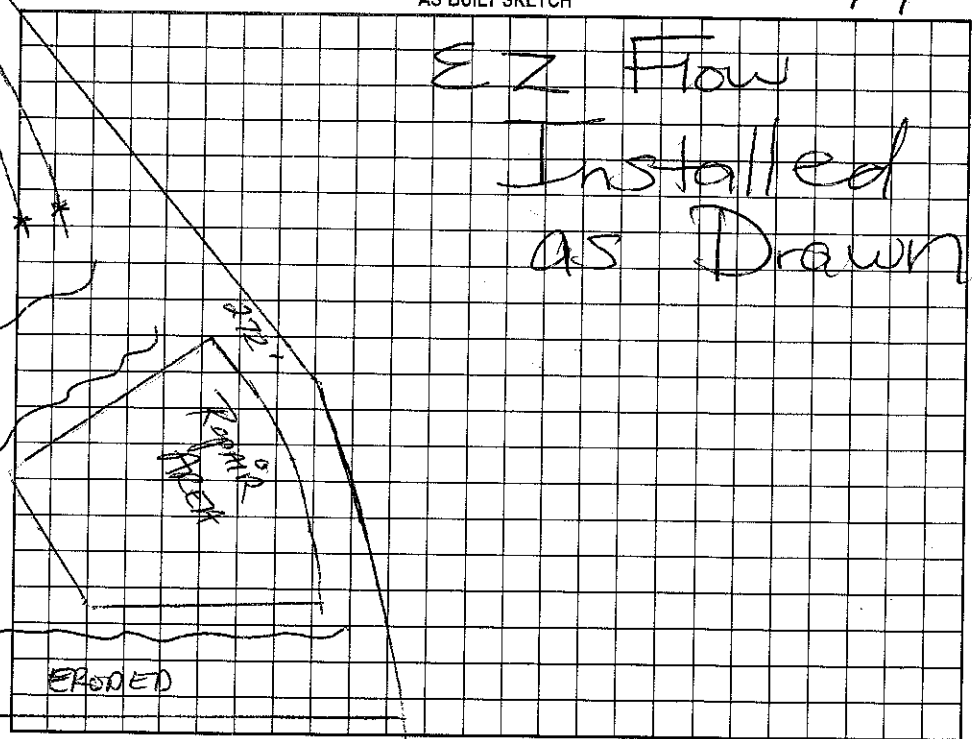

Permit can be suspended or revoked if any false information is supplied toward securing the permit/any unauthorized changes are made to the site/any unauthorized changes are made in the installation of the system. Improvement Permit with plat valid without expiration. Improvement Permit with site plan valid for sixty months. Authorization to Construct is valid for a period equal to that of Improvement Permit – not to exceed sixty months.

Signed: _____ date 6-11-99

Improvement Permit by: Daniel R. Inman, RS date 6-10-99

Authorization to Construct by: _____ RS date 2/1/02

Installed by: Bobby Mayhew RS

Operation Permit by: Marian H. Nelson RS date 8/7/02

Existing System Inspection by: _____ date _____

HEALTH DEPT. COPY: WHITE OWNER COPY (FINAL): YELLOW OWNER COPY (INITIAL): PINK