IREDELL COUNTY HEALTH DEPARTMENT

4626730246

STATESVILLE 704-878-5305 MOORESVILLE 704-664-5281

IMPROVEMENT PERMIT / AUTHORIZATION TO CONSTRUCT / OPERATION PERMIT / EXISTING SYSTEM INSPECT

PERMIT# 11258 5 PIN# 4626637315.266 Eric Clay DATE 6-24-04

OWNER OR CONTRACTOR Simonini Builders PHONE: Business 201-2491 Home

ADDRESS 817 E. Morehead St Charlotte, NC 28202

LOCATION Brawley School TR Southfork TL Freshwater - 2nd on left

SUBDIVISION The Farms BLOCK / SECTION 2 LOT 266 LOT AREA .7 Acre SITE CLASS PS DESIGN FLOW 480gpd L.T.A.R. .3

Septic Tank: 1000+ Gallons; STB 338 Date 6-14-04
Pump Tank: Gallons; PT Date
Pump Make: Model Serial No.
Nitrification Field: No Fields 1 Square Feet 1200' Linear Feet 400'
No Lines 4@100' Trench Width 36" Max Trench Bottom Depth 36" Gravel Depth N/A

☒ New System ☐ Repair System Type: I, II, III, IV, V, VI
System Description: Gravity-25% Reduction
Repair System Description: Pump-Panel
Maintenance Agreement Required: ☐ Yes ☒ No

☒ House/Mod. Home ☐ Mobile Home ☐ Business ☐ Other
No. Bedrooms 4 No. Bathrooms 4 No. Employees
☐ Slab ☒ Crawl Space ☐ Basement w/plumbing ☐ Basement wo/plumbing


Water Supply: ☐ Individual ☒ Public ☒ Community

Comments:/Conditions: Keep Septic System at least 10' From PL


Comments:/Conditions: Checked tank & lines 7/22/04 MD
Need to Check D-box 7/23/04

Scale 1:50

INITIAL SITE SKETCH

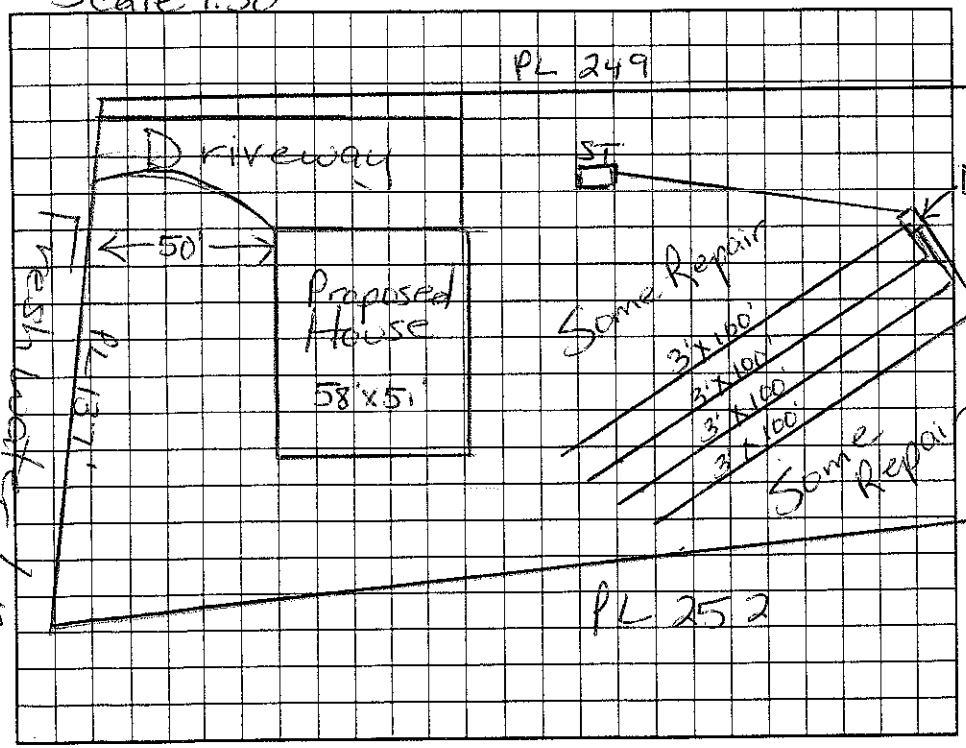

AS BUILT SKETCH

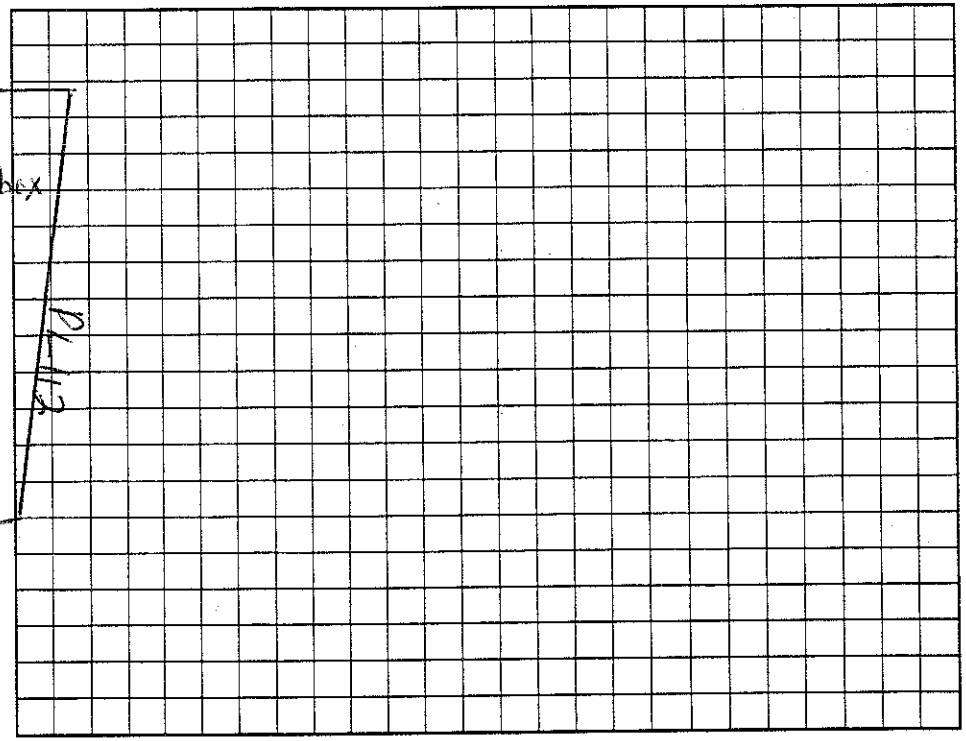

Permit can be suspended or revoked if any false information is supplied toward securing the permit/any unauthorized changes are made to the site/any unauthorized changes are made in the installation of the system. Improvement Permit with plat valid without expiration. Improvement Permit with site plan valid for sixty months. Authorization to Construct is valid for a period equal to that of Improvement Permit – not to exceed sixty months.

Signed: Eric B Clay date 6/30/04 Installed by: R&H

Improvement Permit by: Maria H H Dolson RS date 6/24/04 Operation Permit by: Maria H H Dolson RS date 7/23/04

Authorization to Construct by: Maria H H Dolson RS date 6/24/04 Existing System Inspection by: date

HEALTH DEPT. COPY: WHITE OWNER COPY (FINAL): YELLOW OWNER COPY (INITIAL): PINK