IREDELL COUNTY HEALTH DEPARTMENT

STATESVILLE 704-878-5305 MOORESVILLE 704-664-5281

IMPROVEMENT PERMIT / AUTHORIZATION TO CONSTRUCT / OPERATION PERMIT / EXISTING SYSTEM INSPECTION

PERMIT# 112588 PIN# ~~4626637315.267~~ 4626-73-0246 DATE 8/4/03

OWNER OR CONTRACTOR CRESCENT RESOURCES PHONE: Business 660-1185 Home

ADDRESS 2214 BRAWLEY SCHOOL - MOORESVILLE NC 28117

LOCATION BRAWLEY SCHOOL - TR SOUTHFORK - TL FRESHWATER - 1ST ON LT

SUBDIVISION THE FARMS BLOCK / SECTION 2 LOT 267 LOT AREA .71AC SITE CLASS. RS DESIGN FLOW 480GPD L.T.A.R. .3600/FT²

Septic Tank: 1500 Gallons; STB 338 Date 7/12/05

Pump Tank: 1000 Gallons; PT 283 Date 7/25/05

Pump Make: Gomes Model WE03/2MV Serial No.

Nitrification Field: No Fields 1 Square Feet 540 Linear Feet 270

No Lines 3@90' Trench Width 24" Max Trench Bottom Depth 36" Gravel Depth N/A

☐ ~~New System~~ ☐ Repair System Type: I, II, III, (IV), V, VI

System Description: LP PANEL

Repair System Description: SAME

Maintenance Agreement Required: ☐ ~~Yes~~ ☐ No

☐ ~~House/Mod. Home~~ No. Bedrooms 4

☐ Mobile Home No. Bathrooms 4

☐ Business No. Employees

☐ Other

☐ Slab ☐ ~~Crawl Space~~ ☐ Basement w/plumbing ☐ Basement wo/plumbing


Water Supply:
☐ Individual
☐ Public
☐ ~~Community~~

Comments:/Conditions:

Comments:/Conditions:

62 Panels 3/16" holes

INITIAL SITE SKETCH 1"=50'

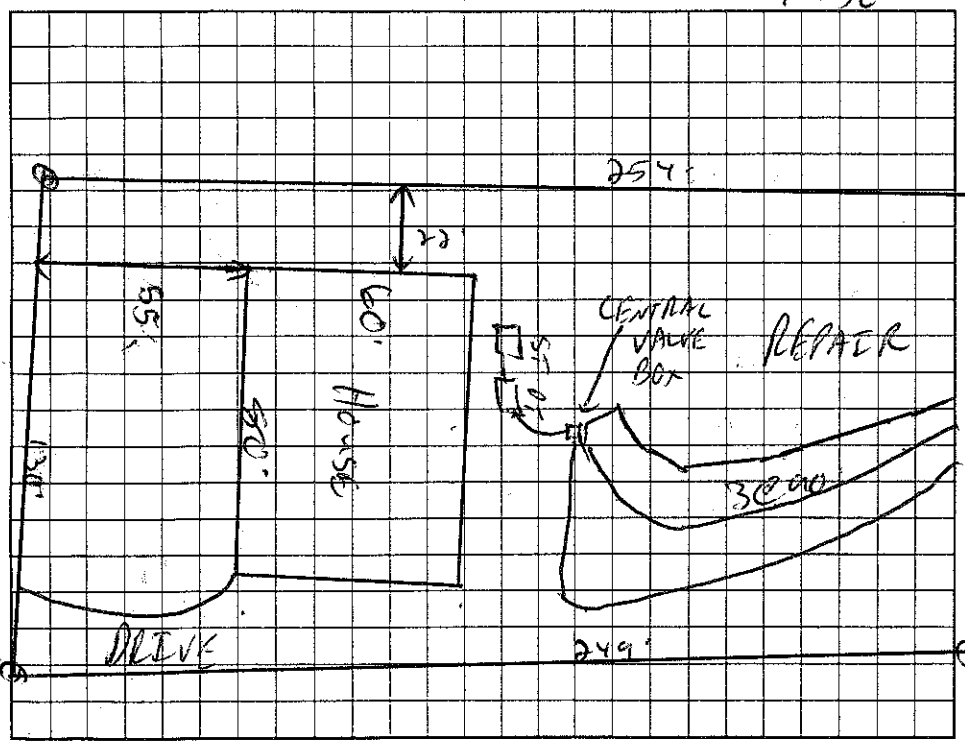

AS BUILT SKETCH

Permit can be suspended or revoked if any false information is supplied toward securing the permit/any unauthorized changes are made to the site/any unauthorized changes are made in the installation of the system. Improvement Permit with ~~plat valid without expiration~~ Improvement Permit with site plan valid for sixty months. Authorization to Construct is valid for a period equal to that of Improvement Permit – not to exceed sixty months.

Signed: _____ date 8-25-05 Installed by: Stanley Septic

Improvement Permit by: _____ RS date 8/4/03 Operation Permit by: _____ RS date 9/2/05

Authorization to Construct by: _____ RS. date 2/25/04 Existing System Inspection by: _____ date _____

HEALTH DEPT. COPY: WHITE OWNER COPY (FINAL): YELLOW OWNER COPY (INITIAL): PINK