IREDELL COUNTY HEALTH DEPARTMENT

Statesville Office (704) 878-5305 Mooresville Office (704) 660-3625 PERMIT # MD 210981

IMPROVEMENT PERMIT / AUTHORIZATION TO CONSTRUCT / OPERATION PERMIT / EXISTING SYSTEM

PIN # 4626 73 0246

APPLICANT: BOB ROSE APPLICANT ADDRESS: 107 FRESHWATER LN MOORESVILLE, NC. 28117

SITE ADDRESS: 107 FRESHWATER LN MOORESVILLE, NC. 28117 PHONE: 704-660-5162 ALT. PHONE:

SITE DIRECTIONS: Brawley School TR South Fork TL Freshwater, 1st House on (L) # 107

SUBDIVISION: The Farms SECTION: 2 LOT # 269 LOT AREA: .71 AC DESIGN FLOW: 480 L.T.A.R.: .3

Septic Tank EXISTING (gal) STB Date
Pump Tank (gal) PT Date
Pump Make Model Serial #
Nitrification Fields # Lines Linear Ft:
Trench Width Max. Trench Bottom Depth Gravel Depth

☐ New System ☐ Repair ☐ Expansion System Type: I II III IV V VI
System Description: EXISTING Pressure Manifold Laterals
Repair System Description:
Maintenance Agreement Required: ☑ YES ☐ NO ☐ GRAVITY ☐ PRESSURE


☑ Residence No. Bedrooms 4
☐ Business No. Persons
☐ Other No. Employees
☐ Slab ☑ Crawl Space
☐ Basement w/plumbing ☐ Basement w/o plumbing

Water Supply: ☐ Private ☐ Public ☑ Community


Comments / Conditions: Porch and Patio work does not impact Septic Tank System. System was approved in 2005 for 4 Bedroom Home. Owner stated on application that house is 5 Bedroom.

Drainfield does not appear to be Surfacing.

INITIAL SITE SKETCH

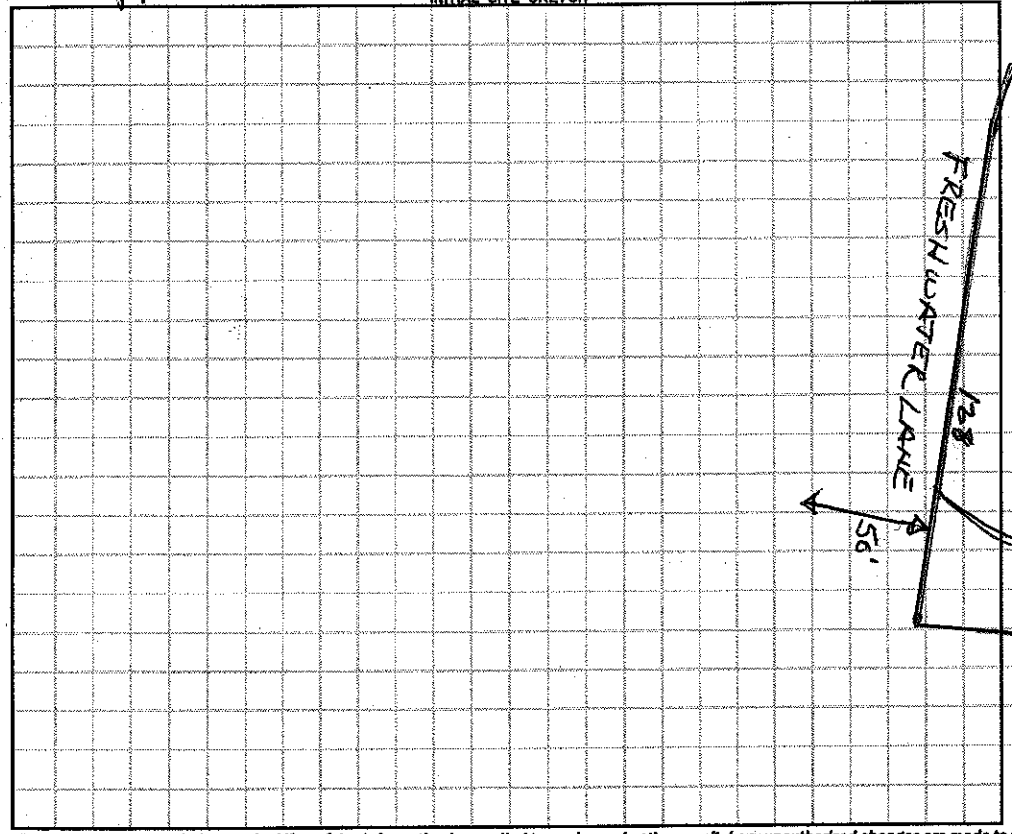

AS BUILT SKETCH

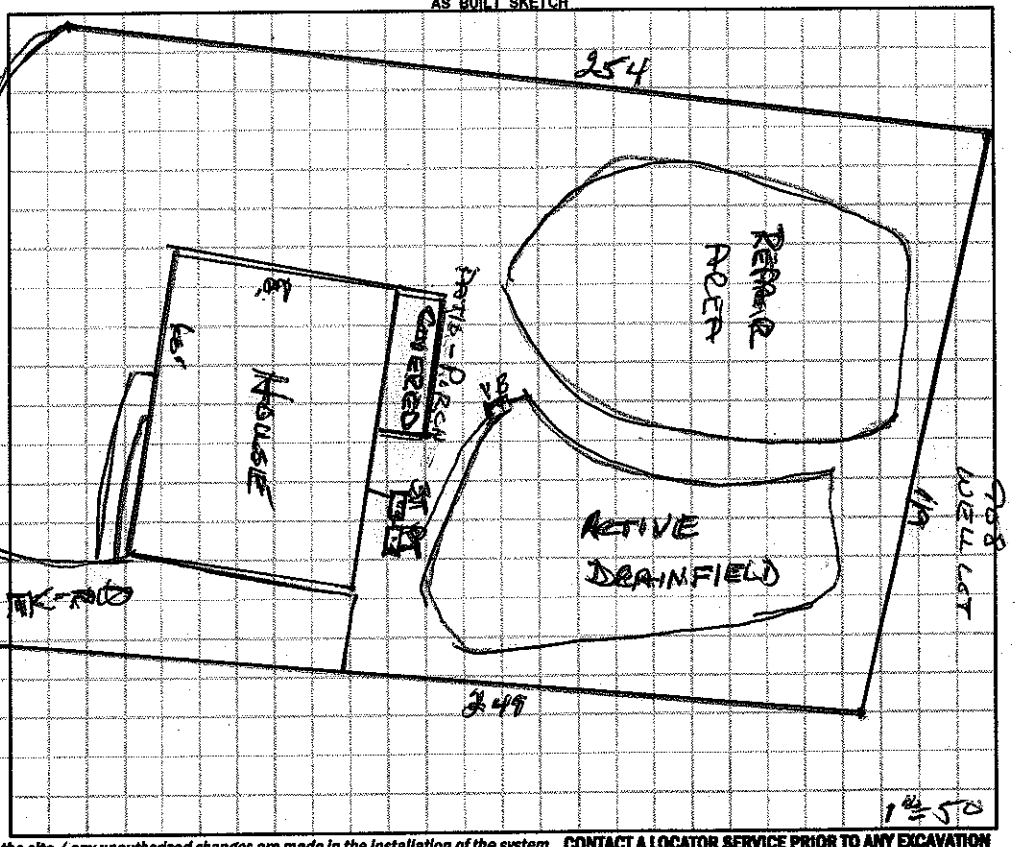

Permit can be suspended or revoked if any false information is supplied toward securing the permit / any unauthorized changes are made to the site / any unauthorized changes are made in the installation of the system. **CONTACT A LOCATOR SERVICE PRIOR TO ANY EXCAVATION**

☐ **IMPROVEMENT PERMIT** *with plat valid without expiration.* ☐ **IMPROVEMENT PERMIT** *with site plan valid for 60 mos.* ☐ **AUTHORIZATION TO CONSTRUCT** *valid for period equal to IMPROVEMENT PERMIT--not to exceed 60 mo.*

Owner / Applicant Signature: RCR Date: 6/30/15 Installed by:

IMPROVEMENT PERMIT by: Date: OPERATION PERMIT by: Date:

AUTHORIZATION TO CONSTRUCT by: Date: Existing System Inspected by: Wesley Parks REHS. Date: 6/29/2015

Health Dept. Copy - WHITE Applicant (Final Approval) - YELLOW Applicant (Conditional Approval) - PINK