RECEIVED JUN 1 6 2015

IREDELL COUNTY HEALTH DEPARTMENT


ENVIRONMENTAL HEALTH DIVISION

PAGE 2: *SITE PLAN WORKSHEET*

SEE THE "SAMPLE SITE PLAN" BELOW. *INCOMPLETE SITE PLANS WILL BE RETURNED TO YOU FOR COMPLETION AND MAY RESULT IN A DELAY IN THE ISSUANCE OF YOUR SEPTIC SYSTEM PERMIT!!!*

Place an (X) beside each item as you complete the site plan:

( ) Property Line measurements are clearly identified
( ) All proposed structures are indicated
( ) Front and side setbacks from property line
( ) Preferred driveway location and well location
( ) Area you prefer your septic system to be placed
( ) North arrow, or other sufficient indicator of direction

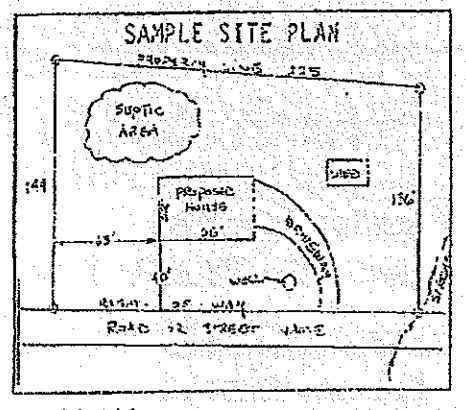


Circle N/A on the following if appropriate:

Location of septic systems and wells within 100' of your property	N/A
Location of easements and rights of ways on your property	N/A
Location of any designated wetlands on the property	N/A

USE THIS SPACE TO DRAW YOUR SITE PLAN

Show: proposed house or business footprint, wells, water lines, patios, pools and decks, and any other item that will occupy space on the site

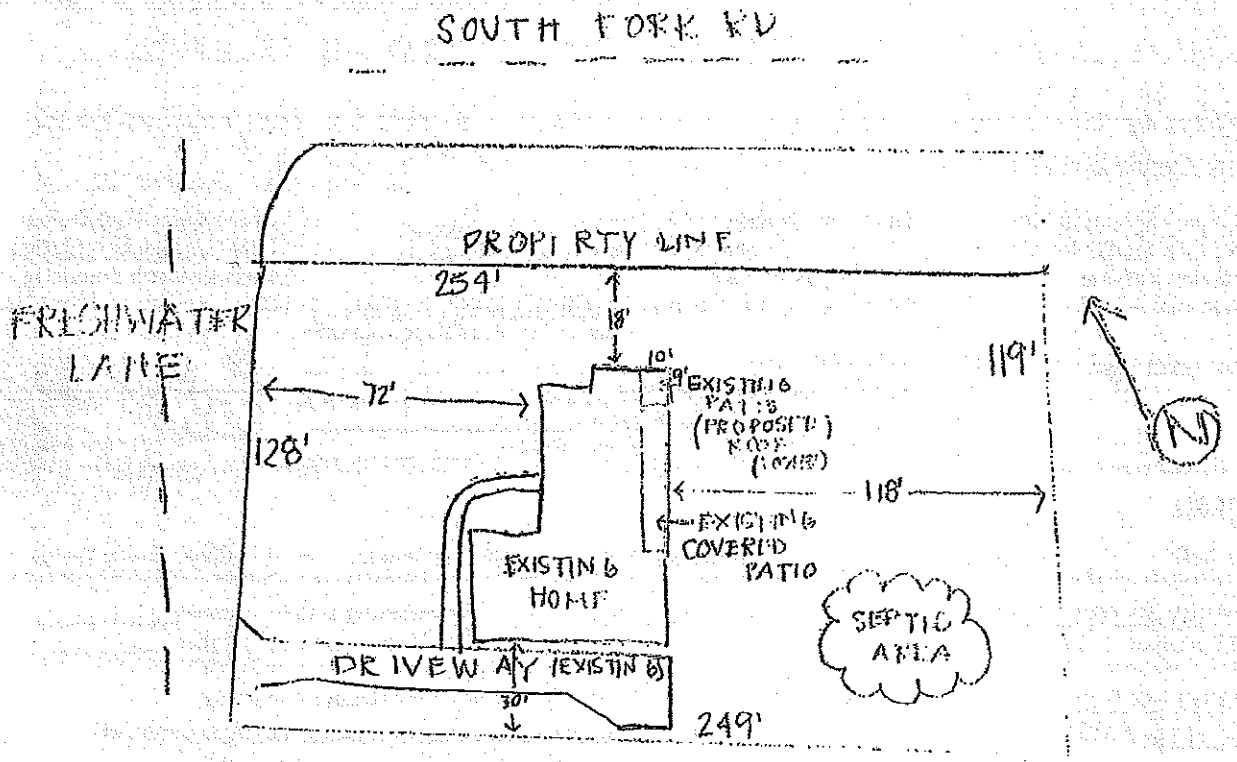


Signature: _____

Property owner or owner's legal representative signature (SIGNATURE REQUIRED)

5/22/2015

DATE

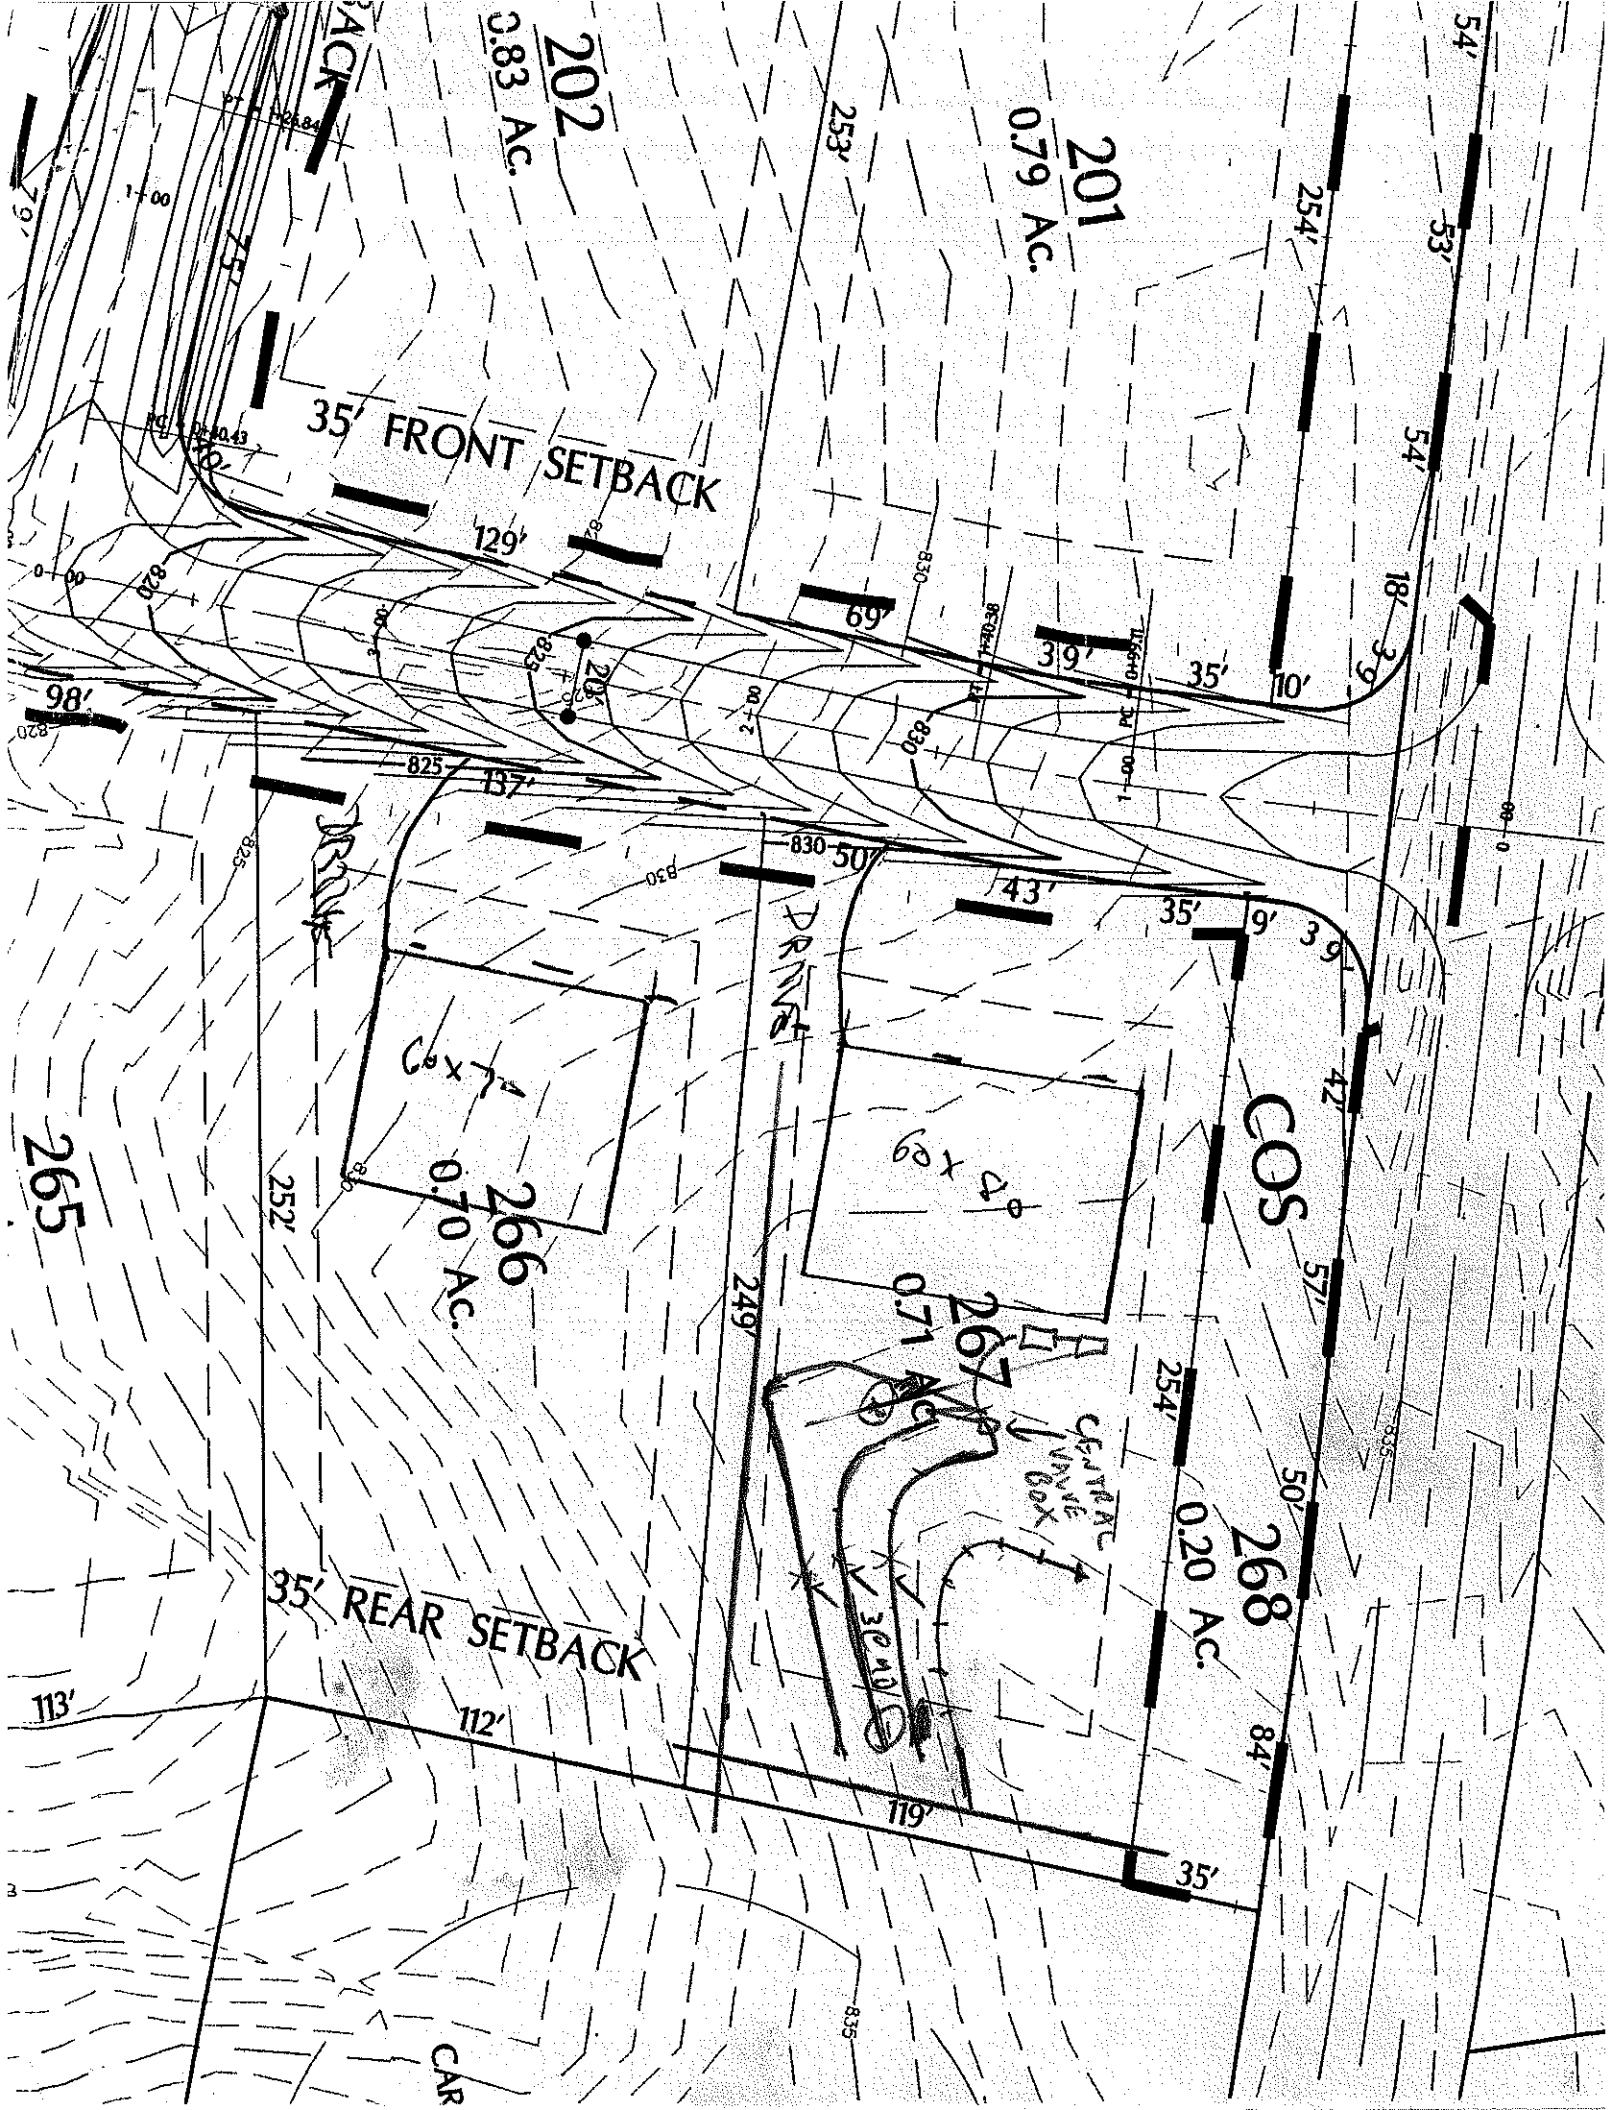
202
0.83 Ac.
201
0.79 Ac.
253'
254'
53'
54'
54'
35' FRONT SETBACK
129'
69'
39'
35'
10'
18'
39'
98'
137'
50'
43'
35'
9'
39'
42'
265
252'
266
0.70 Ac.
249'
267
0.71 Ac.
COS
57'
254'
50'
268
0.20 Ac.
84'
35' REAR SETBACK
113'
112'
119'
35'
60 x 40
CAR

IREDELL COUNTY HEALTH DEPARTMENT

STATESVILLE 704-878-5305 MOORESVILLE 704-664-5281

IMPROVEMENT PERMIT / AUTHORIZATION TO CONSTRUCT / OPERATION PERMIT / EXISTING SYSTEM INSPECTION

PERMIT# 112-508 PIN# ~~4626637315.267~~ 4626-73-0246 DATE 8/4/03

OWNER OR CONTRACTOR CRESCENT RESOURCES PHONE: Business 660-1185 Home

ADDRESS 2214 BRAWLEY SCHOOL - MOORESVILLE NC 28117

LOCATION BRAWLEY SCHOOL - TR SOUTHFORK - TL FRESHWATER - 1ST ON LT

SUBDIVISION THE FARMS BLOCK / SECTION 2 LOT 267 LOT AREA .71AC SITE CLASS. FS DESIGN FLOW 480GPD L.T.A.R. .300/FT2

Septic Tank: 1500 Gallons; STB 338 Date 7/14/05

Pump Tank: 1000 Gallons; PT 283 Date 7/25/05

Pump Make: Combs Model WE63/2HP Serial No.

Nitrification Field: No Fields 1 Square Feet 540 Linear Feet 270

No Lines 3@90' Trench Width 24" Max Trench Bottom Depth 36" Gravel Depth N/A

☒ New System ☐ Repair System Type: I, II, III, (IV) V, VI

System Description: LP PUMP

Repair System Description: SAME

Maintenance Agreement Required: ☐ Yes ☐ No

☒ House/Mod. Home No. Bedrooms 4

☐ Mobile Home No. Bathrooms 4

☐ Business No. Employees

☐ Other

☐ Slab ☒ Crawl Space ☐ Basement w/plumbing ☐ Basement wo/plumbing


Water Supply: ☐ Individual ☐ Public ☒ Community

Comments:/Conditions:


Comments:/Conditions:

62 Panels 3/16" holes

INITIAL SITE SKETCH 1"=50'

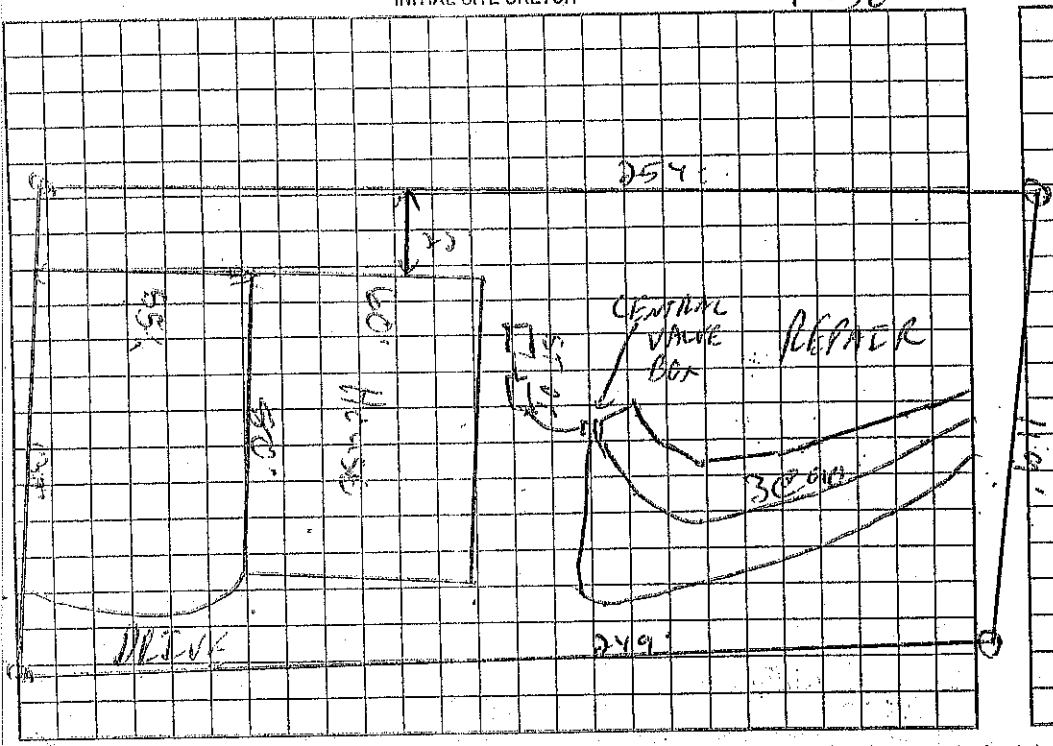

AS BUILT SKETCH

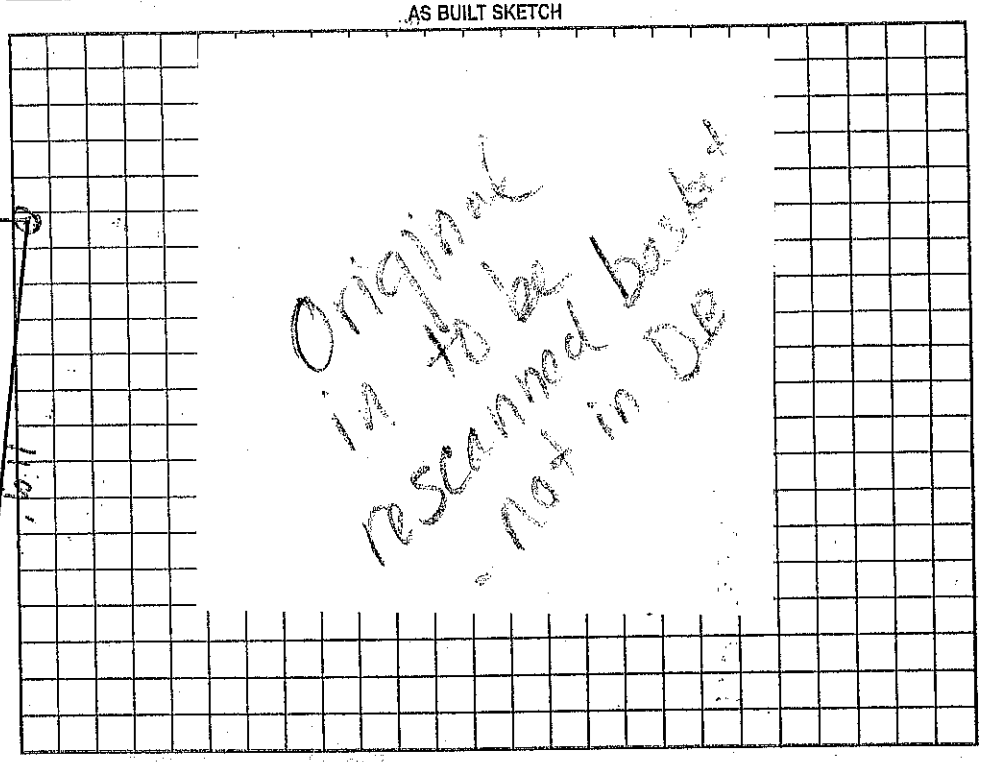

Permit can be suspended or revoked if any false information is supplied toward securing the permit/any unauthorized changes are made to the site/any unauthorized changes are made in the installation of the system. Improvement Permit with plat valid without expiration. Improvement Permit with site plan valid for sixty months. Authorization to Construct is valid for a period equal to that of Improvement Permit -- not to exceed sixty months.

Signed: date 8-25-03 Installed by: Stanley Septic

Improvement Permit by: RS date 8/4/03 Operation Permit by: RS date 9/2/05

Authorization to Construct by: RS. date 2/25/04 Existing System Inspection by: date

HEALTH DEPT. COPY: WHITE OWNER COPY (FINAL): YELLOW OWNER COPY (INITIAL): PINK