IREDELL COUNTY HEALTH DEPARTMENT

STATESVILLE 704-878-5305 130.00 Paid MOORESVILLE 704-664-5281 3:30

IMPROVEMENT PERMIT / AUTHORIZATION TO CONSTRUCT / OPERATION PERMIT / EXISTING SYSTEM INSPECTIO

PERMIT# 111346 PIN# 4626637315.37 4626736614 DATE 3-24-04

OWNER OR CONTRACTOR Simonini Builders PHONE: Business (704) 358-9940 Home

ADDRESS 817 Morehead St Charlotte NC 28202

LOCATION Brawley School Rd TR Southfork TR Kapp Place TR East Callicutt Trail TR Tannenb

SUBDIVISION The Farms BLOCK / SECTION 1 LOT 37 LOT AREA 1.069 Acre SITE CLASS. PS DESIGN FLOW 480gpd L.T.A.R. .3 on right

Septic Tank: 1000 Gallons; STB 338 Date 2-15-04

Pump Tank: Gallons; PT Date

Pump Make: Model Serial No.

Nitrification Field: No Fields 1 Square Feet 1200' Linear Feet 400'

No Lines 4@100' Trench Width 36" Max Trench Bottom Depth 36" Gravel Depth N/A

☒ New System ☐ Repair System Type: I, II, III, IV, V, VI

System Description: Gravity - 25% Reduction

Repair System Description: Same

Maintenance Agreement Required: ☐ Yes ☒ No

☒ House/Mod. Home ☐ Mobile Home ☐ Business ☐ Other

No. Bedrooms 4 No. Bathrooms 4 No. Employees


☐ Slab ☒ Crawl Space ☐ Basement w/plumbing ☐ Basement wo/plumbing

Water Supply: ☐ Individual ☒ Public ☐ Community


Comments/Conditions:

Comments/Conditions:

INITIAL SITE SKETCH

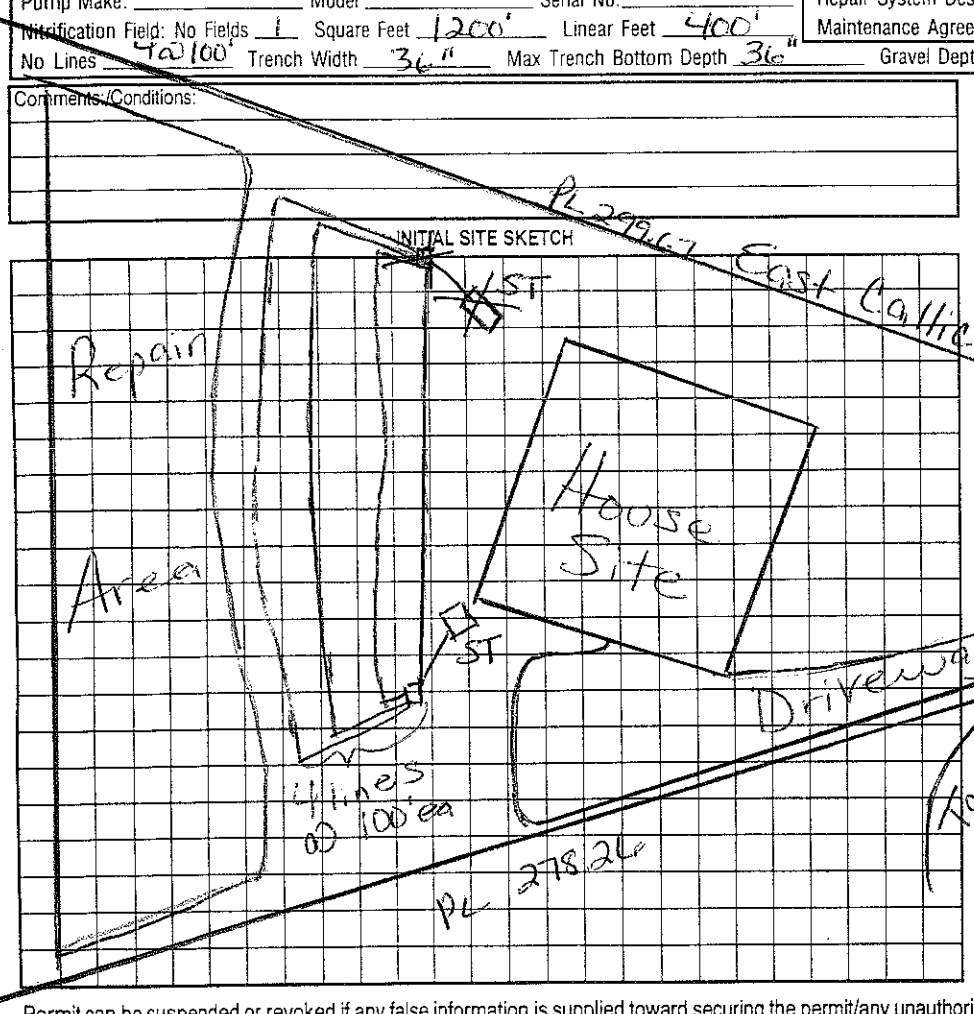

AS BUILT SKETCH

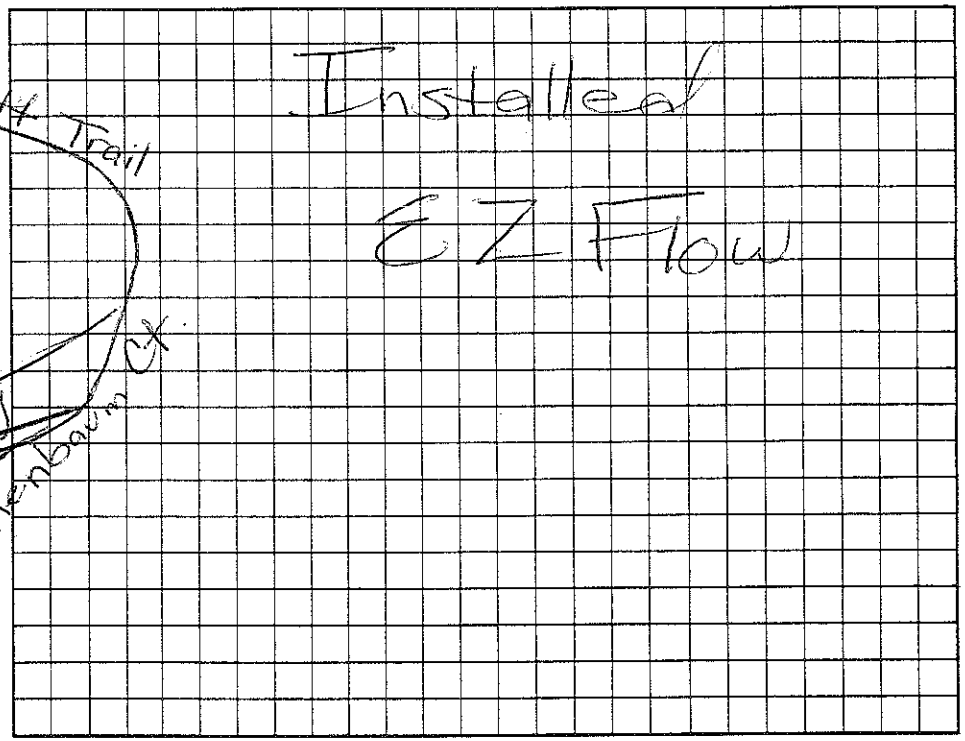

Permit can be suspended or revoked if any false information is supplied toward securing the permit/any unauthorized changes are made to the site/any unauthorized changes are made in the installation of the system. Improvement Permit with plat valid without expiration. Improvement Permit with site plan valid for sixty months. Authorization to Construct is valid for a period equal to that of Improvement Permit – not to exceed sixty months.

Signed: date Installed by: R & H RS

Improvement Permit by: Maria H. Dolan RS date 3/24/04 Operation Permit by: Maria H. Dolan date 4/16/04

Authorization to Construct by: Maria H. Dolan RS date 3/24/04 Existing System Inspection by: date

HEALTH DEPT. COPY: WHITE OWNER COPY (FINAL): YELLOW OWNER COPY (INITIAL): PINK