AS - Built 3.00

IREDELL COUNTY HEALTH DEPARTMENT

STATESVILLE 704-878-5305 MOORESVILLE 704-664-5281

IMPROVEMENT PERMIT / AUTHORIZATION TO CONSTRUCT / OPERATION PERMIT / EXISTING SYSTEM INSPECTION

PERMIT# 111296 PIN# ~~4626637315~~ 4626-73-6951 DATE 7-15-04

OWNER OR CONTRACTOR Hughes & Assoc PHONE: Business Home

ADDRESS

LOCATION Brawley School TR South Fork TR Kapp Place TR East Calliott Trail 5th on left

SUBDIVISION The Farms BLOCK / SECTION 1 LOT 28 LOT AREA SITE CLASS PS DESIGN FLOW 600gpd T.A.R. .5

Septic Tank: 1500 Gallons; STB 338 Date 5-24-04
Pump Tank: 1500 Gallons; PT 421 Date 5-21-04
Pump Make: Model Serial No.
Nitrification Field: No Fields 1 Square Feet 666/999 Linear Feet 333'
No Lines 6@55' French Width 36" Max Trench Bottom Depth 36" Gravel Depth N/A

☒ New System ☐ Repair System Type: I, II, III, IV, V, VI
System Description: Pump-LP-Panel Block
Repair System Description: Same
Maintenance Agreement Required: ☒ Yes ☐ No


☒ House/Mod. Home No. Bedrooms 5
☐ Mobile Home No. Bathrooms 5
☐ Business No. Employees
☐ Other
☐ Slab ☐ Crawl Space ☒ Basement w/plumbing ☐ Basement wo/plumbing

Water Supply: ☐ Individual ☒ Public ☒ Community


Comments:/Conditions:

Comments:/Conditions: Checked elect, alarm & pressure 8/25/04

INITIAL SITE SKETCH 1"=50'

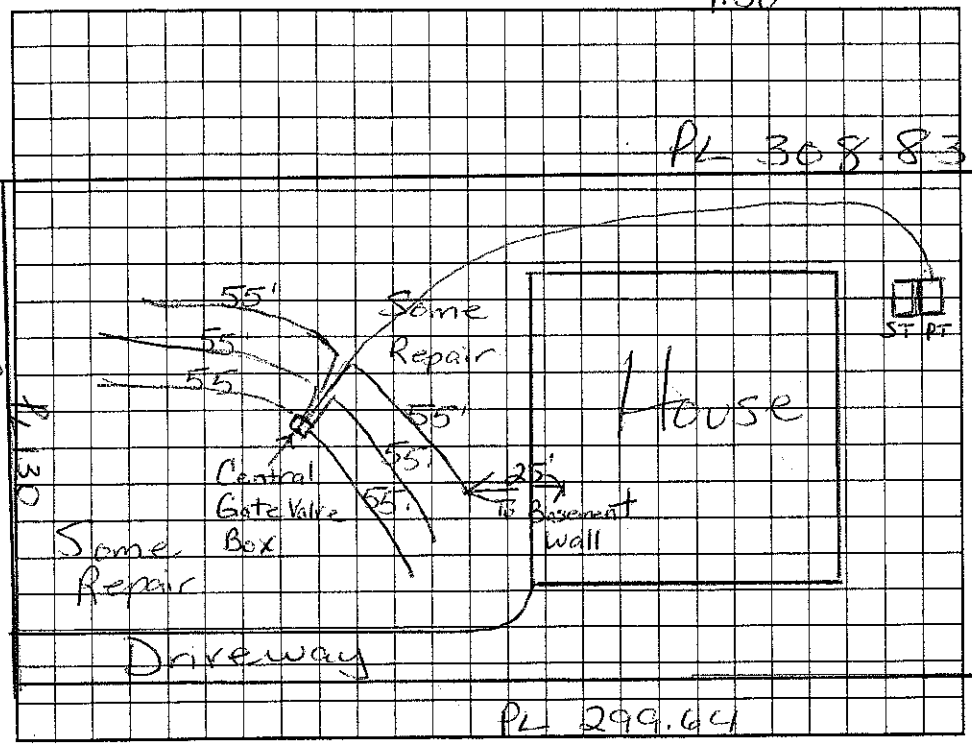

AS BUILT SKETCH

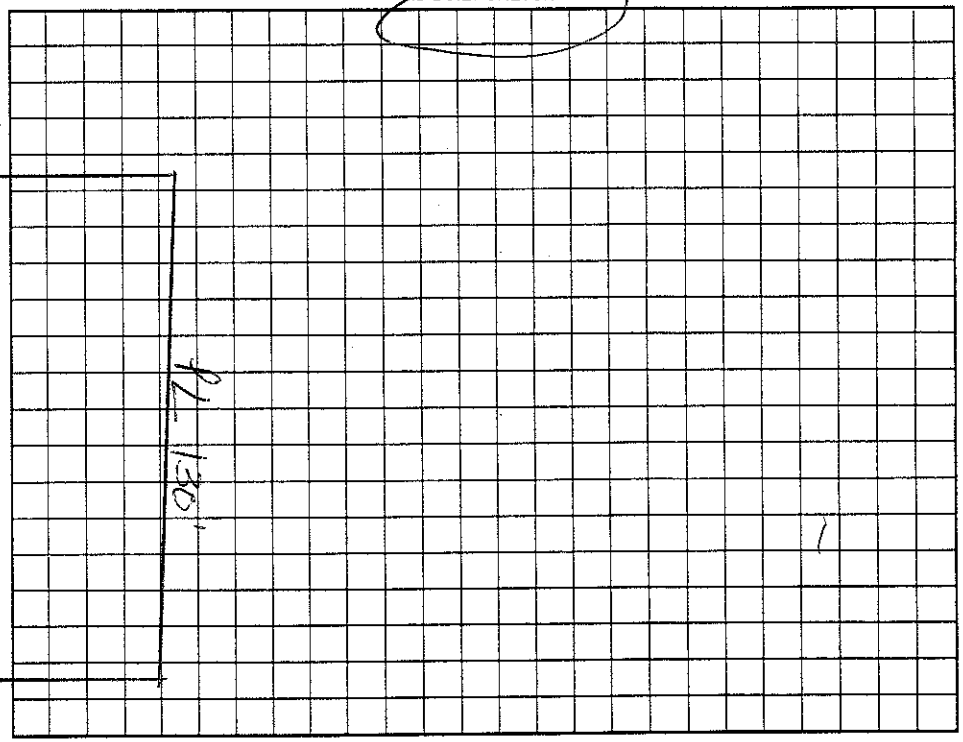

Permit can be suspended or revoked if any false information is supplied toward securing the permit/any unauthorized changes are made to the site/any unauthorized changes are made in the installation of the system. Improvement Permit with plat valid without expiration. Improvement Permit with site plan valid for sixty months. Authorization to Construct is valid for a period equal to that of Improvement Permit – not to exceed sixty months.

Signed: Bill Poplin date 9-2-04

Improvement Permit by: Maria H. Dotson date

Authorization to Construct by: Maria H. Dotson date

Installed by: R & H RS

Operation Permit by: Maria H. Dotson date 9/2/04

Existing System Inspection by: date

HEALTH DEPT. COPY: WHITE OWNER COPY (FINAL): YELLOW OWNER COPY (INITIAL): PINK