IREDELL COUNTY HEALTH DEPARTMENT

STATESVILLE 704-878-5305 50.00 Paid MOORESVILLE 704-664-5281

IMPROVEMENT PERMIT / AUTHORIZATION TO CONSTRUCT / OPERATION PERMIT / EXISTING SYSTEM INSPECTION

PERMIT# 111302 PIN# 4626 63 7315.30 4626-73-8892 0462 DATE 3/23/05

OWNER OR CONTRACTOR Lake Norman Signature Homes PHONE: Business 704-361-~~5041~~ Home

ADDRESS 548 Brawley School Rd. Fe Ext, Mooresville, NC. 28117

LOCATION 1100 TR South Fork TR Kapp Place TR E. Calliott Tr. on (L) near end

SUBDIVISION Farms BLOCK / SECTION 1 LOT 30 LOT AREA ~1.83Ac SITE CLASS. PS DESIGN FLOW 600 L.T.A.R. .3

Septic Tank: 1500 Gallons; STB 338 Date 8/30/05
Pump Tank: 1500 Gallons; PT 477 Date 8/30/05
Pump Make: Goulds Model WE-5M2 ~~HH66Hat~~ No.
Nitrification Field: No Fields 1 Square Feet 1500 Linear Feet 500
No Lines 5 @ 100' Trench Width 3' Max Trench Bottom Depth 3'

[X] New System [ ] Repair System Type: I, II, (III) IV, V, VI
System Description: PreMay → 25% Reduced
Repair System Description: Same Type
Maintenance Agreement Required: [ ] Yes [X] No


[X] House/Mod. Home No. Bedrooms 5
[ ] Mobile Home No. Bathrooms 4
[ ] Business No. Employees
[ ] Other

Gravel Depth No [ ] Slab [ ] Crawl Space [X] Basement w/plumbing [ ] Basement wo/plumbing


Water Supply: [ ] Individual [ ] Public [X] Community FARMS

Comments:/Conditions: House location moved away from road R/W

(1" = 40')

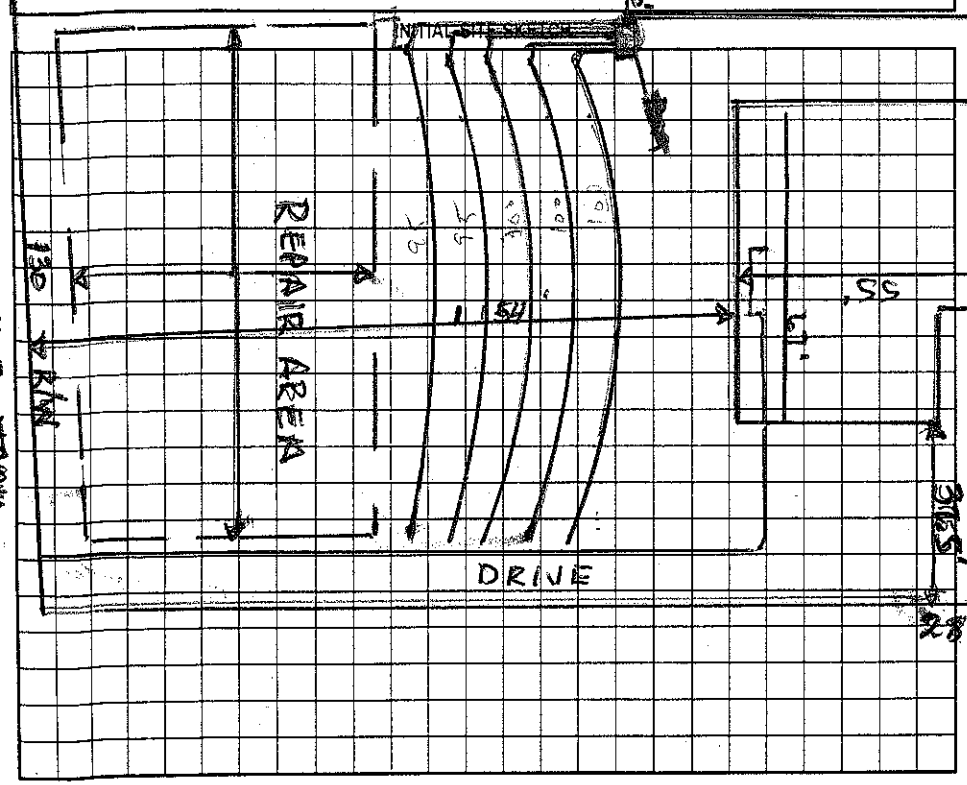

Comments:/Conditions: EZ Flow Installed

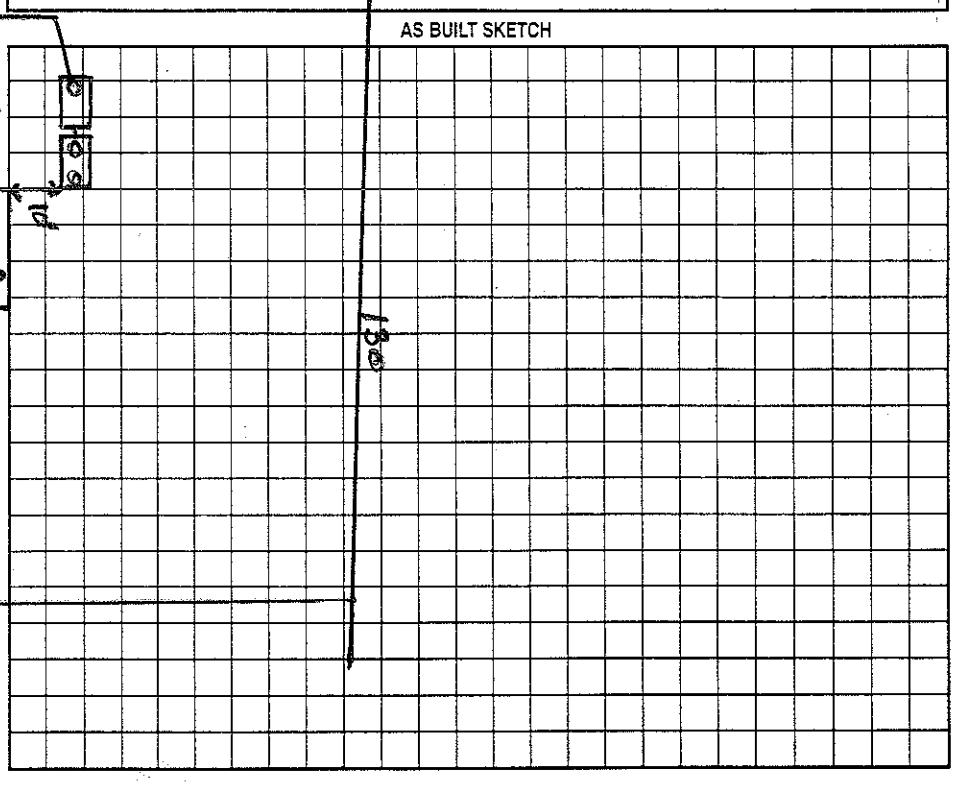

Permit can be suspended or revoked if any false information is supplied toward securing the permit/any unauthorized changes are made to the site/any unauthorized changes are made in the installation of the system. Improvement Permit with plat valid without expiration. Improvement Permit with site plan valid for sixty months. Authorization to Construct is valid for a period equal to that of Improvement Permit – not to exceed sixty months.

Signed: [signature] Agent date 3/29/05 Installed by: Hallman Construction

Improvement Permit by: Wesley Sparks R.S. date 3/23/05 Operation Permit by: Wesley Sparks R.S. date 1/11/06

Authorization to Construct by: Wesley Sparks R.S. date 3/23/05 Existing System Inspection by: date

HEALTH DEPT. COPY: WHITE OWNER COPY (FINAL): YELLOW OWNER COPY (INITIAL): PINK