IREDELL COUNTY HEALTH DEPARTMENT

STATESVILLE 704-878-5305 $50 MOORESVILLE 704-664-5281

IMPROVEMENT PERMIT / AUTHORIZATION TO CONSTRUCT / OPERATION PERMIT / EXISTING SYSTEM INSPECTION

3:00

PERMIT# 112089 PIN# 4626637315.58 4626-74-3969 DATE 10/14/03

OWNER OR CONTRACTOR The Hoke Company PHONE: Business (704) 799-7495 Home

ADDRESS P.O. Box 4448 Mooresville, NC, 28117

LOCATION Brawley School Road TR SouthFork bear right on Agnew TR Caldwell Creek TR Magnolia Farms on left

SUBDIVISION The Farms BLOCK / SECTION 1 LOT 58 LOT AREA 1.033 Acre SITE CLASS. PS DESIGN FLOW 600gpd L.T.A.R. .3

Septic Tank: 1500 Gallons; STB 338 Date 2-22-04
Pump Tank: 1500 Gallons; PT ~~338~~ 42 Date 4-02-04
Pump Make: Model Serial No.
Nitrification Field: No Fields 1 Square Feet 1500' Linear Feet 500'
No Lines 5@100' Trench Width 36" Max Trench Bottom Depth 36" Gravel Depth N/A

☒ New System ☐ Repair System Type: I, II, III, IV, V, VI
System Description: Pump - 25% Reduction*
Repair System Description: Pump-LP-Panel Block
Maintenance Agreement Required: ☐ Yes ☒ No Not Initially

☒ House/Mod. Home No. Bedrooms 5
☐ Mobile Home No. Bathrooms 3.5
☐ Business No. Employees
☐ Other


☐ Slab ☒ Crawl Space ☐ Basement w/plumbing ☐ Basement wo/plumbing


Water Supply: ☐ Individual ☒ Public ☒ Community

Comments/Conditions: Keep Septic System at least 10' From PL

Comments/Conditions: * 25% Reduction = EZ-Flow or Plastic Chambers
Checked tanks 4/6/04 MD
Checked drainlines 11/13/03 Installed EZ-Flow AS BUILT SKETCH as drawn

Scale 1:50 INITIAL SITE SKETCH

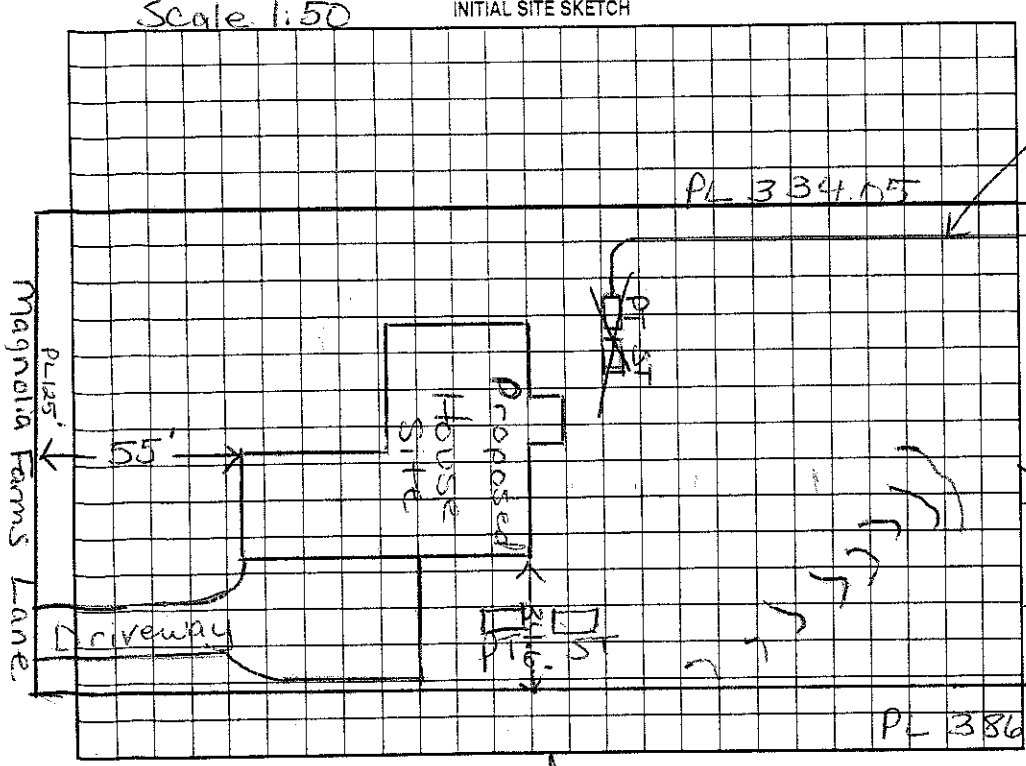

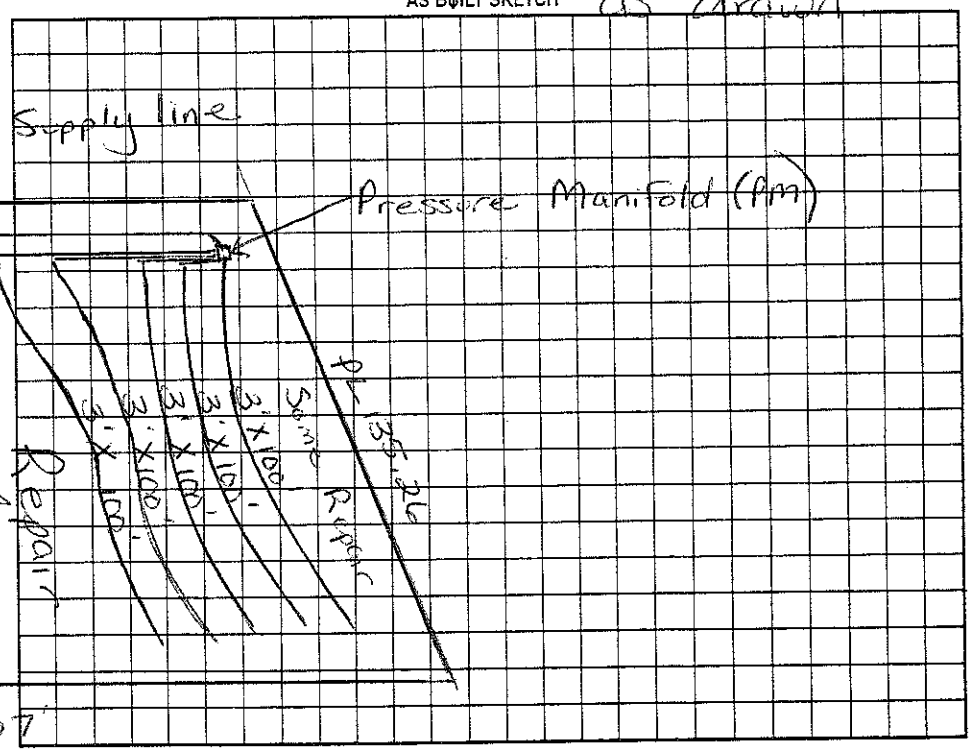

Permit can be suspended or revoked if any false information is supplied toward securing the permit/any unauthorized changes are made to the site/any unauthorized changes are made in the installation of the system. Improvement Permit with plat valid without expiration. Improvement Permit with site plan valid for sixty months. Authorization to Construct is valid for a period equal to that of Improvement Permit – not to exceed sixty months.

Signed: date 10/20/03 Installed by: R E F R.S

Improvement Permit by: Maina H. Hilderbrand R.S date 10/14/03 Operation Permit by: Maina H. Hilderbrand date 4/30/04

Authorization to Construct by: Maina H. Hilderbrand R.S date 10/14/03 Existing System Inspection by: date

HEALTH DEPT. COPY: WHITE OWNER COPY (FINAL): YELLOW OWNER COPY (INITIAL): PINK