IREDELL COUNTY HEALTH DEPARTMENT

STATESVILLE 704-878-5305 MOORESVILLE 704-664-5281

IMPROVEMENT PERMIT / AUTHORIZATION TO CONSTRUCT / OPERATION PERMIT / EXISTING SYSTEM INSPECTION

PERMIT# 111272 PIN# 4626637315 4626744011 DATE 4-28-05

OWNER OR CONTRACTOR Lake Norman Signature Homes PHONE: Business 361-0402 Home 704 799-1851

ADDRESS 584 Brawley School Rd Ste 104 Mooresville, NC 28117

LOCATION Brawley School Rd TR South Fork TR Kapp Place Rd TR Callicutt on left

SUBDIVISION The Farms BLOCK / SECTION 1 LOT 26 LOT AREA .961 Acre SITE CLASS RS DESIGN FLOW 600gpd L.T.A.R. .3

Septic Tank: 1500 Gallons; STB 338 Date 4/16/05

Pump Tank: 1500 Gallons; PT 477 Date 2/7/05

Pump Make: Geotis Model WE0512HH4 Serial No. E0534494

Nitrification Field: No Fields 1 Square Feet 1500 Linear Feet 500

No Lines 5@100' Trench Width 36" Max Trench Bottom Depth 36" Gravel Depth N/A

☒ New System ☐ Repair System Type: I, II, III, IV, V, VI

System Description: Pump-PM-25% Reduction

Repair System Description: Pump-LP-Panel Blk

Maintenance Agreement Required: ☐ Yes ☐ No

☒ House/Mod. Home ☐ Mobile Home ☐ Business ☐ Other

No. Bedrooms 5 No. Bathrooms 4 No. Employees

☐ Slab ☒ Crawl Space ☒ Basement w/plumbing ☐ Basement wo/plumbing


Water Supply: ☐ Individual ☒ Public ☒ Community

Comments:/Conditions:


Comments:/Conditions: partial

Scale 1:50

INITIAL SITE SKETCH

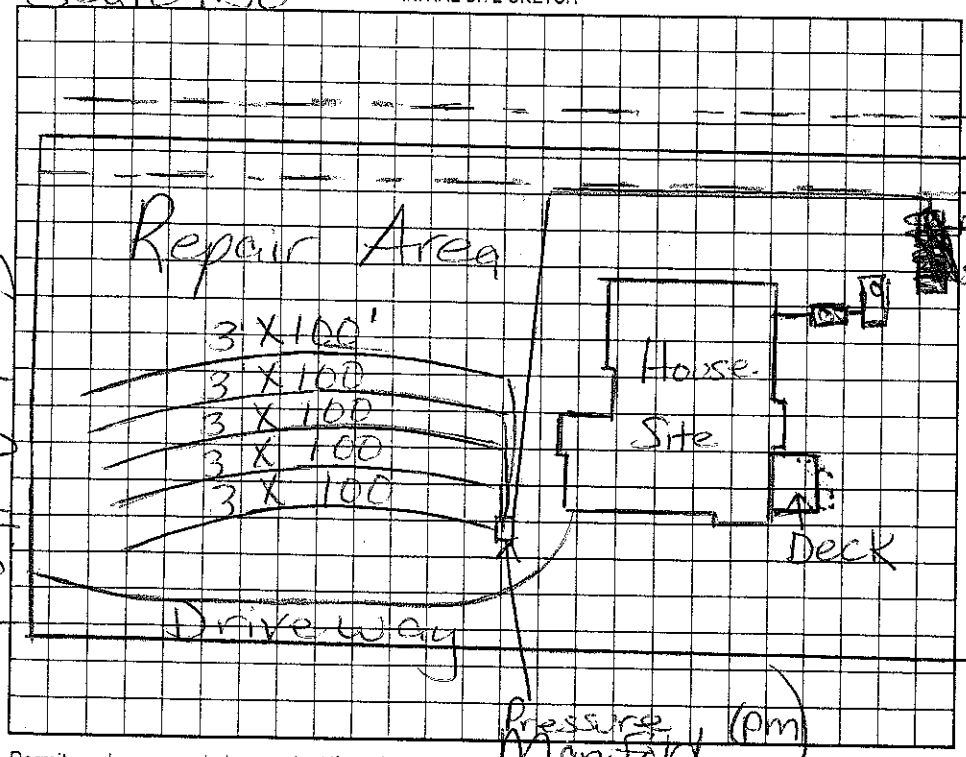

AS BUILT SKETCH

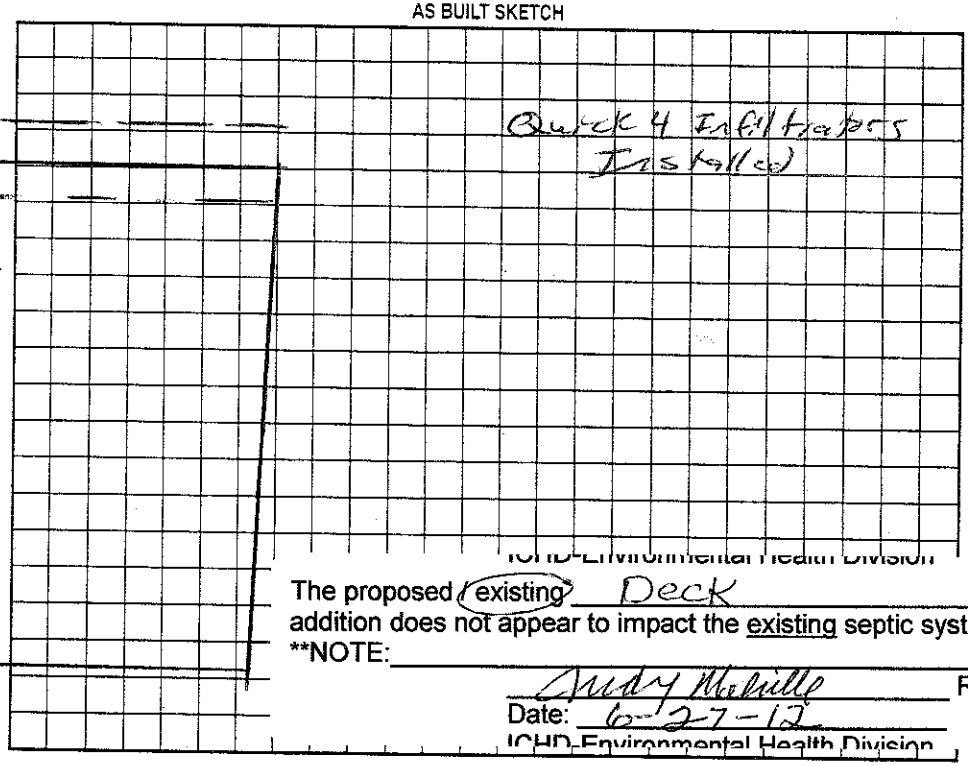

The proposed (existing) Deck addition does not appear to impact the existing septic system.

**NOTE:

Cindy Melville R.S.

Date: 6-27-12

ICHD-Environmental Health Division

Permit can be suspended or revoked if any false information is supplied toward securing the permit/any unauthorized changes are made to the site/any unauthorized changes are made in the installation of the system. Improvement Permit with plat valid without expiration. Improvement Permit with site plan valid for sixty months. Authorization to Construct is valid for a period equal to that of Improvement Permit – not to exceed sixty months.

Signed: Plot Onagent date 5/16/05 Installed by: Hallman Const

Improvement Permit by: Maina M. Deloach R.S. date 4/28/05 Operation Permit by: Wesley Sparks R.S. date 6/30/05

Authorization to Construct by: Maina M. Deloach R.S. date 4/28/05 Existing System Inspection by: date

HEALTH DEPT. COPY: WHITE OWNER COPY (FINAL): YELLOW OWNER COPY (INITIAL): PINK

IREDELL COUNTY HEALTH DEPARTMENT

STATESVILLE 704-878-5305 MOORESVILLE 704-664-5281

IMPROVEMENT PERMIT / AUTHORIZATION TO CONSTRUCT / OPERATION PERMIT / EXISTING SYSTEM INSPECTION

PERMIT# 111272 PIN# 4626603737315 4626744011 DATE 4-28-05

OWNER OR CONTRACTOR Lake Norman Signature Homes PHONE: Business 361-0402 Home 704 799-1851

ADDRESS 584 Brawley School Rd Ste 104 Mooresville, NC 28117

LOCATION Brawley School Rd TR SouthFork TR Kapp Place Rd TR Calicutt on left

SUBDIVISION The Farms BLOCK / SECTION 1 LOT 26 LOT AREA .961 Acre SITE CLASS. PS DESIGN FLOW 600gpd L.T.A.R. .3

Septic Tank: 1500 Gallons; STB 338 Date 4/16/05
Pump Tank: 1500 Gallons; PT 477 Date 4/7/05
Pump Make: Geotis Model WE0512HHA Serial No. E05544494
Nitrification Field: No Fields 1 Square Feet 1500 Linear Feet 500
No Lines 5@100' Trench Width 36" Max Trench Bottom Depth 36" Gravel Depth N/A

☒ New System ☐ Repair System Type: I, II, III, IV, V, VI
System Description: Pump-PM-25% Reduction
Repair System Description: Pump-LP-Panel Blk
Maintenance Agreement Required: ☐ Yes ☐ No

☒ House/Mod. Home ☐ Mobile Home ☐ Business ☐ Other
No. Bedrooms 5 No. Bathrooms 4 No. Employees

☐ Slab ☒ Crawl Space ☒ Basement w/plumbing ☐ Basement wo/plumbing


Water Supply: ☐ Individual ☒ Public ☒ Community

Comments:/Conditions:


Comments:/Conditions: partial

Scale 1:50

INITIAL SITE SKETCH

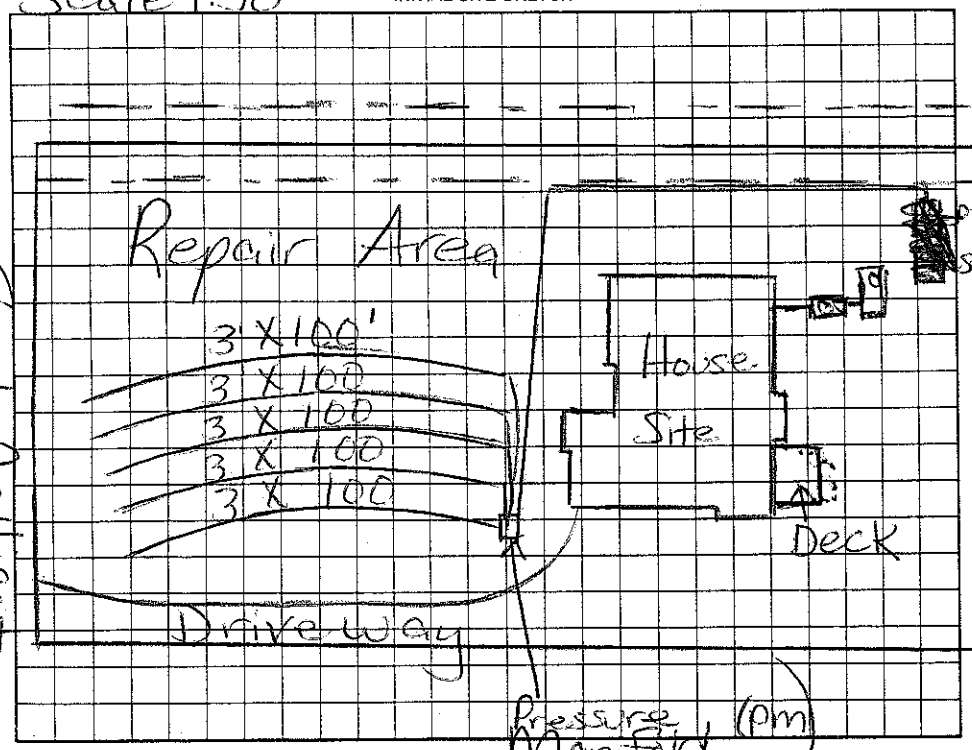

AS BUILT SKETCH

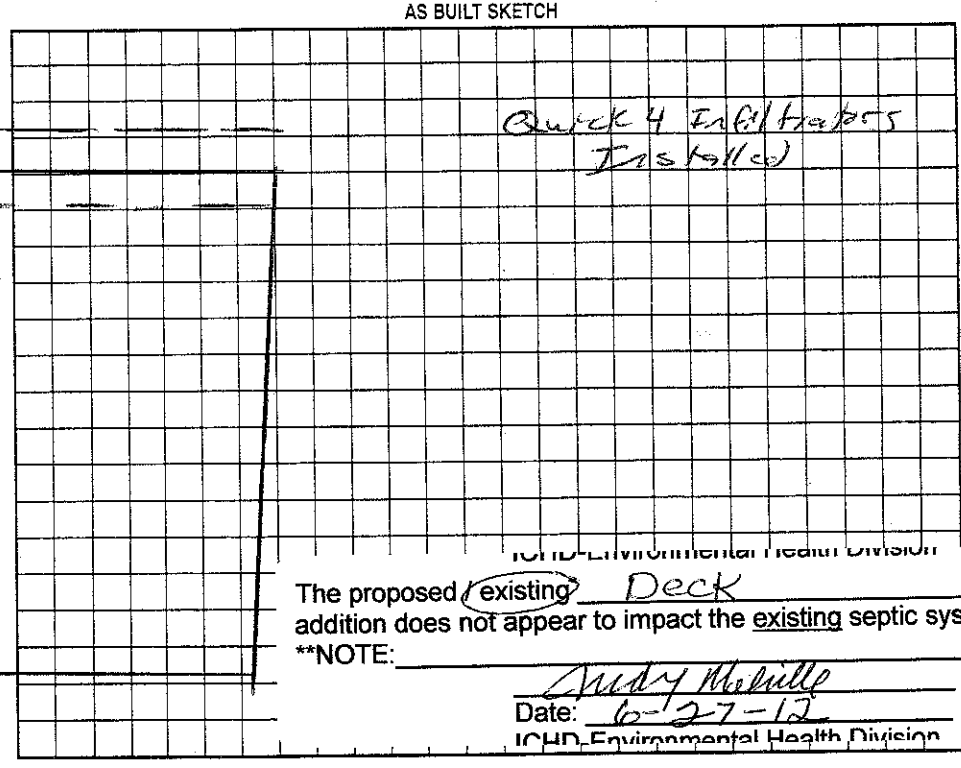

ICHD-Environmental Health Division

The proposed (existing) Deck addition does not appear to impact the existing septic system.

**NOTE:

Andy Melville R.S.

Date: 6-27-12

ICHD-Environmental Health Division

Permit can be suspended or revoked if any false information is supplied toward securing the permit/any unauthorized changes are made to the site/any unauthorized changes are made in the installation of the system. Improvement Permit with plat valid without expiration. Improvement Permit with site plan valid for sixty months. Authorization to Construct is valid for a period equal to that of Improvement Permit – not to exceed sixty months.

Signed: Phil Thompson agent date 5/16/05 Installed by: Hallman Const

Improvement Permit by: Maina M. Dolson RS date 4/28/05 Operation Permit by: Wesley Sparks RS. date 6/30/05

Authorization to Construct by: Maina M. Dolson RS date 4/28/05 Existing System Inspection by: date

HEALTH DEPT. COPY: WHITE OWNER COPY (FINAL): YELLOW OWNER COPY (INITIAL): PINK