Acknowledgement Of Plans Submittal ONLY!

Date 12/15/04

Date 12/15/2004

This derivative of a Stephen Fuller design is based on an exclusive, non-transferable, one-time license agreement between American Home Gallery, Ltd. Designer and Mac & Kris Barnhardt Owner.

DOOR SCHEDULE						
NO.	SIZE	TYPE	DESCRIPTION	CASING IN	CASING OUT	QTY.
01	2'-6" x 6'8"	INT	six panel	B-P	B-P	4
02	2'-6" x 6'8"	INT	six panel	B-P	C-P	3
03	2'-6" x 6'8"	INT	six panel	C-P	C-P	1
04	2'0" x 6'8"	INT	six panel	B-P	B-P	2
05	2'0" x 6'8"	INT	six panel	C-P	C-P	1
06	2'4" x 6'8"	INT	six panel	C-P	C-P	3
07	2'4" x 6'8"	INT	six panel	B-P	B-P	3
08	2'4" x 6'8"	INT	six panel	B-P	C-P	4
09	2'4" x 6'8"	INT	six panel	C-P	B-P	2
10	2'4"	INT	glass shower			1
11	2'6" x 6'8"	INT	six panel	C-P	C-P	2
12	2'6" x 6'8"	INT	six panel	B-P	A-P	1
13	2'6" x 6'8"	INT	six panel	B-P	B-P	3
14	2'6" x 6'8"	EXT	six panel	B-P	C-P	1
15	2'-2'5" x 6'8"	EXT	french	C-P	2x4 w/BB	1
16	2'-2'6" x 6'8"	EXT	french w/12" trans.	B-P	2x4 w/BB	1
17	2'8" x 6'8"	INT	six panel	C-P	C-P	1
18	2'8" x 6'8"	INT	six panel	B-P	B-P	1
19	2'8" x 6'8"	EXT	six panel	B-P	C-P	1
20	3'0" x 6'8"	EXT	six panel	C-P	2x6 w/BB	1
21	3'0" x 6'8"	EXT	six panel w/2-12" side lites & 12" trans.	A-P	2x6 w/BB	1
22	9'0" x 7'0"	EXT	O.H. garage		2x4 w/BB	2
23	2'8" x 6'6"	EXT	french w/ 12" trans.	B-P	2x4 w/BB	1

LEGEND	
BB	Back Band
BM	Brick Mould
A,B,C	type of casing
P	Paint
S	Stain
Note:	see sheet 7 for casing profiles


WINDOW SCHEDULE				
TYPE	SIZE	EXTERIOR CASING	DESCRIPTION	QTY.
A	3'0" x 6'2"	2x4 w/BB	Double Hung	2
AB	2'4" x 3'2"	2x4 w/BB	Double Hung	2
C	2'4" x 4'2"	2 x 4 w/BB	Double Hung	1
D	2-2'4" x 4'6"	2 x 4 w/BB	D.H. w/4" mull	1
E	2'8" x 4'2"	2 x 4 w/BB	Double Hung	2
F	2'8" x 4'6"	2 x 4 w/BB	Double Hung	2
G	2'8" x 5'2"	2 x 4 w/BB	Double Hung	7
H	2-2'8" x 5'2"	2 x 4 w/BB	D.H. w/ 4" mull	1
I	3-2'8" x 5'2"	2 x 4 w/BB	D.H. w/ 4" mull	1
J	2'8" x 5'6"	2 x 4 w/BB	Stat. arch head w/2-1'4"x4'2" stat.	1
K	2'8" x 6'2"	2 x 4 w/BB	Stat. arch head	2
L	3-2'8" x 6'6"	2 x 4 w/BB	Double Hung	1
M	3'0" x 5'2"	2 x 4 w/BB	D.H. w/2-2'4"x5'2" D.H. w/4" mull	1
N	3'0" x 5'10"	2 x 4 w/BB	D.H. w/2-2'0"x5'10" D.H. w/4" mull	1
O	3'0" x 6'2"	2 x 4 w/BB	Double Hung	1
P	4'0" x 4'2"	2 x 4 w/BB	Stat.	1
Q	4'0" x 5'2"	2 x 4 w/BB	Stat.	2
R	4'0" x 6'6"	2 x 4 w/BB	Stat.	2

ELECTRICAL PLAN KEY

- DUPLEX CONVENIENCE OUTLET
- DUPLEX OUTLET ABOVE COUNTER
- WEATHERPROOF DUPLEX OUTLET
- HALF-SWITCHED DUPLEX OUTLET
- SPECIAL PURPOSE OUTLET
- DUPLEX OUTLET IN FLOOR
- 220 VOLT OUTLET
- ELECTRIC DOOR OPERATOR
- CEILING MOUNTED INCANDESCENT LIGHT FIXTURE
- WALL MOUNTED INCANDESCENT LIGHT FIXTURE
- RECESSED INCANDESCENT LIGHT FIXTURE
- EXHAUST FAN
- EXHAUST FAN/LIGHT COMBINATION
- FLUORESCENT LIGHT FIXTURE
- CEILING FAN/LIGHT

SQUARE FOOTAGE BREAKDOWN	
0262	
FIRST FLOOR	1,609 s.f.
SECOND FLOOR	1,779 s.f.
TOTAL	3,387 s.f.
NOT INCLUDED	
TWO STORY Bonus Room	116 s.f. 320 S.F.

NOTES:
9'-0" FOUNDATION WALL HGT.
9'-0" CLG. HGT. 1ST FLR.
8'-0" CLG. HGT. 2ND. FLR.
OFS: OUTFACE OF STUD
OFM: OUTFACE OF MASONRY
CLG. HGTS. MAY VARY IN BSMT.

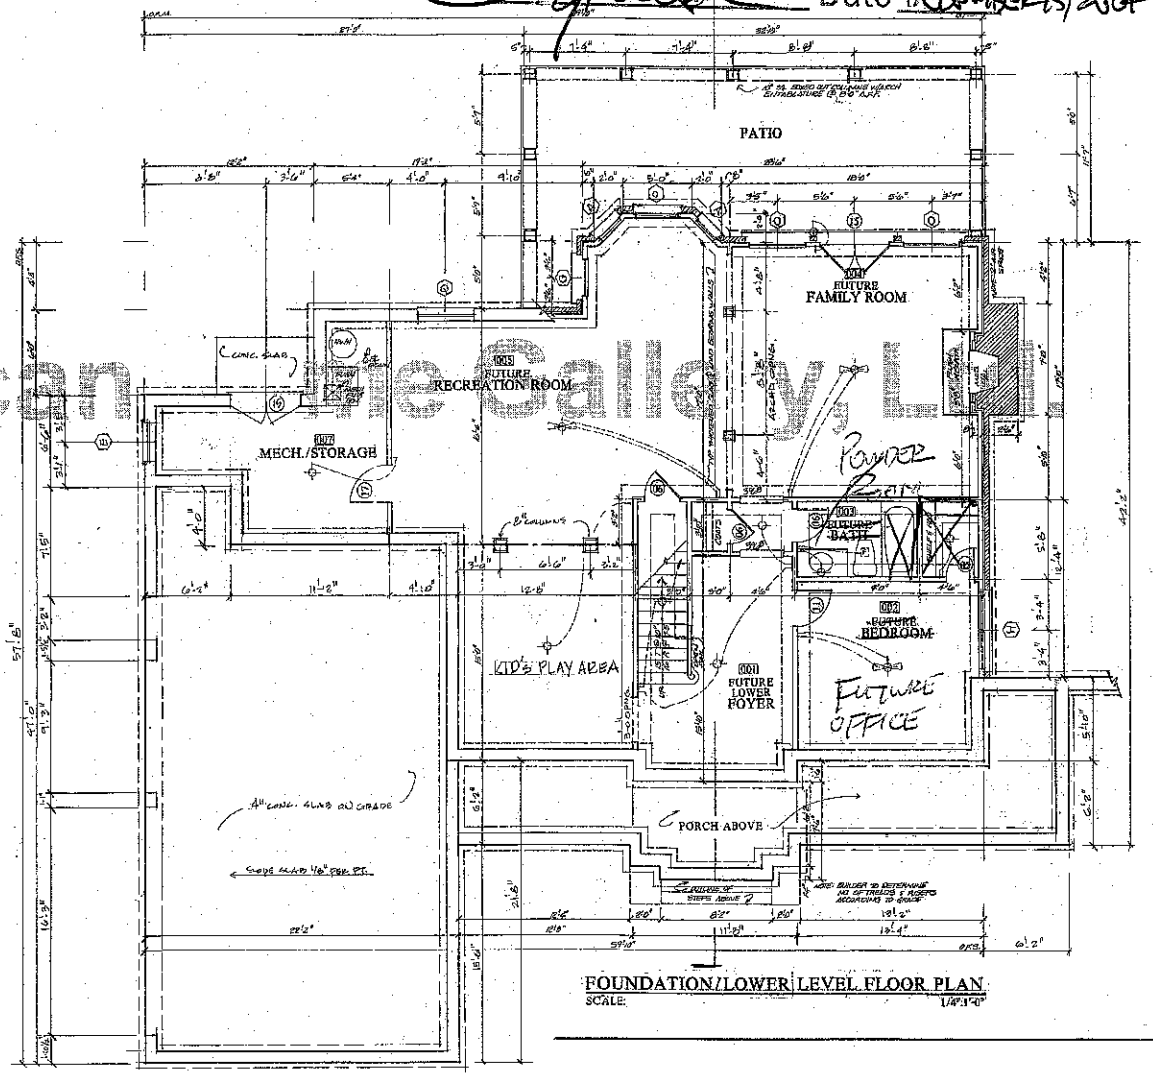

FOUNDATION/LOWER LEVEL FLOOR PLAN
SCALE: 1/4"=1'-0"

American Home Gallery, Ltd.

PROJECT
262 Highpoint





©2000 Stephen Fuller, Inc. dba American Home Gallery, Ltd.

AMERICAN HOME GALLERY
4197 PLEASANT HILL ROAD ♦ DULUTH, GEORGIA 30096
TELEPHONE 678.775.4663 ♦ FACSIMILE 678.775.4664 ♦ www.stephenfuller.com



DATE	REVISED

DRAWN/CHECKED
DT


PROJECT/CODE NO.
262

SHEET TITLE
FOUNDATION / LOWER LEVEL PLAN

SHEET
D1 of 7

INTERIOR ELEVATIONS

SCALE: 1/4"-1'-0"

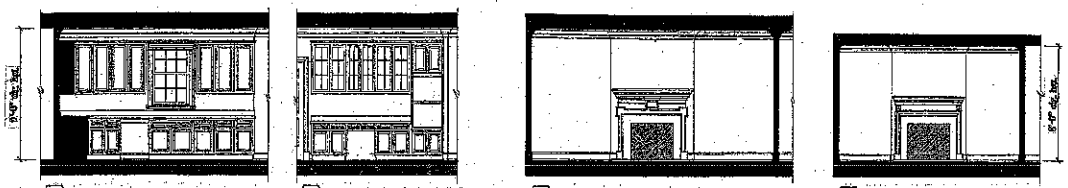

11 D2 KITCHEN FACING REAR

12 D2 KITCHEN FACING FRONT

13 D2 GREAT ROOM FIRE PLACE

14 D2 MASTER BEDROOM FIRE PLACE

DOOR SCHEDULE

NO.	SIZE	TYPE	DESCRIPTION	CASING IN	CASING OUT	QTY.
01	2'-1'6" x 6'8"	INT	six panel	B-P	B-P	4
02	2'-5'6" x 6'8"	INT	six panel	B-P	C-P	3
03	2'-1'6" x 6'8"	INT	six panel	C-P	C-P	1
04	2'0" x 6'8"	INT	six panel	B-P	B-P	2
05	2'0" x 6'8"	INT	six panel	C-P	C-P	1
06	2'4" x 6'8"	INT	six panel	C-P	C-P	3
07	2'4" x 6'8"	INT	six panel	B-P	B-P	3
08	2'4" x 6'8"	INT	six panel	B-P	C-P	4
09	2'4" x 6'8"	INT	six panel	C-P	B-P	2
10	2'4"	INT	glass shower			1
11	2'6" x 6'8"	INT	six panel	C-P	C-P	2
12	2'6" x 6'8"	INT	six panel	B-P	A-P	1
13	2'6" x 6'8"	INT	six panel	B-P	B-P	3
14	2'6" x 6'8"	EXT	six panel	B-P	C-P	1
15	2'-2'6" x 6'8"	EXT	french	C-P	2x4 w/BB	1
16	2'-2'6" x 6'8"	EXT	french w/12" trans.	B-P	2x4 w/BB	1
17	2'8" x 6'8"	INT	six panel	C-P	C-P	1
18	2'8" x 6'8"	INT	six panel	B-P	B-P	1
19	2'8" x 6'8"	EXT	six panel	B-P	C-P	1
20	3'0" x 6'8"	INT	six panel	C-P	2x4 w/BB	1
21	3'0" x 6'8"	EXT	six panel w/2-12" side lites & 12" trans.	A-P	2x4 w/BB	1
22	9'0" x 7'0"	EXT	O.H. garage		2x4 w/BB	2
23	2'8" x 6'8"	EXT	french w/ 12" trans.	B-P	2x4 w/BB	1

WINDOW SCHEDULE

TYPE	SIZE	EXTERIOR CASING	DESCRIPTION	QTY.
A	2'6"x6'0"	2 x 4 w/BB	Double Hung	2
B	2'-5"x 3'5"	2 x 4 w/BB	Double Hung	2
C	2'-4" x 6'-1"	2 x 4 w/BB	Double Hung	1
D	2'-2'4" x 4'6"	2 x 4 w/BB	D.H. w/4" mull	2
E	2'6",4'4"2"	2 x 4 w/BB	Double Hung	2
F	2'6" x 4'6"	2 x 4 w/BB	Double Hung	2
G	2'6" x 5'2"	2 x 4 w/BB	Double Hung	7
H	2'-2'6" x 5'2"	2 x 4 w/BB	D.H. w/ 4" mull	1
I	3'-2'6" x 5'2"	2 x 4 w/BB	D.H. w/ 4" mull	1
J	2'6" x 5'6"	2 x 4 w/BB	Stat. arch head w/2-(4'x5'2" stat.	1
K	2'6" x 6'0"	2 x 4 w/BB	Stat. arch head	2
L	3'-2'6" x 6'6"	2 x 4 w/BB	Double Hung	1
M	3'0" x 5'2"	2 x 4 w/BB	D.H. w/2-2'4"x5'2" D.H. w/4" mull	1
N	3'0" x 5'10"	2 x 4 w/BB	D.H. w/2-2'0"x5'10" D.H. w/4" mull	1
O	3'0" x 6'2"	2 x 4 w/BB	Double Hung	1
P	4'0" x 4'2"	2 x 4 w/BB	Stat.	1
Q	4'0" x 5'2"	2 x 4 w/BB	Stat.	2
R	4'0" x 6'6"	2 x 4 w/BB	Stat.	2

ELECTRICAL PLAN KEY

- DUPLEX CONVENIENCE OUTLET
- DUPLEX OUTLET ABOVE COUNTER
- WEATHERPROOF DUPLEX OUTLET
- HALF-SWITCHED DUPLEX OUTLET
- SPECIAL PURPOSE OUTLET
- DUPLEX OUTLET IN FLOOR
- 220 VOLT OUTLET
- ELECTRIC DOOR OPERATOR
- CEILING MOUNTED INCANDESCENT LIGHT FIXTURE
- WALL MOUNTED INCANDESCENT LIGHT FIXTURE
- RECESSED INCANDESCENT LIGHT FIXTURE
- EXHAUST FAN
- EXHAUST FAN/LIGHT COMBINATION
- FLUORESCENT LIGHT FIXTURE
- CEILING FAN/LIGHT

SQUARE FOOTAGE BREAKDOWN


0262

FIRST FLOOR	1,608 s.f.
SECOND FLOOR	1,779 s.f.
TOTAL	3,387 s.f.
NOT INCLUDED	
TWO STORY BONUS ROOM	116 s.f. 320 s.f.

NOTES:

9'-0" FOUNDATION WALL HGT.
9'-0" CLG. HGT. 1ST FLR.
8'-0" CLG. HGT. 2ND. FLR.
OFS: OUTFACE OF STUD
OFM: OUTFACE OF MASONRY
CLG. HGTS. MAY VARY IN BSMT.

This derivative of a Stephen Fuller design is based on an exclusive, non-transferable, one-time license agreement between American Home Gallery, Ltd. Designer and May & Kris Barnhardt Owner.

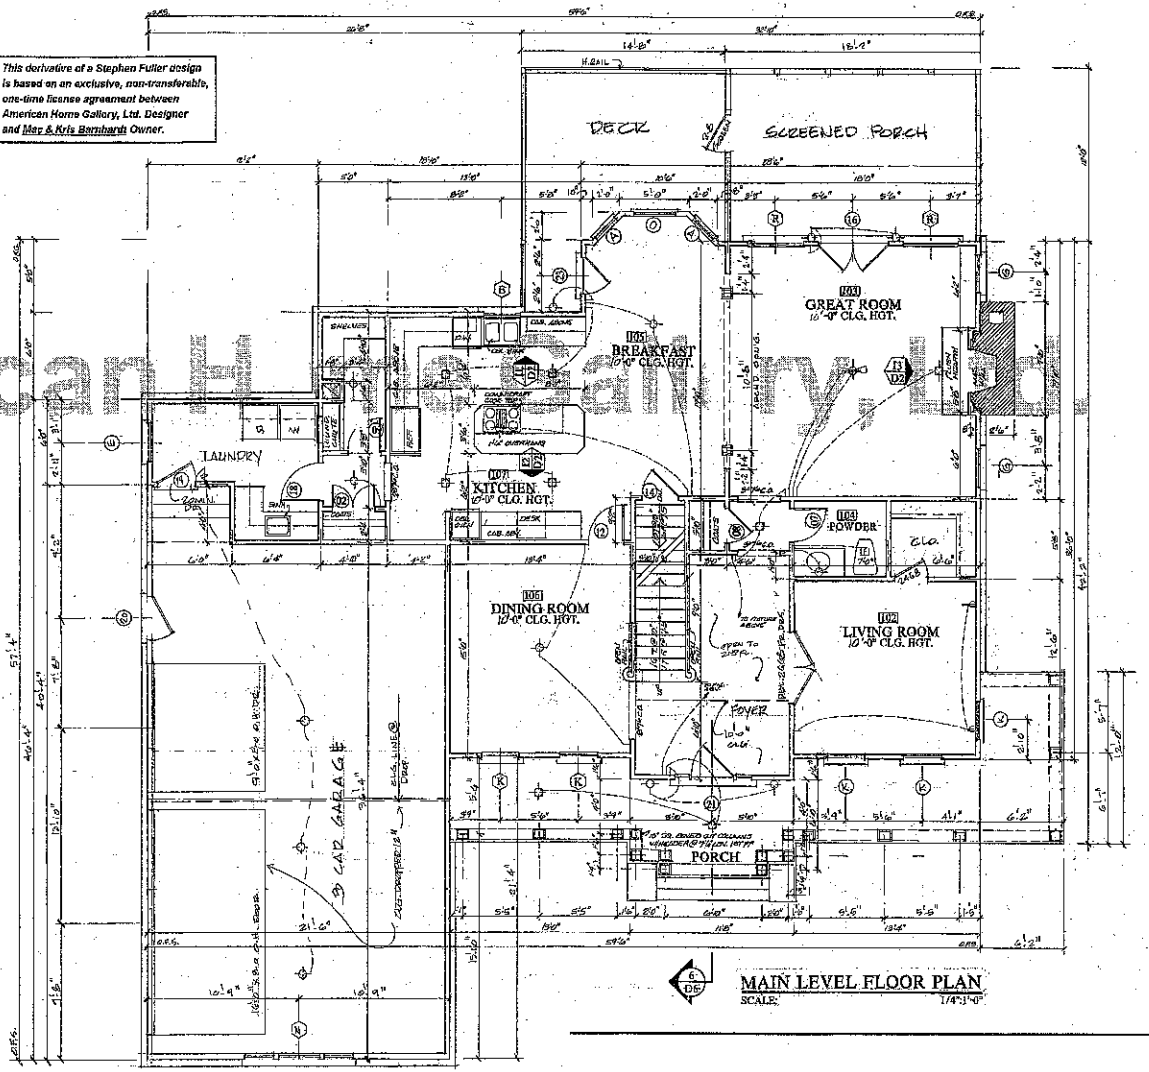

6 D6 MAIN LEVEL FLOOR PLAN

SCALE: 1/4"-1'-0"

American Home Gallery, Ltd.

PROJECT

262 Highpoint




©2010 Stephen Fuller, American Home Gallery, Ltd.

Stephen Fuller
AMERICAN HOME GALLERY
4197 PLEASANT HILL ROAD ♦ DULUTH, GEORGIA 30096
TELEPHONE 678.775.4663 ♦ FACSIMILE 678.775.4664 ♦ www.stephenfuller.com






DATE	REVISED

DRAWN/CHECKED: DT

PROJECT/JOB NO.: 262

SHEET TITLE: MAIN LEVEL FLOOR PLAN

SHEET: D2 of 7

262 Highpoint

DOOR SCHEDULE						
NO.	SIZE	TYPE	DESCRIPTION	CASING IN	CASING OUT	QTY.
01	2-1'6" x 6'8"	INT	six panel	B-P	B-P	4
02	2-1'6" x 6'8"	INT	six panel	B-P	C-P	3
05	2-1'6" x 6'8"	INT	six panel	C-P	C-P	1
04	2'0" x 6'8"	INT	six panel	B-P	B-P	2
05	2'0" x 6'8"	INT	six panel	C-P	C-P	1
06	2'4" x 6'8"	INT	six panel	C-P	C-P	3
07	2'4" x 6'8"	INT	six panel	B-P	B-P	3
08	2'4" x 6'8"	INT	six panel	B-P	C-P	4
09	2'4" x 6'8"	INT	six panel	C-P	B-P	2
10	2'4"	INT	glass shower			1
11	2'6" x 6'8"	INT	six panel	C-P	C-P	2
12	2'6" x 6'8"	INT	six panel	B-P	A-P	1
13	2'6" x 6'8"	INT	six panel	B-P	B-P	3
14	2'6" x 6'8"	EXT	six panel	B-P	C-P	1
15	2-2'0" x 6'8"	EXT	french	C-P	2x4 w/BB	1
16	2-2'6" x 6'8"	EXT	french w/12" trans.	B-P	2x4 w/BB	1
17	2'0" x 6'0"	INT	six panel	C-P	C-P	1
18	2'8" x 6'8"	INT	six panel	B-P	B-P	1
19	2'8" x 6'8"	EXT	six panel	B-P	C-P	1
20	3'0" x 6'8"	EXT	six panel	C-P	2x4 w/BB	1
21	3'0" x 6'8"	EXT	six panel w/2-12" side lites & 12" trans.	A-P	2x4 w/BB	1
22	9'0" x 7'0"	EXT	O.H. garage		2x4 w/BB	2
23	2'8" x 6'8"	EXT	french w/ 12" trans.	B-P	2x4 w/BB	1

LEGEND	
BR	Brick Rand
BM	Brick Mould
A,B,C	type of casing
P	Paint
S	Stain
Note:	se sheet 7 for casing profiles

WINDOW SCHEDULE				
TYPE	SIZE	EXTERIOR CASING	DESCRIPTION	QTY.
A	2'0" x 6'2"	2 x 4 w/BB	Double Hung	2
B	2'6" x 3'2"	2 x 4 w/BB	Double Hung	2
C	2'-2"x5'-4"2"	2 x 4 w/BB	Double Hung	2
D	2'-2"x5'-4"6"	2 x 4 w/BB	D.H. w/ 4" mull	2
E	2'8" x 4'2"	2 x 4 w/BB	Double Hung	2
F	2'8" x 4'6"	2 x 4 w/BB	Double Hung	2
G	2'8" x 5'2"	2 x 4 w/BB	Double Hung	7
H	2'-2'8" x 5'2"	2 x 4 w/BB	D.H. w/ 4" mull	1
I	3-2'8" x 5'2"	2 x 4 w/BB	D.H. w/ 4" mull	1
J	2'8" x 3'6"	2 x 4 w/BB	Stat. arch head w/1-1'4"x3'2" stat.	1
K	2'8" x 6'2"	2 x 4 w/BB	Stat. arch head	2
L	3-2'8" x 6'6"	2 x 4 w/BB	Double Hung	1
M	3'0" x 5'2"	2 x 4 w/BB	D.H. w/2-2'4"x5'2" D.H. w/4" mull	1
N	3'0" x 5'10"	2 x 4 w/BB	D.H. w/2-2'0"x5'10" D.H. w/4" mull	1
O	3'0" x 6'2"	2 x 4 w/BB	Double Hung	1
P	4'0" x 4'2"	2 x 4 w/BB	Stat.	1
Q	4'0" x 5'2"	2 x 4 w/BB	Stat.	2
R	4'0" x 6'6"	2 x 4 w/BB	Stat.	2


ELECTRICAL PLAN KEY

- DUPLEX CONVENIENCE OUTLET
- DUPLEX OUTLET ABOVE COUNTER
- WEATHERPROOF DUPLEX OUTLET
- HALF-SWITCHED DUPLEX OUTLET
- SPECIAL PURPOSE OUTLET
- DUPLEX OUTLET IN FLOOR
- 220 VOLT OUTLET
- ELECTRIC DOOR OPERATOR
- CEILING MOUNTED INCANDESCENT LIGHT FIXTURE
- WALL MOUNTED INCANDESCENT LIGHT FIXTURE
- RECESSED INCANDESCENT LIGHT FIXTURE
- EXHAUST FAN
- EXHAUST FAN/LIGHT COMBINATION
- FLOURESCENT LIGHT FIXTURE
- CEILING FAN/LIGHT

SQUARE FOOTAGE BREAKDOWN 0262	
FIRST FLOOR	1906 s.f.
SECOND FLOOR	1379 s.f.
TOTAL	3285 s.f.
NOT INCLUDED	
TWO STORY BONUS ROOM	116 s.f. 320 S.F.

NOTES:
9'-0" FOUNDATION WALL HGT.
9'-0" CLG. HGT. 1ST FLR.
8'-0" CLG. HGT. 2ND. FLR.
OFS: OUTFACE OF STUD
OFM: OUTFACE OF MASONRY
CLG. HGTS. MAY VARY IN BSMT.

This derivative of a Stephen Fuller design is based on an exclusive, non-transferable, one-time license agreement between American Home Gallery, Ltd. Designer and Mac & Kris Barnhardt Owner.

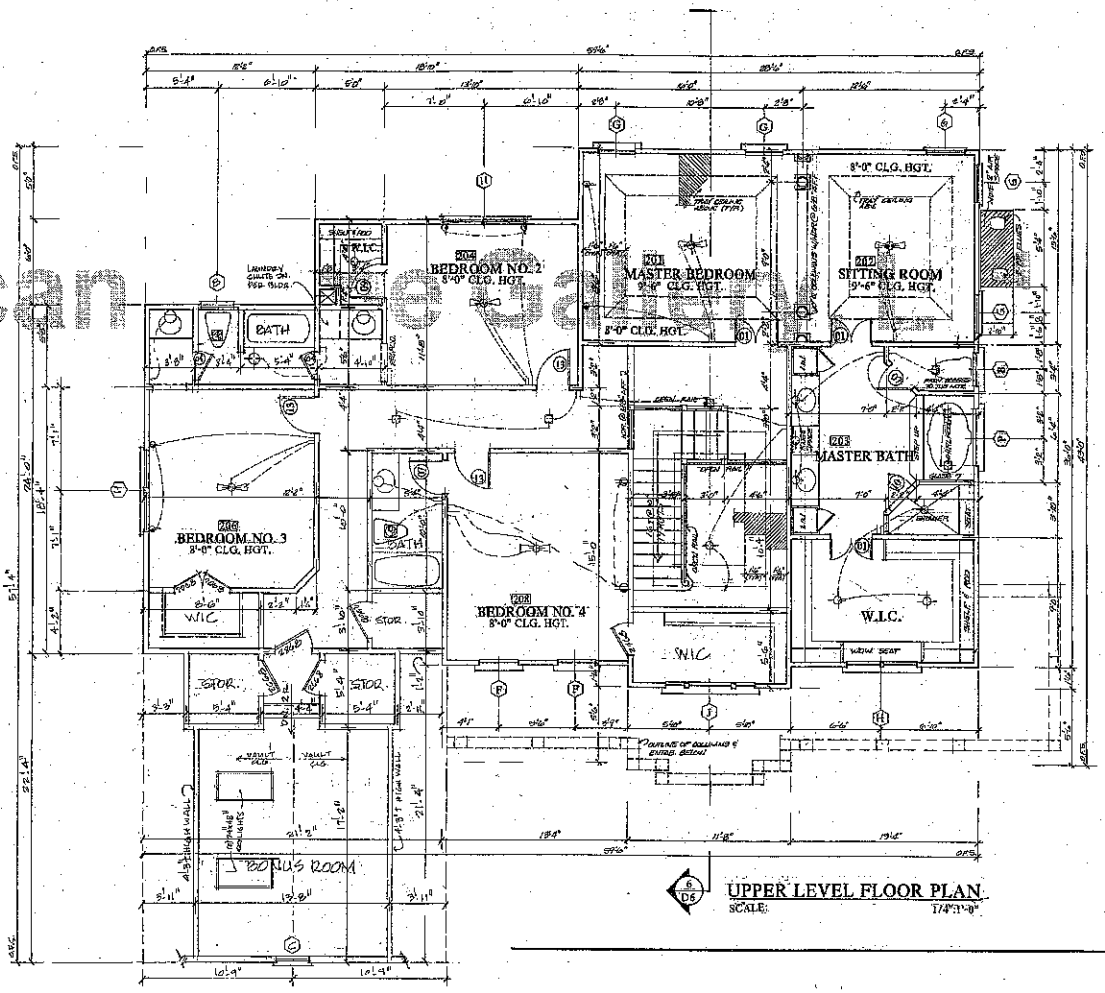

6/D6 UPPER LEVEL FLOOR PLAN
SCALE: 1/4"=1'-0"

American Home Gallery, Ltd.
DESIGNER




©2000 Stephen Fuller Inc. and American Home Gallery, Ltd.

Stephen Fuller
AMERICAN HOME GALLERY
4197 PLEASANT HILL ROAD ♦ DULUTH, GEORGIA 30096
TELEPHONE 678 775 4663 ♦ FACSIMILE 678 775 4664 ♦ www.stephenfuller.com




DATE	REVISED
DRAWN/CHECKED: DT	
PROJECT/TUBE NO.: 262	
SHEET TITLE: UPPER LEVEL FLOOR PLAN	
SHEET: D3 of 7	