COPY

10:30

IREDELL COUNTY HEALTH DEPARTMENT

STATESVILLE 704-878-5305 MOORESVILLE 704-664-5281

IMPROVEMENT PERMIT / AUTHORIZATION TO CONSTRUCT / OPERATION PERMIT / EXISTING SYSTEM INSPECTION

PERMIT # 112009 PIN # 4626-74-5454 (Whitley) DATE JULY-8-2003

OWNER or APPLICANT CRESCENT RESOURCES INC / LAKE FORREST PHONE: Business Home:

OWNER or APPLICANT ADDRESS PO BOX 1003 CHARLOTTE NC

LOCATION / DIRECTIONS

SUBDIVISION THE FARMS BLOCK / SECTION 1 LOT # 44/44A LOT AREA .901+.393AC DESIGN FLOW 480GPD L.T.A.R. .25-.3 SFE

Septic Tank 1000 Gallons: STB 4444 Date 6-29-10
Pump Tank 1000 Gallons: PT 283 Date 6-29-10
Pump Make Gould's Model WE1012HL Serial # F1D00411
Nitrification Field No Fields 1 No Lines 4 Linear Feet 440'
Trench Width 36" Max. Trench Bottom Depth 36" Gravel Depth —

☒ New System ☐ Repair ☐ Expansion System Type I II III IV V VI
System Description: PM - 25% REDUCTION
Repair System Description: PM/LP 25-50% REDUCTION SFE
Maintenance Agreement Required ☐ YES ☒ NO
☐ GRAVITY ☒ PRESSURE

☒ Residence No. Bedrooms 4
☐ Business No. Persons
☐ Other No. Employees
☐ Slab ☐ Crawl Space
☒ Basement w/plumbing ☐ Basement w/o plumbing


Water Supply: ☐ Private ☐ Public ☒ Community

Comments / Conditions

Comments / Conditions 8/12/10 Checked tanks, lines & Set pressure ~ 2½ ft. >50ft to Neighbor's well

Neighbor's Well

INITIAL SITE SKETCH

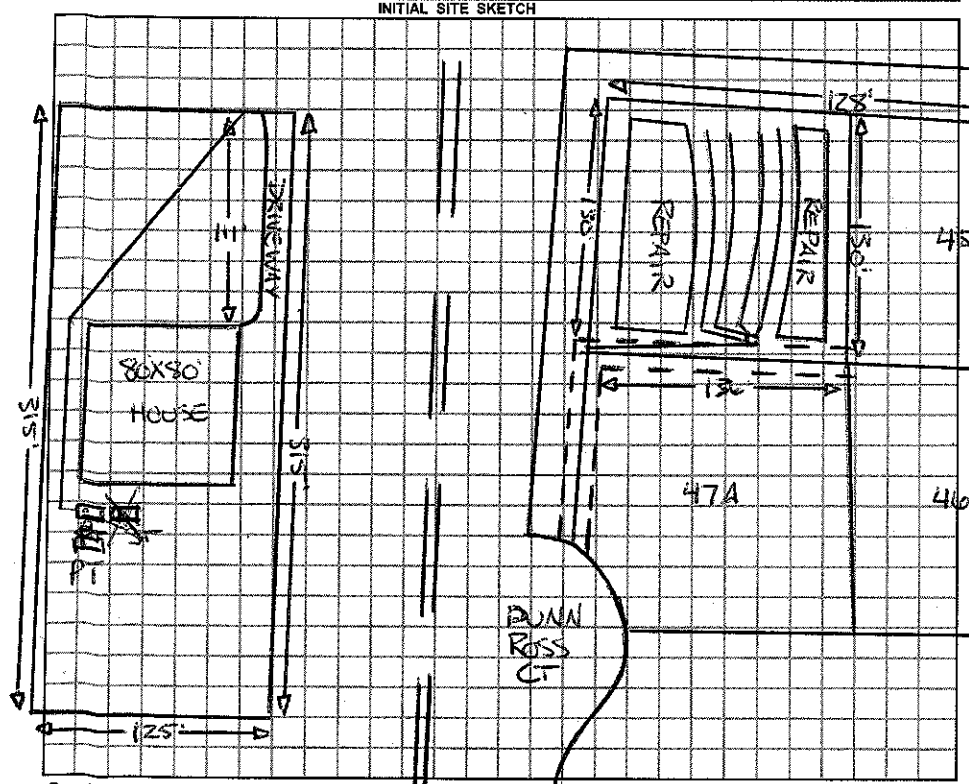

AS BUILT SKETCH

* NOTE *

PERMIT PER DAVID HIXSON

REDRAWN BECAUSE PERMIT IS NO LONGER EXPIRED BECAUSE OF RULE CHANGE

Used ADS36 plastic Chambers, installed

Permit can be suspended or revoked if any false information is supplied toward securing the permit / any unauthorized changes are made to the site / any unauthorized changes are made in the installation of the system.

☐ IMPROVEMENT PERMIT w / plan valid without expiration. ☒ IMPROVEMENT PERMIT w / site plan valid for 60 mos. ☒ AUTHORIZATION TO CONSTRUCT valid for period equal to IMPROVEMENT PERMIT-not to exceed 60 mo.

Owner / Applicant Signature: John R Whitley Date 3/30/10

Improvement Permit by: REHS Date 3-30-10

Authorization to Construct by: REHS Date 3-30-10

Installed by: Kevin Hollman

Operation Permit by: REHS Date: 7-7-11

Existing System Inspected by: Date:

YOU SHOULD CONTACT A LOCATOR SERVICE PRIOR TO ANY EXCAVATION.

WHITE COPY Environmental Health YELLOW COPY (Final) Owner / Applicant PINK COPY (Initial) Owner / Applicant