IREDELL COUNTY HEALTH DEPARTMENT

STATESVILLE 704-878-5305 MOORESVILLE 704-664-5281

IMPROVEMENT PERMIT / AUTHORIZATION TO CONSTRUCT / OPERATION PERMIT / EXISTING SYSTEM INSPECTION

Gerald Tucker #57 1/30

PERMIT# 11205 PIN# ~~4626-63-7355.45~~ 4626-74-6460 DATE July 10, 03

OWNER OR CONTRACTOR Crescent Resources Inc/Lakeforest Estates LLC/Robinette Bkr PHONE: Business _____ Home _____

ADDRESS P.O. Box 1003, Charlotte, N.C.

LOCATION Brawley Sch Rd. TR Southfork Bear Right on Agnew TR Caldwell Creek TR Magnolia Farms Lot on Right near end 115FE on Dunn Ross Ct.

SUBDIVISION The Farms BLOCK / SECTION 1 LOT 45/45A LOT AREA .934 + .394 Ac SITE CLASS PS for 115FE DESIGN FLOW 480gpd L.T.A.R. .25+.3 (SFE 45A)

Septic Tank: 1000 Gallons; STB 338 Date 5-14-05
Pump Tank: 1000 Gallons; PT 283 Date 5-15-05
Pump Make: Myers Model ME152 Serial No. _____
Nitrification Field: No Fields 1 Square Feet 560/840 Linear Feet 280
No Lines 4@70' Trench Width 24" MIN 36" Max Trench Bottom Depth 36" Gravel Depth N/A

☑ New System ☐ Repair System Type: I, II, III, ☑ IV, V, VI
System Description: LPPPBPS
Repair System Description: LPPPBPS
Maintenance Agreement Required: ☑ Yes ☐ No

☑ House/Mod. Home No. Bedrooms 4
☐ Mobile Home No. Bathrooms 4
☐ Business No. Employees _____
☐ Other _____


☐ Slab ☐ Crawl Space ☑ Basement w/plumbing ☐ Basement wo/plumbing

Water Supply: ☐ Individual ☑ Public ☑ Community

Comments:/Conditions: 36" max 9'oc Pressure eleaf & alarm
Checked 9/1/05

Comments:/Conditions Checked tanks 6/17/05
Must keep future pool 15' off Septic system
3/16" hole drilled.
Checked 3 of 4 lines 7/22/05
Checked 4th lin 7/25/05

INITIAL SITE SKETCH

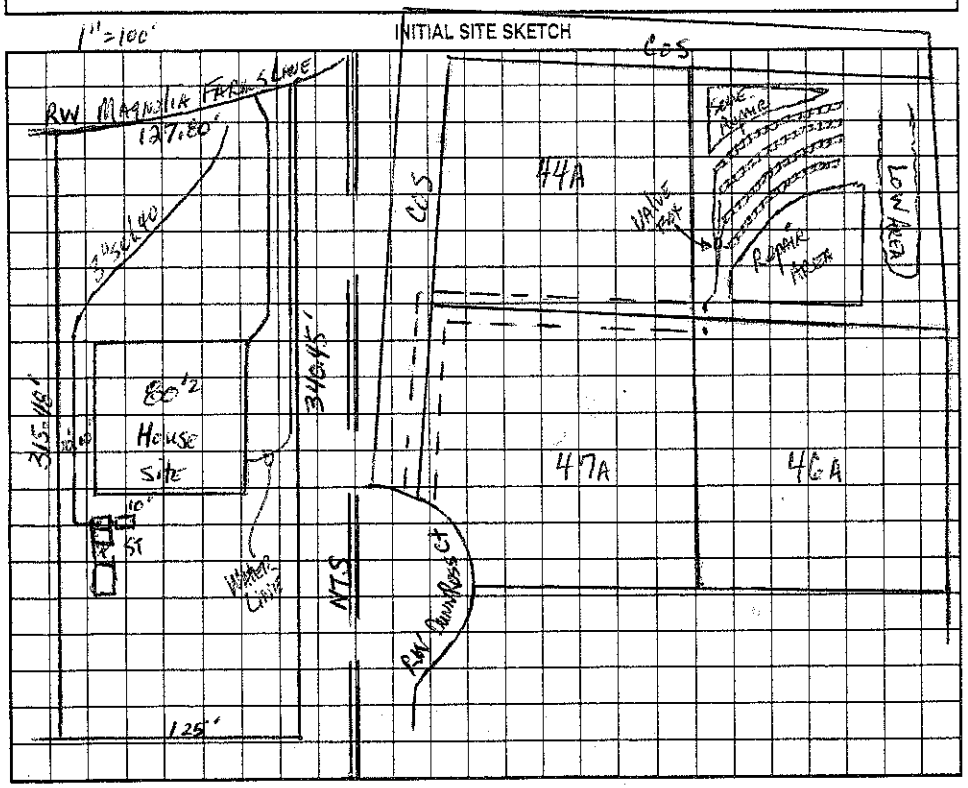

AS BUILT SKETCH

Installed as Drawn

Permit can be suspended or revoked if any false information is supplied toward securing the permit/any unauthorized changes are made to the site/any unauthorized changes are made in the installation of the system. Improvement Permit with plat valid without expiration. Improvement Permit with site plan valid for sixty months. Authorization to Construct is valid for a period equal to that of Improvement Permit – not to exceed sixty months.

Signed: _____ date 7-14-03 Installed by: Gerald Tucker RS 9/1/05

Improvement Permit by: _____ RS date 7-10-03 Operation Permit by: _____ date 9/1/05

Authorization to Construct by: _____ RS date 12/7/04 Existing System Inspection by: _____ date _____

HEALTH DEPT. COPY: WHITE OWNER COPY (FINAL): YELLOW OWNER COPY (INITIAL): PINK