IREDELL COUNTY HEALTH DEPARTMENT

STATESVILLE 704-878-5305 MOORESVILLE 704-664-5281

50.00 Part #2 3100

IMPROVEMENT PERMIT / AUTHORIZATION TO CONSTRUCT / OPERATION PERMIT / EXISTING SYSTEM INSPECTION

PERMIT# 112094 PIN# ~~4626373315~~ 4026751080 DATE 1-7-05

OWNER OR CONTRACTOR Anwar & Angie Husein PHONE: Business _____ Home 799-7495

ADDRESS _____

LOCATION Brawley School Rd TR, SouthFork bear right on Agnew TR Caldwell Creek TR Magnolia Farms on left

SUBDIVISION The Farms BLOCK / SECTION 1 LOT 59 LOT AREA 1.63 Acre SITE CLASS. PS DESIGN FLOW 480gpd L.T.A.R. .3

Septic Tank: 1000+ Gallons; STB 338 Date 12-28-04 ☒ New System ☐ Repair System Type: I, II, III, IV, V, VI

Pump Tank: 1000 Gallons; PT 27 Date 10-24-04 System Description: Pump (PM) 25% Reduction Field 2

Pump Make: Myers Model ME50S-2 Serial No. _____ Repair System Description: Partial Panel Blk & L-PP

Nitrification Field: No Fields 2 Square Feet 1512 Linear Feet 504 Maintenance Agreement Required: ☐ Yes ☒ No

Drain Field #2 No Lines 7 Trench Width 36" Max Trench Bottom Depth 36" Gravel Depth N/A

☒ House/Mod. Home No. Bedrooms 4 ☐ Mobile Home No. Bathrooms 3.5 ☐ Business No. Employees ____ ☐ Other _____

☐ Slab ☒ Crawl Space ☐ Basement w/plumbing ☐ Basement wo/plumbing


Water Supply: ☐ Individual ☒ Public ☒ Community

Comments:/Conditions:

FD = Flow Divider
PM = Pressure Manifold

INITIAL SITE SKETCH

Scale 1:60

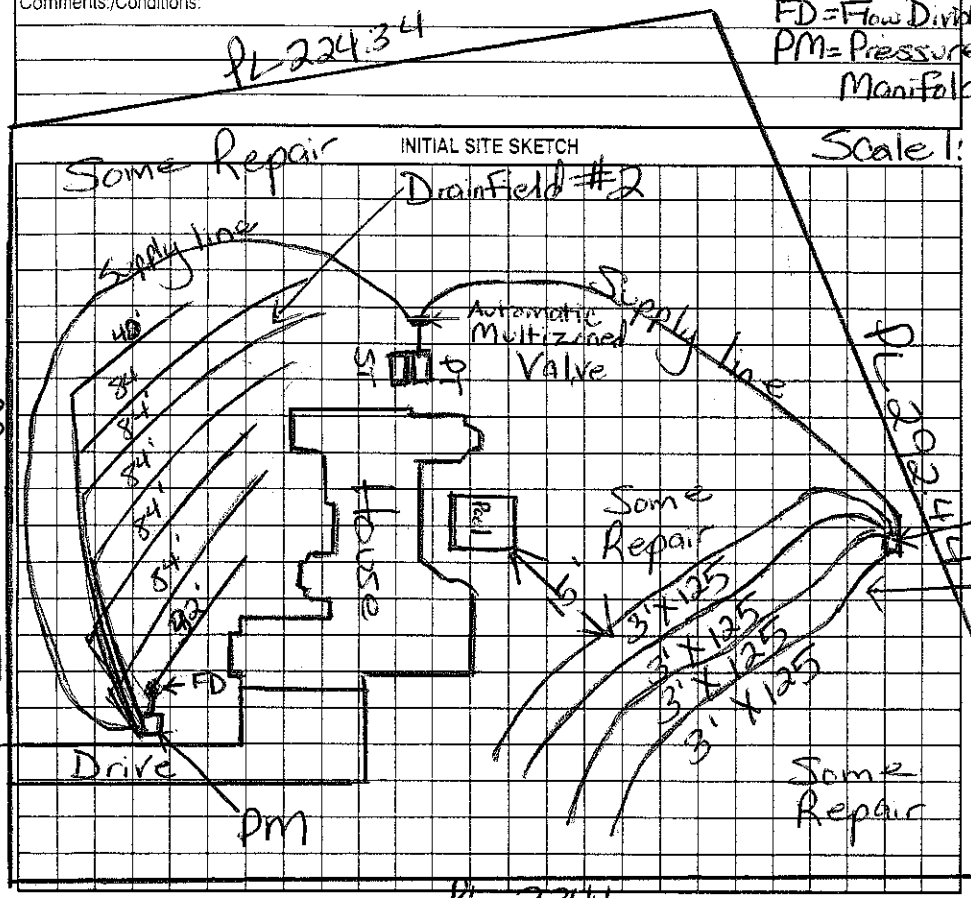

Comments:/Conditions:

Note: Use Flow Divider (FD) after Pressure Manifold (PM) to split flow between 2 - 42' drain lines

Keep Pool at least 15' from any part of Septic System.

AS BUILT SKETCH

Checked tanks & lines 1/28/05
Used Quick 4 Plastic Chambers
Pressure, elect & alarm 5/26/05

PM

Drainfield #1 Installed & inspected 4/21/04 (See attached)

Permit can be suspended or revoked if any false information is supplied toward securing the permit/any unauthorized changes are made to the site/any unauthorized changes are made in the installation of the system. Improvement Permit with plat valid without expiration. Improvement Permit with site plan valid for sixty months. Authorization to Construct is valid for a period equal to that of Improvement Permit – not to exceed sixty months.

Signed: Tonya Jacobs date 1-7-05

Improvement Permit by: Maria H. Dotson RS date 1/7/05

Authorization to Construct by: Maria H. Dotson RS date 1/7/05

Installed by: R & H

Operation Permit by: Maria H. Dotson RS. date 5/26/05

Existing System Inspection by: _____ date _____

HEALTH DEPT. COPY: WHITE OWNER COPY (FINAL): YELLOW OWNER COPY (INITIAL): PINK

IREDELL COUNTY HEALTH DEPARTMENT

STATESVILLE 704-878-5305 — MOORESVILLE 704-664-5281

D Part #1

IMPROVEMENT PERMIT / AUTHORIZATION TO CONSTRUCT / OPERATION PERMIT / EXISTING SYSTEM INSPECTIO

PERMIT# 112094 PIN# 4626637315.59 DATE 2/26/04

OWNER OR CONTRACTOR The Hoke Company PHONE: Business 704 799-7495 Home

ADDRESS P.O. Box 4448 Mooresville NC 28117

LOCATION Brawley School Rd TR South Fork bear right on Agnew TR Caldwell Creek TR Magnolia Farms on left

SUBDIVISION The Farms BLOCK / SECTION 1 LOT 59 LOT AREA 1.63 Acre SITE CLASS. PS DESIGN FLOW 480gpd L.T.A.R. .25

Septic Tank: 1000 Gallons; STB Date

Pump Tank: 1000 Gallons; PT Date

Pump Make: Model Serial No.

Nitrification Field: No Fields 1 Square Feet 1500' Linear Feet 500'

No Lines 4@125' Trench Width 36" Max Trench Bottom Depth 20" Gravel Depth N/A

☒ New System ☐ Repair System Type: I, II, (III) IV, V, VI

System Description: Shallow Pump (Pm) 25% Reduction

Repair System Description: Partial Panel Block & LPP

Maintenance Agreement Required: ☐ Yes ☒ No

☒ House/Mod. Home ☐ Mobile Home ☐ Business ☐ Other

No. Bedrooms 4 No. Bathrooms 3.5 No. Employees

☐ Slab ☒ Crawl Space ☐ Basement w/plumbing ☐ Basement wo/plumbing

Water Supply: ☐ Individual ☒ Public ☒ Community

Comments:/Conditions:

ft - 224.34'

Comments:/Conditions:


☒ Keep trench bottom Shallow

☒ Must keep Swimming pool at least 15' from any part of Septic System

Lines checked 4/21/04 by GM

INITIAL SITE SKETCH

Scale 1:60

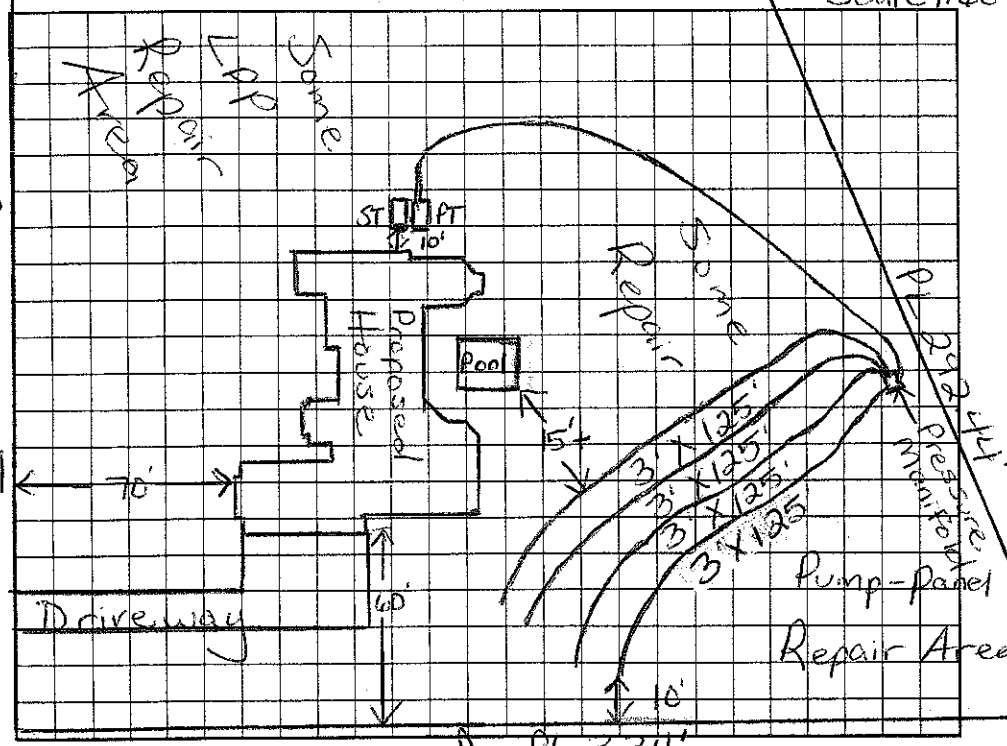

AS BUILT SKETCH

Pressure checked 5/25/05

Permit can be suspended or revoked if any false information is supplied toward securing the permit/any unauthorized changes are made to the site/any unauthorized changes are made in the installation of the system. Improvement Permit with plat valid without expiration. Improvement Permit with site plan valid for sixty months. Authorization to Construct is valid for a period equal to that of Improvement Permit -- not to exceed sixty months.

Signed: date 3/1/04

Improvement Permit by: Maria H. Dotson RS. date 2/27/04

Authorization to Construct by: Maria H. Dotson RS date 2/27/04

Installed by: R+H

Operation Permit by: Maria H. Dotson RS date 5/26/05

Existing System Inspection by: date

HEALTH DEPT. COPY: WHITE OWNER COPY (FINAL): YELLOW OWNER COPY (INITIAL): PINK