IREDELL COUNTY HEALTH DEPARTMENT

STATESVILLE 704-878-5305 MOORESVILLE 704-664-5281

IMPROVEMENT PERMIT / CERTIFICATE OF COMPLETION / OPERATION PERMIT / EXISTING SYSTEM INSPECTION

PROPERTY DESCRIPTION NO. 19851 DATE 3/20/95 TAX MAP NO. 2F-4-131 Watershed: ☐ Yes ☒ No

OWNER OR CONTRACTOR Evette Payne PHONE: Business _____ Home 664-1280

ADDRESS Rt 4 Box 162 Mocksville NC. 28115

LOCATION Mc Kendree Ch. Rd. Turn left 6th house on left

SUBDIVISION _____ BLOCK / SECTION _____ LOT _____ LOT AREA _____ SITE CLASS. P DESIGN FLOW 240 L.T.A.R. .3

Septic Tank: 1000 Gallons; STB 794 Date 12/12/94

Pump Tank: _____ Gallons; PT _____ Date _____

Pump Make: _____ Model _____ Serial No. _____

Nitrification Field: No Fields 1 Square Feet 800 Linear Feet 266

No Lines 3 Trench Width 36" Max Trench Bottom Depth 32" Gravel Depth 12"

☒ New System ☐ Repair System Type: I, ☒ II, III, IV, V, VI

System Description: Conv.

Repair System Description: Conv.

Maintenance Agreement Required: ☐ Yes ☒ No

☐ House/Mod. Home ☒ Mobile Home ☐ Business ☐ Other

No. Bedrooms 2 No. Bathrooms 1.5 No. Employees ____


☐ Slab ☒ Crawl Space ☐ Basement w/plumbing ☐ Basement wo/plumbing

Water Supply: ☒ Individual ☐ Community ☐ Public Parents

Comments: Shallow trenches, lines on slope contour

Comments: installed as shown on insp. Permit

INITIAL SITE SKETCH

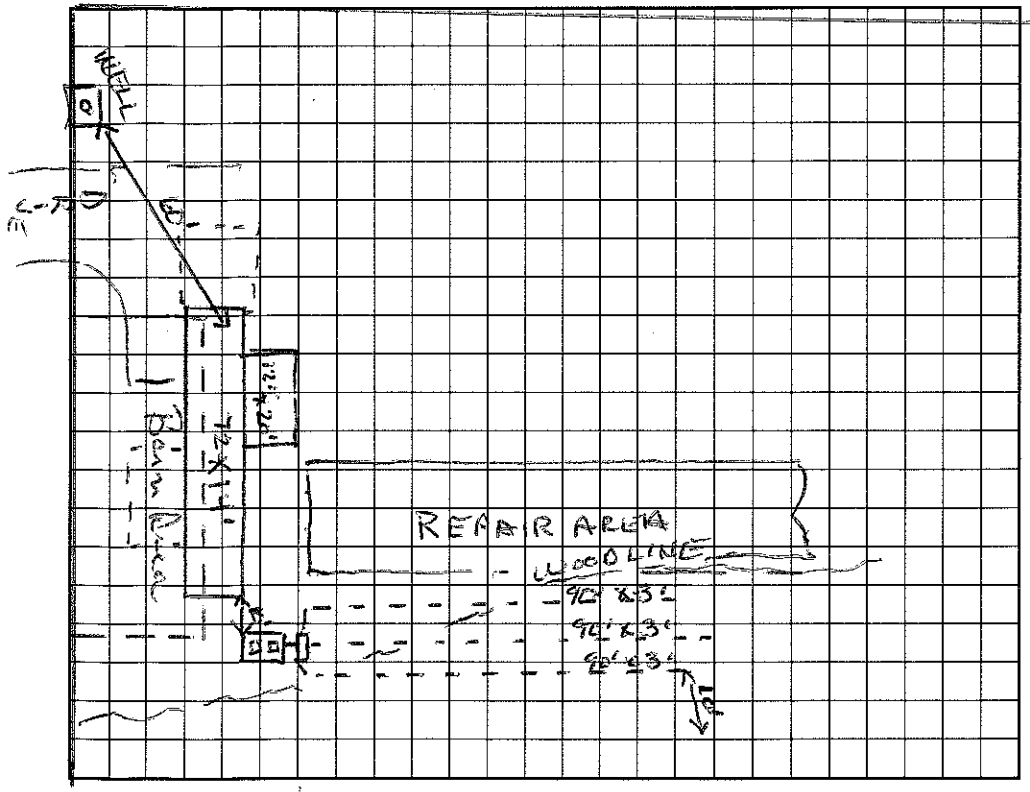

AS BUILT SKETCH

I understand that this permit can be suspended or revoked if any false information is supplied toward securing the permit/any unauthorized changes are made to the site/any unauthorized changes are made in the installation of the system. Improvement Permit is valid for 60 months from date of issuance.

Signed: X Evette W. Payne

Improvement Permit by: Wesley Sparks R.S. date 3/21/95

Existing System Inspection by: _____ date _____

Installed by: A Complies Grading

Certificate of Completion by: Wesley Sparks R.S. date 4/6/95

Operation Permit by: _____ date _____

HEALTH DEPT. COPY: WHITE INSPECTION COPY (FINAL): GREEN OWNER COPY (FINAL): YELLOW INSPECTION COPY (INITIAL): PINK OWNER COPY (INITIAL): GOLD