# IREDELL COUNTY HEALTH DEPARTMENT

Statesville Office (704) 878-5305 Mooresville Office (704) 660-3625 PERMIT # 221017

## IMPROVEMENT PERMIT / AUTHORIZATION TO CONSTRUCT / OPERATION PERMIT / EXISTING SYSTEM

PIN # 4626-75-6785

APPLICANT: RAYMOND YOST APPLICANT ADDRESS: 114 RIDGE BROOK DR. - MRSVL

SITE ADDRESS: SAME PHONE: 704-658-8960 ALT. PHONE:

SITE DIRECTIONS: BSR, TR MCKENDREE, TR CARRIE, TL RIDGE BROOK, ON L

SUBDIVISION: BROOK RIDGE SHORES SECTION: 4 LOT # 14 LOT AREA: .58 AC DESIGN FLOW: 360 L.T.A.R.: .3

Septic Tank ____ (gal) STB ____ Date ____
Pump Tank ____ (gal) PT ____ Date ____
Pump Make ____ Model ____ Serial # ____
# Nitrification Fields EXISTING # Lines ____ Linear Ft: ____
Trench Width ____ Max. Trench Bottom Depth ____ Gravel Depth ____

☐ New System ☐ Repair ☐ Expansion System Type: I II III IV V VI
System Description: CONVENTIONAL
Repair System Description: PANEL
Maintenance Agreement Required: ☐ YES ☒ NO
☒ GRAVITY ☐ PRESSURE

☐ Residence No. Bedrooms 3
☐ Business No. Persons 6
☒ Other No. Employees
☒ Slab ☐ Crawl Space
☐ Basement w/plumbing ☐ Basement w/o plumbing


Water Supply: ☒ Private ☐ Public ☐ Community

Comments / Conditions: SEE ATTACHED WELL VARIANCE

GARAGE

INITIAL SITE SKETCH

AS BUILT SKETCH

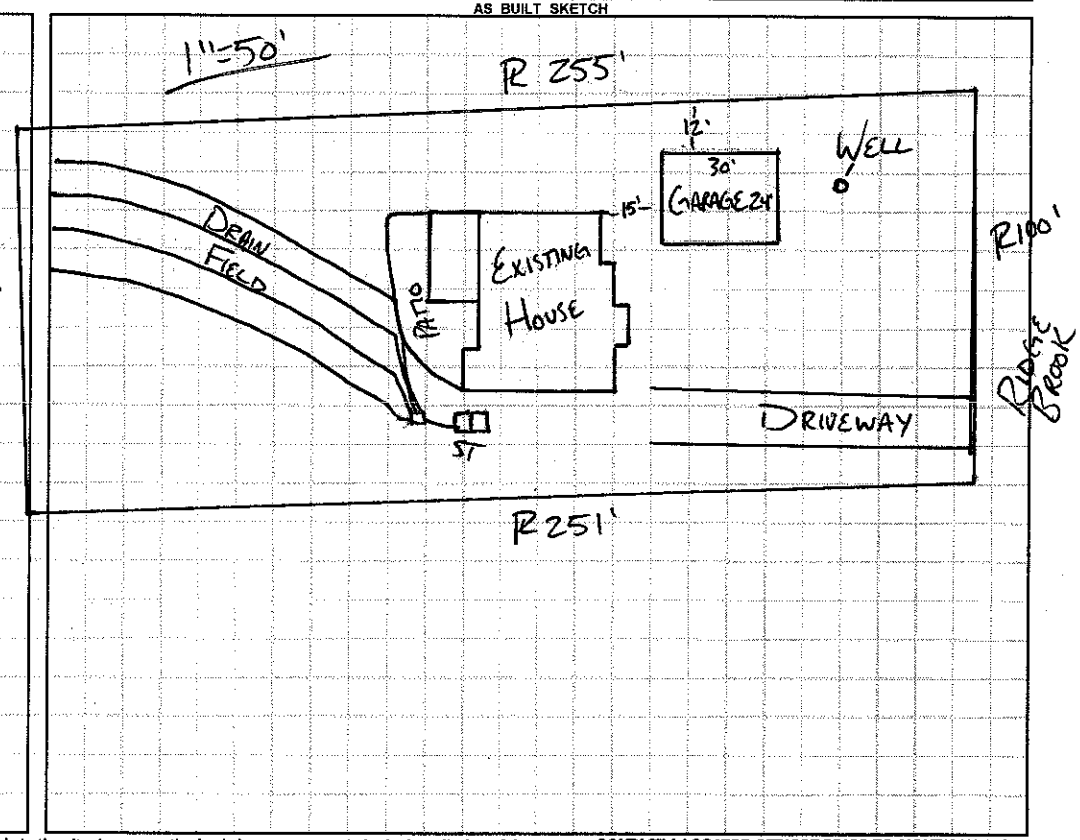


*Permit can be suspended or revoked if any false information is supplied toward securing the permit / any unauthorized changes are made to the site / any unauthorized changes are made in the installation of the system.* **CONTACT A LOCATOR SERVICE PRIOR TO ANY EXCAVATION**

☐ **IMPROVEMENT PERMIT** *with plat valid without expiration.* ☐ **IMPROVEMENT PERMIT** *with site plan valid for 60 mos.* ☐ **AUTHORIZATION TO CONSTRUCT** *valid for period equal to IMPROVEMENT PERMIT--not to exceed 60 mo.*

Owner / Applicant Signature: [signature] Date: 10-26-16 Installed by: ____

IMPROVEMENT PERMIT by: ____ Date: ____ OPERATION PERMIT by: ____ Date: ____

AUTHORIZATION TO CONSTRUCT by: ____ Date: ____ Existing System Inspected by: [signature] Date: 9-29-16

Health Dept. Copy - WHITE Applicant (Final Approval) - YELLOW Applicant (Cor