IREDELL COUNTY HEALTH DEPARTMENT

PIN# 4626-75-6785

STATESVILLE 704-878-5305 MOORESVILLE 704-664-5281

IMPROVEMENT PERMIT / CERTIFICATE OF COMPLETION / OPERATION PERMIT / EXISTING SYSTEM INSPECTION

PROPERTY DESCRIPTION NO. 16484 DATE June 10, '93 TAX MAP NO. 2F10B14

OWNER OR CONTRACTOR Rick Howell Ent PHONE: Business 892-1020 Home

ADDRESS 16201 Jetton Road, Huntersville, NC 28078

LOCATION 1100 TR 1115 phase TR Angie Lane TL Ridgebrook Dr. 2nd lot on left

SUBDIVISION Brookridge Shores BLOCK / SECTION 4 LOT 14 LOT AREA 100'X253' SITE CLASS. 2 L.T.A.R. .13

Water Supply: ☑ Individual ☐ Community ☐ Public

Septic Tank: 1000 Gallons; STB 794 - Dellinger Date 8-19-93

Pump Tank: Gallons; PT Date

Nitrification Field: No Fields 1 Square Feet 1200 Linear Feet 400

No Lines 4 Trench Width 36" Trench Depth 24"-30" Gravel Depth 12"

☑ New System ☐ Repair System Type: I, II, III, IV, V, VI

System Description: gravity conventional

Repair System Description: ~~Same~~ PPBPS

Maintenance Agreement Required: ☐ Yes ☑ No

☑ House/Mod. Home No. Bedrooms 3 Garbage Disposal: ☐ Yes ☑ No

☐ Mobile Home No. Bathrooms 2 Auto. Dishwasher: ☑ Yes ☐ No

☐ Business No. Employees Auto. Washing Machine: ☑ Yes ☐ No


☐ Other Other

☐ Slab ☑ Crawl Space ☐ Basement w/plumbing ☐ Basement wo/plumbing


Comments Exit plumbing at existing grade in rear in order to accomodate specified trench bottom depth. Follow contour.

System installed 10-15-93; well not abandoned as of this date.

INITIAL SITE SKETCH

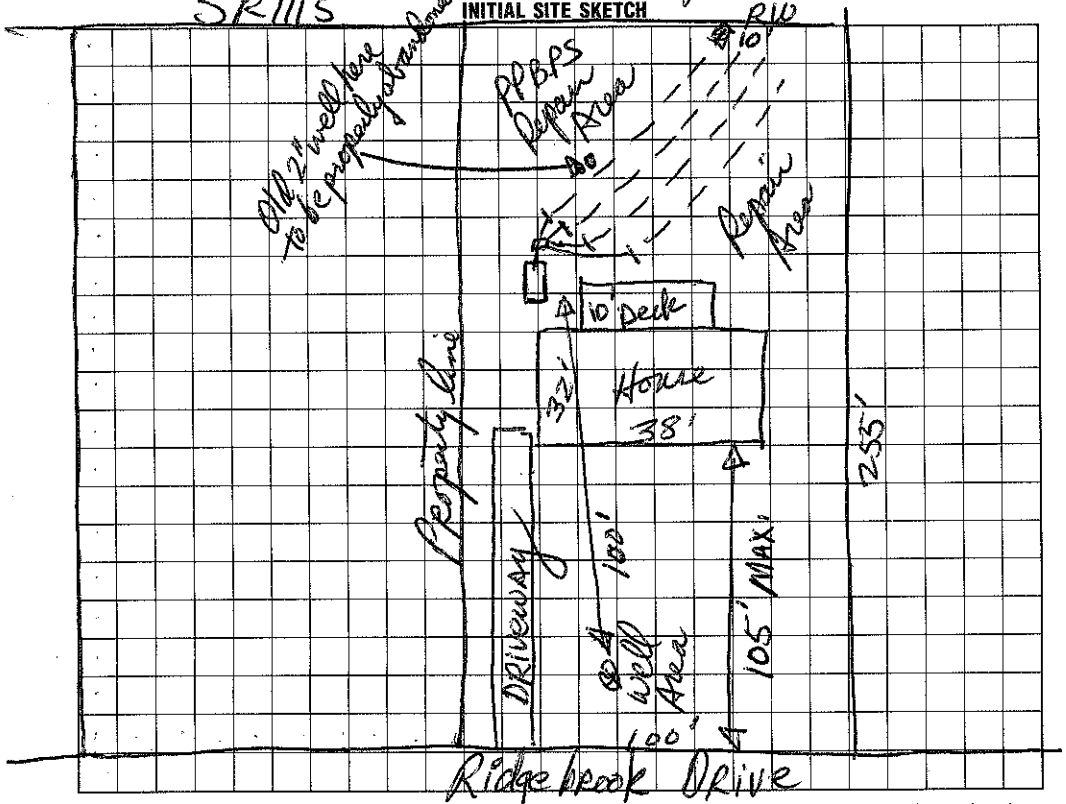

AS BUILT SKETCH

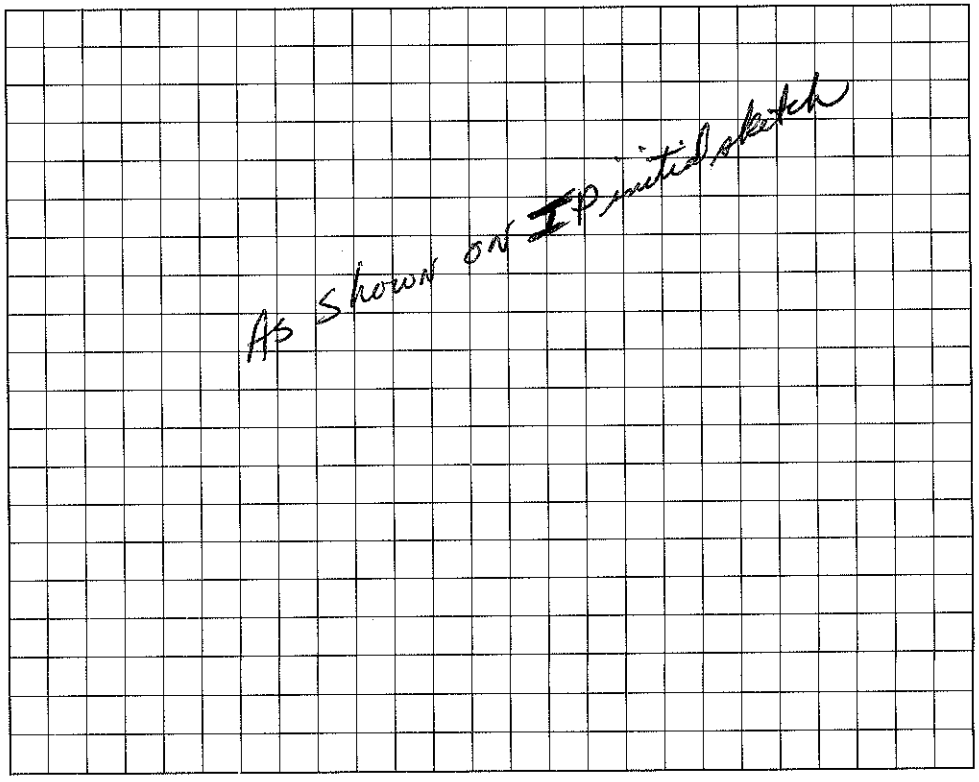

I understand that this permit can be suspended or revoked if any false information is supplied toward securing the permit/any unauthorized changes are made to the site/any unauthorized changes are made in the installation of the system. Improvement Permit is valid for 60 months from date of issuance.

Signed: X Rick Howell

Improvement Permit by: James R. Hinson, RS date 6/16/93

Existing System Inspection by: date

Installed by:

Certificate of Completion by: James R. Hinson, RS date 10/21/93

Operation Permit by: date

HEALTH DEPT. COPY: WHITE INSPECTION COPY (FINAL): GREEN OWNER COPY (FINAL): YELLOW INSPECTION COPY (INITIAL): PINK OWNER COPY (INITIAL): GOLD