# IREDELL COUNTY HEALTH DEPARTMENT

STATESVILLE 704-878-5305 MOORESVILLE 704-664-5281

## IMPROVEMENT PERMIT / CERTIFICATE OF COMPLETION / OPERATION PERMIT / EXISTING SYSTEM INSPECTION

PROPERTY DESCRIPTION NO. 15996 DATE 6/21/95 TAX MAP NO. 2F 10 A 13 4626 75 6801 Watershed: ☐ Yes ☒ No

OWNER OR CONTRACTOR 527 Ridge St. Mooresville, NC. 28115 PHONE: Business Home 663-4797

ADDRESS Brad D. Newton

LOCATION McLendon TR 1st Brookridge (corner lot) TL on Ridgebrook to 3rd lot on R

SUBDIVISION Brookridge Shores BLOCK / SECTION 4 LOT 13 LOT AREA ~ 20,000 FT² SITE CLASS. P DESIGN FLOW 360 L.T.A.R. .35

Septic Tank: 1000 Gallons; STB 794 Date 6/4/96

Pump Tank: 900 Gallons; PT 47 Date 5/16/96

Pump Make: GOULDS Model WW0511A Serial No. 9766601103

Nitrification Field: No Fields 1 Square Feet 1050 Linear Feet 350

No Lines 5 Trench Width 36" Max Trench Bottom Depth 36" Gravel Depth 12"

☒ New System ☐ Repair System Type: I, II, ☒ III, IV, V, VI

System Description: Washington-D/B-Conv.

Repair System Description: Pressure Panel

Maintenance Agreement Required: ☐ Yes ☒ No

☒ House/Mod. Home ☐ Mobile Home ☐ Business ☐ Other

No. Bedrooms 3 No. Bathrooms 2 No. Employees


☐ Slab ☒ Crawl Space ☐ Basement w/plumbing ☐ Basement wo/plumbing

Water Supply: ☐ Individual ☐ Community ☐ Public


Comments: Reissue of original chg. permit

Comments:

**INITIAL SITE SKETCH**

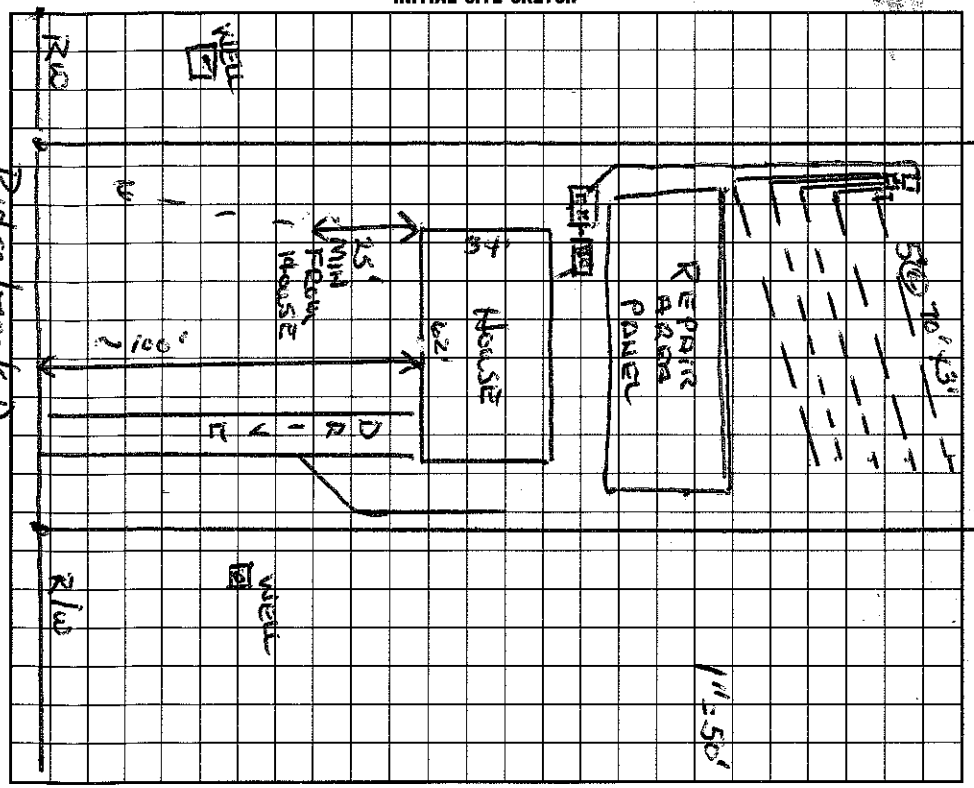


**AS BUILT SKETCH**

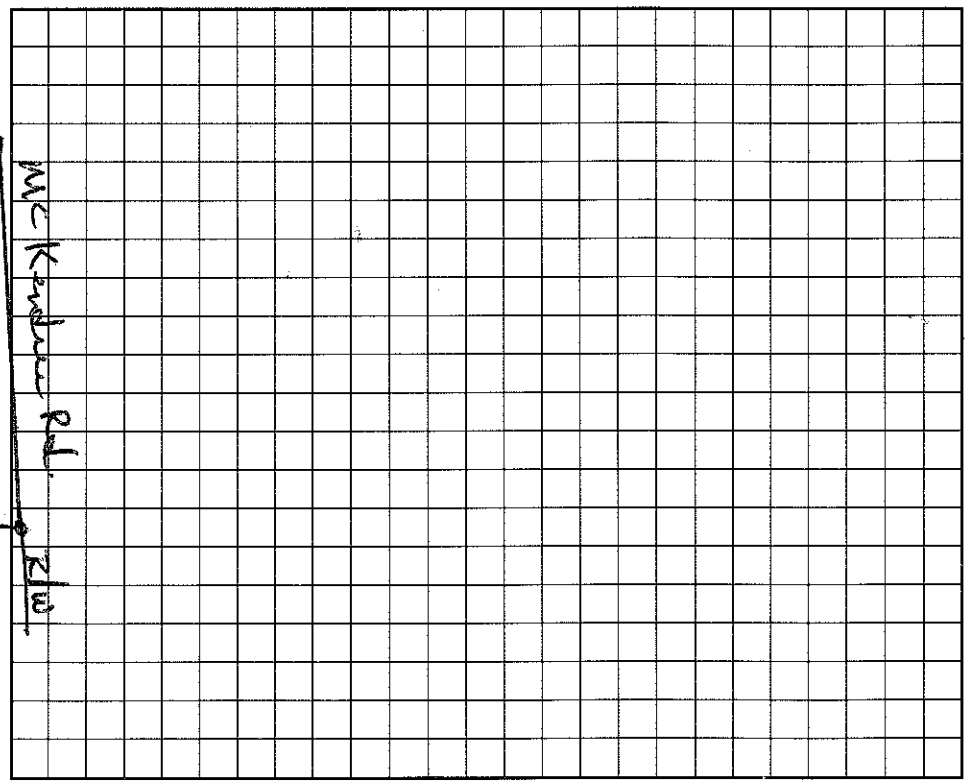


I understand that this permit can be suspended or revoked if any false information is supplied toward securing the permit/any unauthorized changes are made to the site/any unauthorized changes are made in the installation of the system. Improvement Permit is valid for 60 months from date of issuance.

Signed: Reissue Permit

Improvement Permit by: Wesley Sparks R.S. date 6/21/95

Existing System Inspection by: date

Installed by: Barry Thompson

Certificate of Completion by: date

Operation Permit by: Wesley Sparks R.S. date 8/8/96

HEALTH DEPT. COPY: WHITE INSPECTION COPY (FINAL): GREEN OWNER COPY (FINAL): YELLOW INSPECTION COPY (INITIAL): PINK OWNER COPY (INITIAL): GOLD