...ELL COUNTY HEALTH DEPARTMENT

STATESVILLE 704-878-5305 MOORESVILLE 704-664-5281

PIN# 4626-75-7669

IMPROVEMENT PERMIT / CERTIFICATE OF COMPLETION / OPERATION PERMIT / EXISTING SYSTEM INSPECTION

PROPERTY DESCRIPTION NO. 20508 DATE 3/16/95 TAX MAP NO. 2F-10-B-15 Watershed: ☐ Yes ☐ No

OWNER OR CONTRACTOR RSMB Enterprises PHONE: Business 6603-5592 Home

ADDRESS 1738 PO Box Mooresville NC 28115

LOCATION 1100 Lf on McIndree Rt on Carrie Lane, Lt at Corner of Carrie & Brookridge

SUBDIVISION Brookridge Shores BLOCK / SECTION 4 LOT 15 LOT AREA 127X251 SITE CLASS. PS DESIGN FLOW 360 L.T.A.R. ≈0.3

Septic Tank: 1000 Gallons; STB 744 Date 6/14/94

Pump Tank: Gallons; PT Date

Pump Make: Model Serial No.

Nitrification Field: No Fields 1 Square Feet 1200 Linear Feet 400

No Lines 3 or 4 Trench Width 3' Max Trench Bottom Depth 38" Gravel Depth 12

☑ New System ☐ Repair System Type: I, II, III, IV, V, VI

System Description: Conventional Gravity

Repair System Description: Conv/Pump PPBPS

Maintenance Agreement Required: ☑ Yes ☑ No

☑ House/Mod. Home No. Bedrooms 3

☐ Mobile Home No. Bathrooms 2

☐ Business No. Employees

☐ Other

☐ Slab ☑ Crawl Space ☐ Basement w/plumbing ☐ Basement wo/plumbing


Water Supply: ☑ Individual ☐ Community ☐ Public

To be Filled

Comments: House must not shift from area shown to maintain conventional. 4 Lines @ 100 ok if necessary

Comments:

INITIAL SITE SKETCH

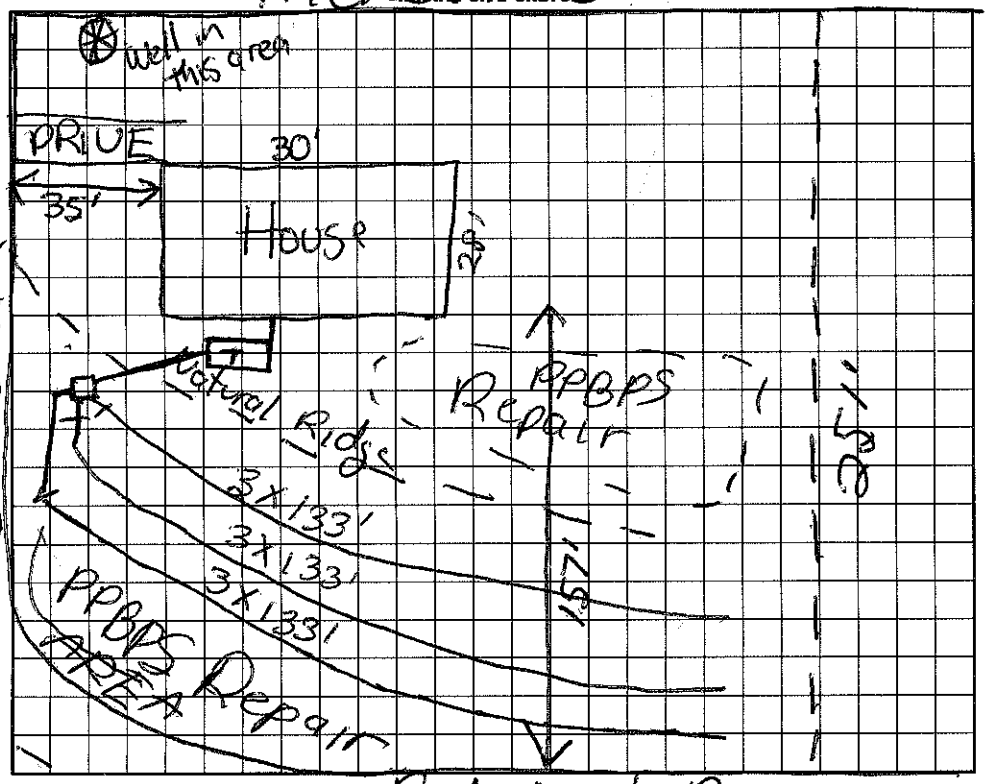

AS BUILT SKETCH

I understand that this permit can be suspended or revoked if any false information is supplied toward securing the permit/any unauthorized changes are made to the site/any unauthorized changes are made in the installation of the system. Improvement Permit is valid for 60 months from date of issuance.

Signed: Thomas A. Hoyer

Improvement Permit by: date 3/16/95

Existing System Inspection by: date

Installed by: Barry Thompson

Certificate of Completion by: Wesley Sparks R.S. date 8/7/95

Operation Permit by: date

HEALTH DEPT. COPY: WHITE INSPECTION COPY (FINAL): GREEN OWNER COPY (FINAL): YELLOW INSPECTION COPY (INITIAL): PINK OWNER COPY (INITIAL): GOLD