IREDELL COUNTY HEALTH DEPARTMENT

STATESVILLE 704-878-5305 MOORESVILLE 704-664-5281

IMPROVEMENT PERMIT / AUTHORIZATION TO CONSTRUCT / OPERATION PERMIT / EXISTING SYSTEM INSPECTION

PERMIT# 092446 PIN# ~~4626 38 74 80 PT~~ 4624-76-1161 DATE 9-25-00

OWNER OR CONTRACTOR EASTER DEVELOP. CORP / LEWIS CARPENTER PHONE: Business 664-2906 Home

ADDRESS 227 Hideaway Ln Mooresville NC 28117

LOCATION Brawley School, R McKendree ON LT

SUBDIVISION Blackberry Creek II BLOCK / SECTION II LOT 8 LOT AREA .70 Acres SITE CLASS. 65 DESIGN FLOW 360GPD L.T.A.R. .3gpd/ft =

Septic Tank: 1000 Gallons; STB 794 Date 5/9/02

Pump Tank: Gallons; PT Date

Pump Make: Model Serial No.

Nitrification Field: No Fields 1 Square Feet 1200 Linear Feet 400

No Lines 4@100' Trench Width 36" Max Trench Bottom Depth 36" Gravel Depth 12"

☒ New System ☐ Repair System Type: I, II, III, IV, V, VI

System Description: GRAVITY CONVENTIONAL

Repair System Description: PUMP 25% REDUCTION

Maintenance Agreement Required: ☐ Yes ☒ No

☒ House/Mod. Home No. Bedrooms 3

☐ Mobile Home No. Bathrooms 2½

☐ Business No. Employees

☐ Other


☐ Slab ☒ Crawl Space ☐ Basement w/plumbing ☐ Basement wo/plumbing

Water Supply: ☒ Individual ☐ Public ☐ Community

Comments:/Conditions: REMOVE TERRACES AND BERMS

Comments:/Conditions:

INITIAL SITE SKETCH 1"=50'

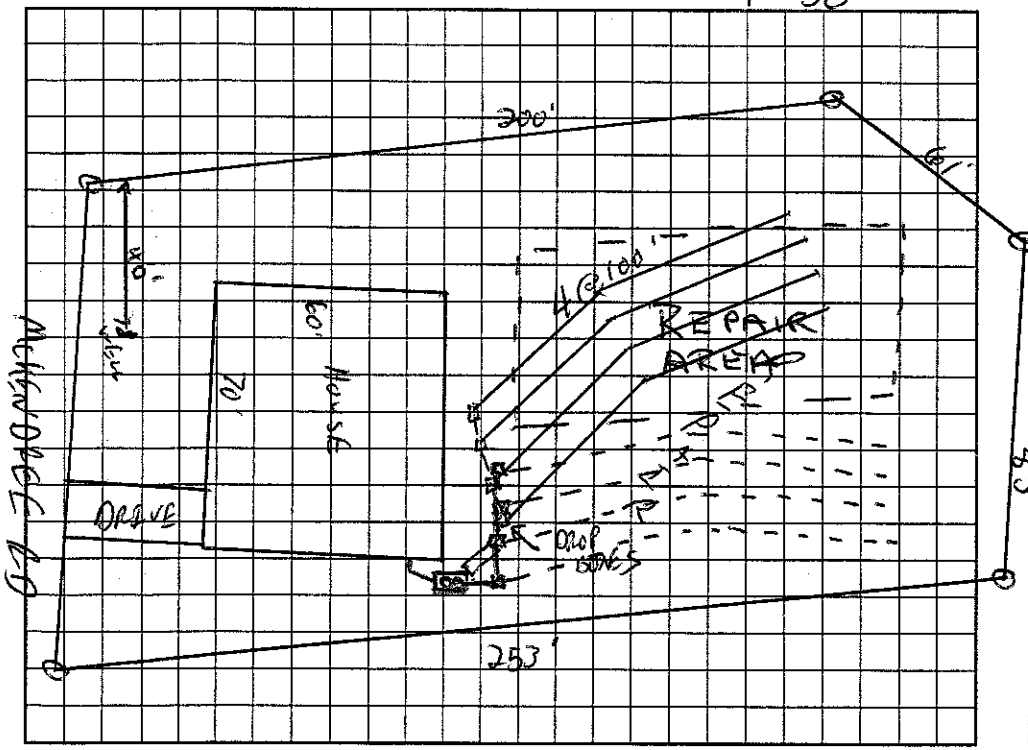

AS BUILT SKETCH

Permit can be suspended or revoked if any false information is supplied toward securing the permit/any unauthorized changes are made to the site/any unauthorized changes are made in the installation of the system. Improvement Permit with plat valid without expiration. Improvement Permit with site plan valid for sixty months. Authorization to Construct is valid for a period equal to that of Improvement Permit – not to exceed sixty months.

Signed: date 9-25-00 Installed by: Larry Beam

Improvement Permit by: CS date 11/8/00 Operation Permit by: Wesley Sparkes date 7/9/02

Authorization to Construct by: CS date 12/7/01 Existing System Inspection by: date

HEALTH DEPT. COPY: WHITE OWNER COPY (FINAL): YELLOW OWNER COPY (INITIAL): PINK