IREDELL COUNTY HEALTH DEPARTMENT

Authorization to Construct PIN# 4626-76-3041

STATESVILLE 704-878-5305 MOORESVILLE 704-664-5281

IMPROVEMENT PERMIT / CERTIFICATE OF COMPLETION / OPERATION PERMIT / EXISTING SYSTEM INSPECTION

PROPERTY DESCRIPTION NO. 22809 DATE 11/30/95 TAX MAP NO. 2F-10-B-11 Watershed: [X] Yes [ ] No

OWNER OR CONTRACTOR Glen Deuel PHONE: Business 528-3707 "Kim" Home

ADDRESS 75 S Clinton Avenue, NJ. 07001

LOCATION McKendree TR 1st Brookridge Dr to end, directly off cul de sac

SUBDIVISION Brookridge Sh BLOCK/ SECTION LOT 11 LOT AREA ~1.4AC SITE CLASS P5 DESIGN FLOW 360 L.T.A.R. .3

Septic Tank: 1000 Gallons; STB Date

Pump Tank: Gallons; PT Date

Pump Make: Model Serial No.

Nitrification Field: No Fields 1 Square Feet 1200 Linear Feet ~~300~~

No Lines 4 Trench Width 36" Max Trench Bottom Depth 36" Gravel Depth 6" SAND

[X] New System [ ] Repair System Type: I, II, (III), IV, V, VI

System Description: GRAVITY INFILTRATOR

Repair System Description: ~~GRAVITY~~ PRESSURE INFILTRATOR

Maintenance Agreement Required: [ ] Yes [X] No

[X] House/Mod. Home No. Bedrooms 3

[ ] Mobile Home No. Bathrooms 2.5

[ ] Business No. Employees

[ ] Other

[ ] Slab [X] Crawl Space [ ] Basement w/plumbing [ ] Basement wo/plumbing


Water Supply: [X] Individual [ ] Community [ ] Public

Comments:


Attempting to use cleared area
Plumbing must be held high to avoid necessity of pumping to drainfield.

Comments:

INITIAL SITE SKETCH

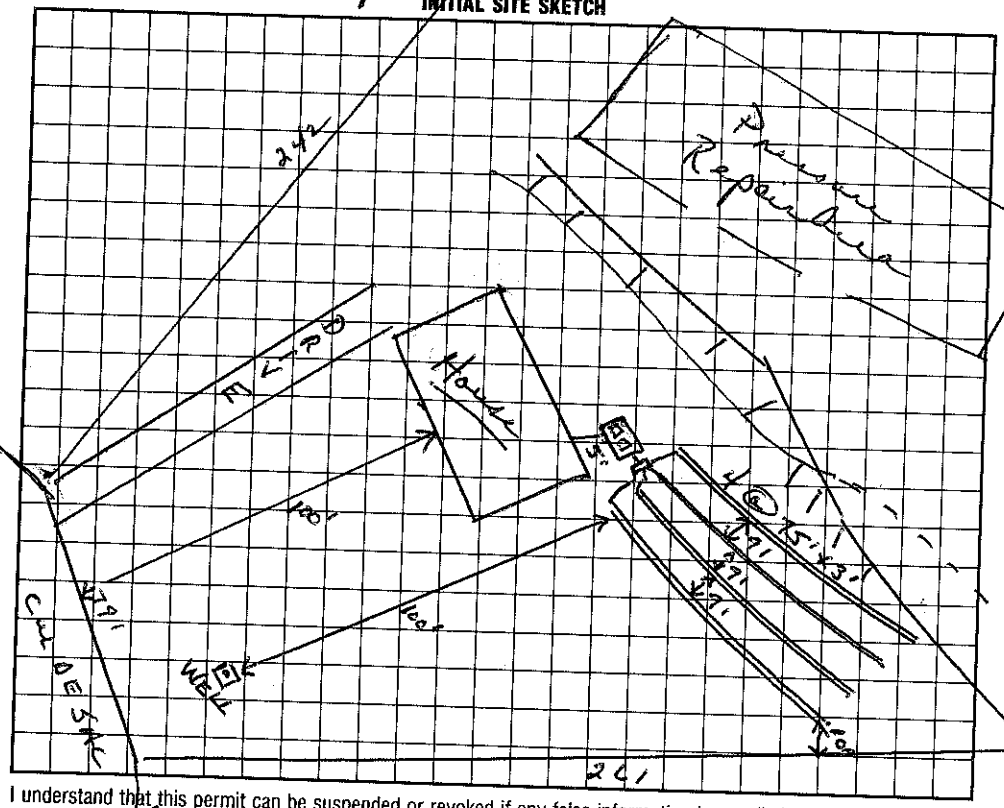

AS BUILT SKETCH

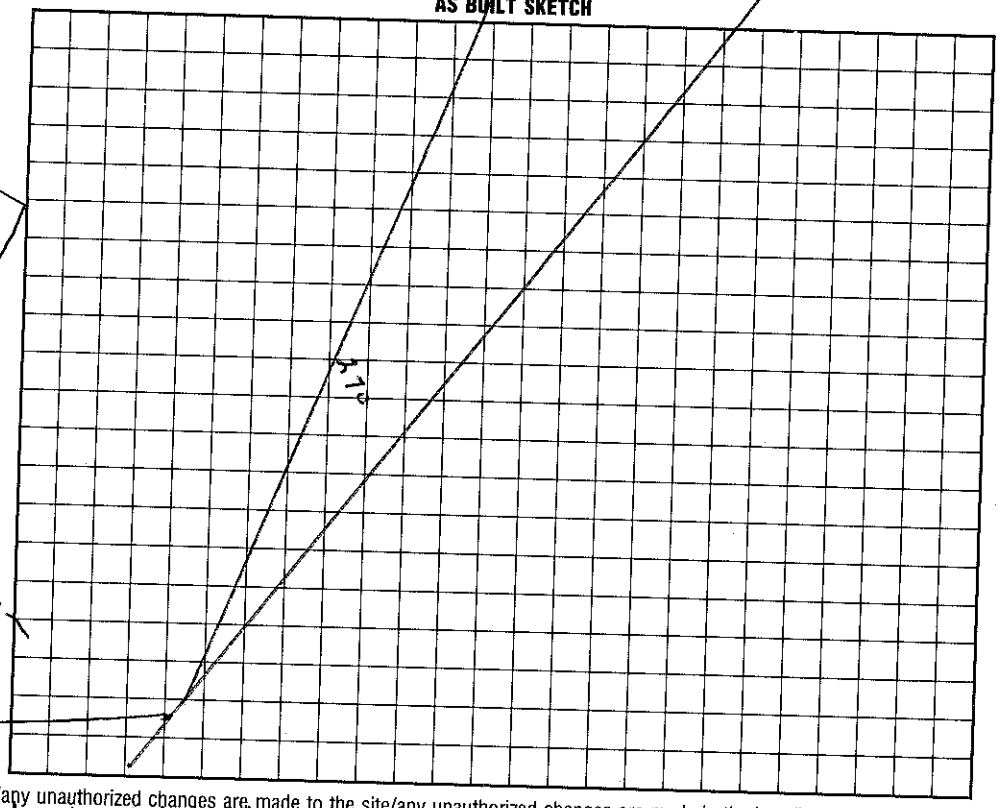

I understand that this permit can be suspended or revoked if any false information is supplied toward securing the permit/any unauthorized changes are made to the site/any unauthorized changes are made in the installation of the system.

Signed: X Authorization to Construct valid 5 years. Chng. Permit indefinite validity.

Improvement Permit by: Wesley Sparks RS. date 11/30/95

Existing System Inspection by: Authorization to Construct: Wesley Sparks RS. date 11/30/95

Installed by: Larry Baldwin

Certificate of Completion by: date

Operation Permit by: Wesley Sparks RS. date 4/4/96

HEALTH DEPT. COPY: WHITE INSPECTION COPY (FINAL): GREEN OWNER COPY (FINAL): YELLOW INSPECTION COPY (INITIAL): PINK OWNER COPY (INITIAL): GOLD