IREDELL COUNTY HEALTH DEPARTMENT

STATESVILLE 704-878-5305 MOORESVILLE 704-664-5281

IMPROVEMENT PERMIT / AUTHORIZATION TO CONSTRUCT / OPERATION PERMIT / EXISTING SYSTEM INSPECTION

PERMIT# 116069 PIN# 4626-78-3850 DATE 10/13/03

OWNER OR CONTRACTOR Jason Basinger PHONE: Business _____ Home 704 677-3750

ADDRESS 129 Hileath Dr. Mooresville NC 28117

LOCATION BSR, TR Blum TL Beachtree TR Kings Cross, TL Hileath at End on Lt

SUBDIVISION CLT BLOCK / SECTION 8 LOT 1568 LOT AREA 1.467 ac SITE CLASS. P5 DESIGN FLOW 360 L.T.A.R. —

Septic Tank: 1000 Existing Gallons; STB _____ Date _____

Pump Tank: _____ Gallons; PT _____ Date _____

Pump Make: _____ Model _____ Serial No. _____

Nitrification Field: No Fields 1 Square Feet 720 Linear Feet 240

No Lines 5 Trench Width EX Max Trench Bottom Depth _____ Gravel Depth 12"

☐ New System ☐ Repair System Type: I, (II), III, IV, V, VI

System Description: Existing Conventional

Repair System Description: _____

Maintenance Agreement Required: ☐ Yes ☒ No

☒ House/Mod. Home No. Bedrooms 3

☐ Mobile Home No. Bathrooms 3

☐ Business No. Employees ____

☐ Other _____


☐ Slab ☐ Crawl Space ☒ Basement w/plumbing ☐ Basement wo/plumbing

Water Supply:
☒ Individual
☐ Public
☐ Community
Existing


Comments:/Conditions:

Comments:/Conditions: Original permit — John Casanova - 1985

INITIAL SITE SKETCH

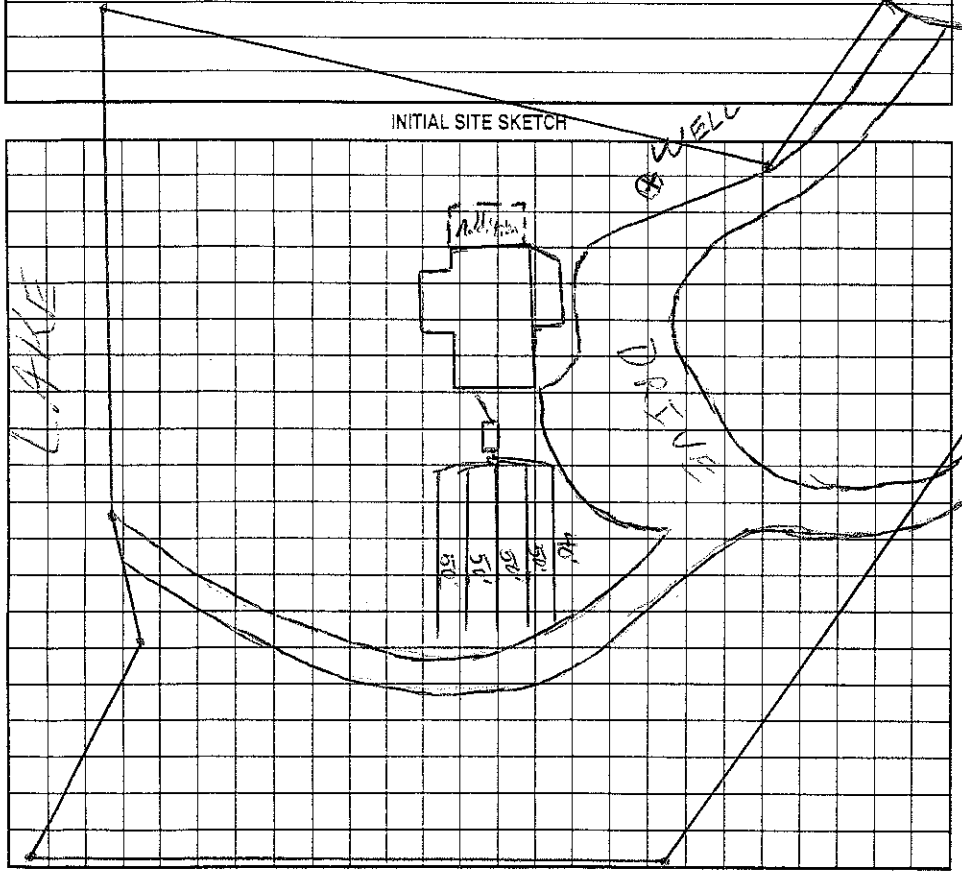

AS BUILT SKETCH

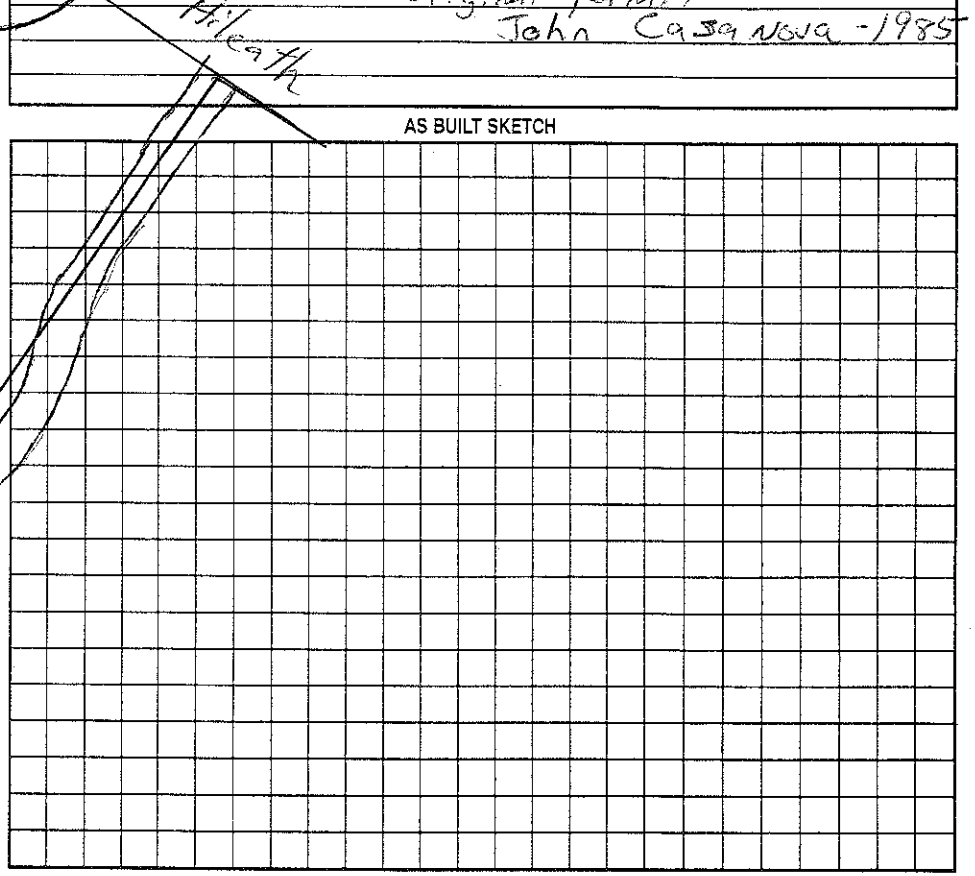

Permit can be suspended or revoked if any false information is supplied toward securing the permit/any unauthorized changes are made to the site/any unauthorized changes are made in the installation of the system. Improvement Permit with plat valid without expiration. Improvement Permit with site plan valid for sixty months. Authorization to Construct is valid for a period equal to that of Improvement Permit – not to exceed sixty months.

Signed: Jason Basinger date 10/13/03 Installed by: _____

Improvement Permit by: _____ date _____ Operation Permit by: _____ RS date 10/13/03

Authorization to Construct by: _____ date _____ Existing System Inspection by: _____ RS date 10/13/03

HEALTH DEPT. COPY: WHITE OWNER COPY (FINAL): YELLOW OWNER COPY (INITIAL): PINK