IREDELL COUNTY HEALTH DEPARTMENT

AUTHORIZATION TO CONSTRUCT

STATESVILLE 704-878-5305 MOORESVILLE 704-664-5281

IMPROVEMENT PERMIT / ~~CERTIFICATE OF COMPLETION~~ / OPERATION PERMIT / EXISTING SYSTEM INSPECTION

PROPERTY DESCRIPTION NO. 26177 DATE 2/27/97 TAX MAP NO. 4626790188 · 2L-2-A-503 Watershed: ☑ Yes ☐ No

OWNER OR CONTRACTOR WALTER MILES PHONE: Business _____ Home 366-6251

ADDRESS 126 HILEATH CT. MOORESVILLE NC 28115

LOCATION BEANLEY SCHOOL RD - TR BEECHTREE - TR KENES CROSS - TL HILEATH, 2ND DRIVE ON (R)

SUBDIVISION CLAT — BLOCK / SECTION B LOT 503 LOT AREA .98 AC. SITE CLASS. PS DESIGN FLOW 360 GPD L.T.A.R. .3 GPD/FT2

Septic Tank: EXISTING Gallons; STB _____ Date _____

Pump Tank: _____ Gallons; PT _____ Date _____

Pump Make: _____ Model _____ Serial No. _____

Nitrification Field: No Fields 1 Square Feet 300 Linear Feet 100

No Lines 1@100' Trench Width 36" Max Trench Bottom Depth 36" Gravel Depth 12"

☑ New System ☐ Repair System Type: I, (II), III, IV, V, VI

System Description: GRAVITY CONVENTIONAL

Repair System Description: SOME CONV. REPAIR

Maintenance Agreement Required: ☐ Yes ☑ No

☑ House/Mod. Home No. Bedrooms 3

☐ Mobile Home No. Bathrooms 2

☐ Business No. Employees ____

☐ Other _____


☐ Slab ☑ Crawl Space ☐ Basement w/plumbing ☐ Basement wo/plumbing

Water Supply:
☑ Individual
☐ Community
☐ Public

Comments: KEEP 50' FROM LAKE - ADD ADDITIONAL 100' LINE AND FLOW DEVIDER.

Comments:

INITIAL SITE SKETCH

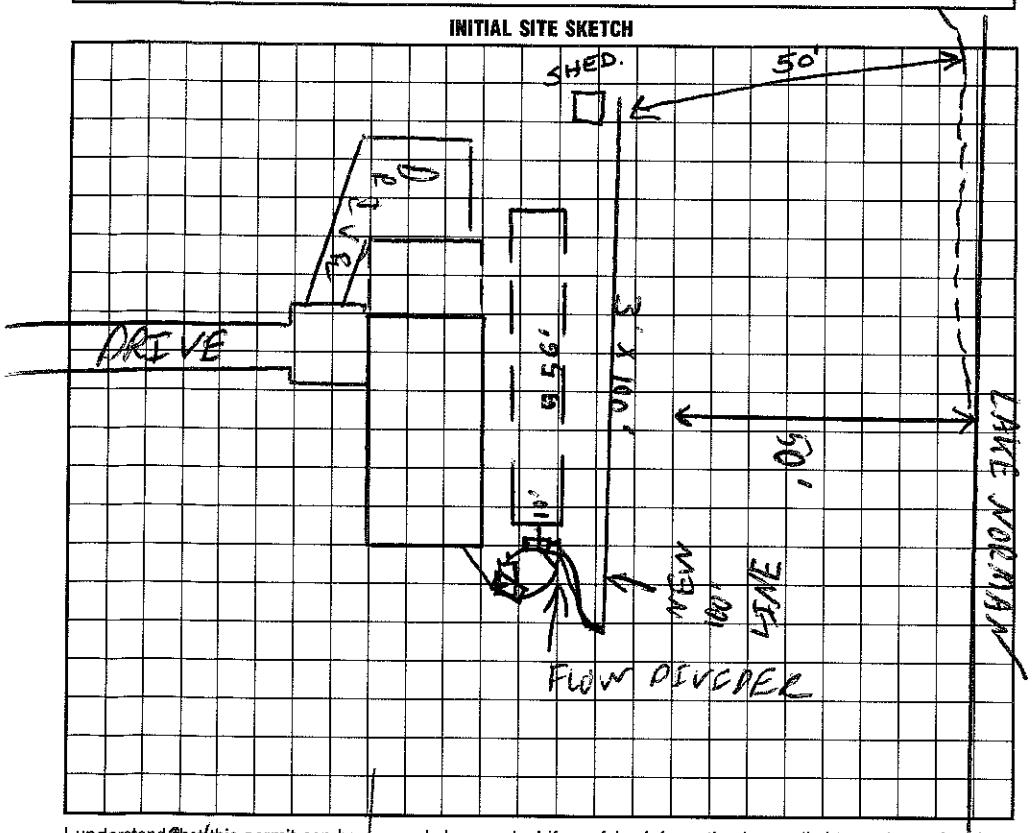

AS BUILT SKETCH

I understand that this permit can be suspended or revoked if any false information is supplied toward securing the permit/any unauthorized changes are made to the site/any unauthorized changes are made in the installation of the system. Improvement Permit is valid for 60 months from date of issuance.

Signed: _____

Improvement Permit by: C. Ruby Freeman date 2/27/97

Existing System Inspection by: C. Ruby Freeman date 2/24/97

Installed by: Mayhew Septic Tank.

Certificate of Completion by: Wesley Sparks RS. date 9/19/97

Operation Permit by: Wesley Sparks RS date 9/19/97

HEALTH DEPT. COPY: WHITE INSPECTION COPY (FINAL): GREEN OWNER COPY (FINAL): YELLOW INSPECTION COPY (INITIAL): PINK OWNER COPY (INITIAL): GOLD