IREDELL COUNTY HEALTH DEPARTMENT

STATESVILLE 704-878-5305 4626791583 MOORESVILLE 704-664-5281

IMPROVEMENT PERMIT / CERTIFICATE OF COMPLETION / OPERATION PERMIT / EXISTING SYSTEM INSPECTION

PROPERTY DESCRIPTION NO. _____ DATE June 29, 94 TAX MAP NO. _____ Watershed: ☑ Yes ☐ No

OWNER OR CONTRACTOR Richard Hartness PHONE: Business _____ Home _____

ADDRESS 4508 Columbine Ct. Charlotte 28226

LOCATION 77 to I-77 (Statesville) ~~FL~~ immediately onto Beechtree TR Rings X Lane TL 2nd gravel road, at end

SUBDIVISION Crescent LM BLOCK / SECTION B LOT 5No LOT AREA _____ SITE CLASS. _____ DESIGN FLOW _____ L.T.A.R. _____

Septic Tank: ~~Existing~~ Gallons; STB _____ Date _____

Pump Tank: _____ Gallons; PT _____ Date _____

Pump Make: _____ Model _____ Serial No. _____

Nitrification Field: No Fields ~~16~~ Square Feet 600 Linear Feet ~~200~~ 160

No Lines 3 Trench Width 36" Max Trench Bottom Depth 24" Gravel Depth 12"

☐ New System ☑ Repair System Type: I, II, III, IV, V, VI

System Description: gravity fed

Repair System Description: grave conventional

Maintenance Agreement Required: ☐ Yes ☑ No

☑ House/Mod. Home No. Bedrooms 3

☐ Mobile Home No. Bathrooms 1-2

☐ Business No. Employees _____

☐ Other _____


☐ Slab ☑ Crawl Space ☐ Basement w/plumbing ☐ Basement wo/plumbing

Water Supply: ☑ Individual ☐ Community ☐ Public


Comments:

Comments: upper lines short approx 40' due to existing drainfield location (Cut old line & had to stop)

INITIAL SITE SKETCH

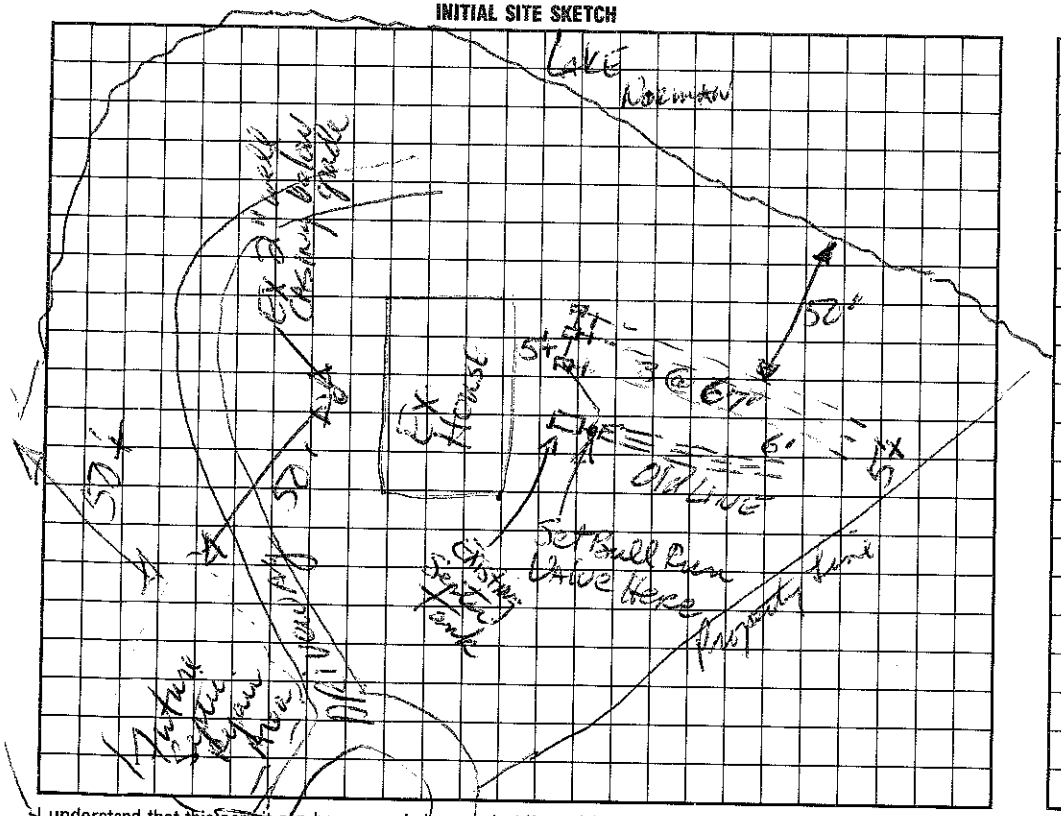

AS BUILT SKETCH

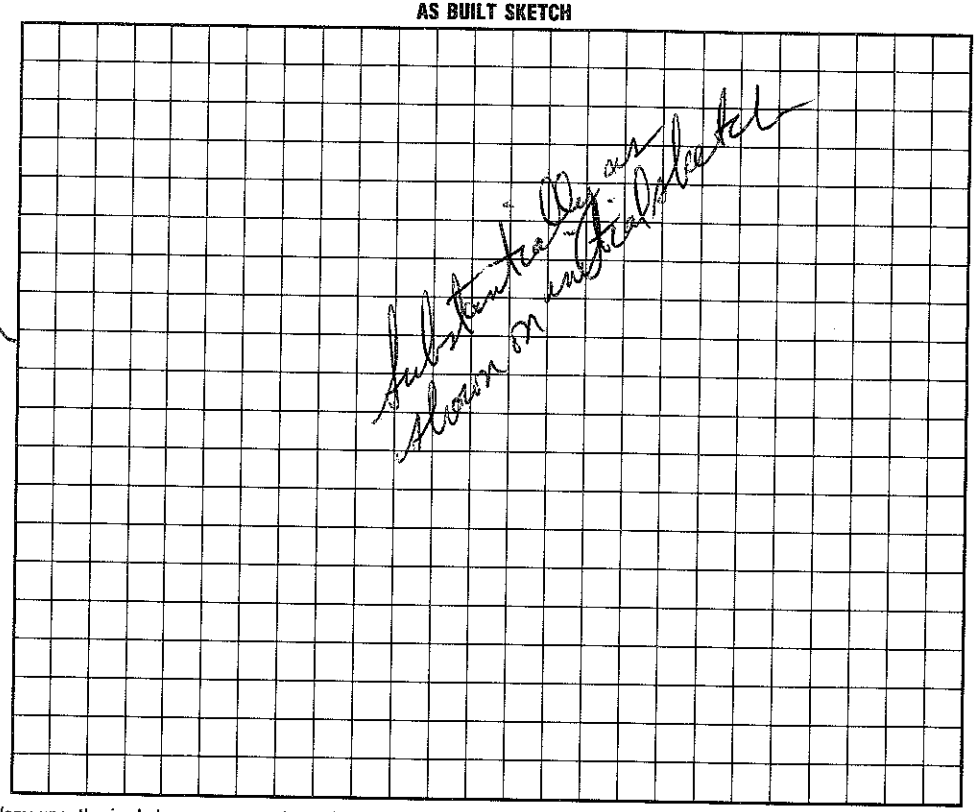

I understand that this permit can be suspended or revoked if any false information is supplied toward securing the permit/any unauthorized changes are made to the site/any unauthorized changes are made in the installation of the system. Improvement Permit is valid for 60 months from date of issuance.

Signed: _____

Improvement Permit by: Jane D. Hinson, RS date 6/20/94

Existing System Inspection by: _____ date _____

Installed by: Tim Simmons

Certificate of Completion by: D. Hinson, RS date 8/29/94

Operation Permit by: _____ date _____

HEALTH DEPT. COPY: WHITE INSPECTION COPY (FINAL): GREEN OWNER COPY (FINAL): YELLOW INSPECTION COPY (INITIAL): PINK OWNER COPY (INITIAL): GOLD